

SURVEY IN  
**SECTION 18, T.24 S., R.1 W., W.M.**

Surveyed for: **WINCHESTER PLYWOOD COMPANY**  
Surveyed by: **BRYANT ENGINEERING & SURVEYING**

NOVEMBER 1969

Scale: 1" = 60'


COUNTY SURVEYORS FILE DATA  
SECTION 18, T.24 S., R.1 W., W.M.

FILED  
RECORDED

NOV 11 1969

COUNTY SURVEYOR  
SHERMAN COUNTY, IOWA

M 38 - 63

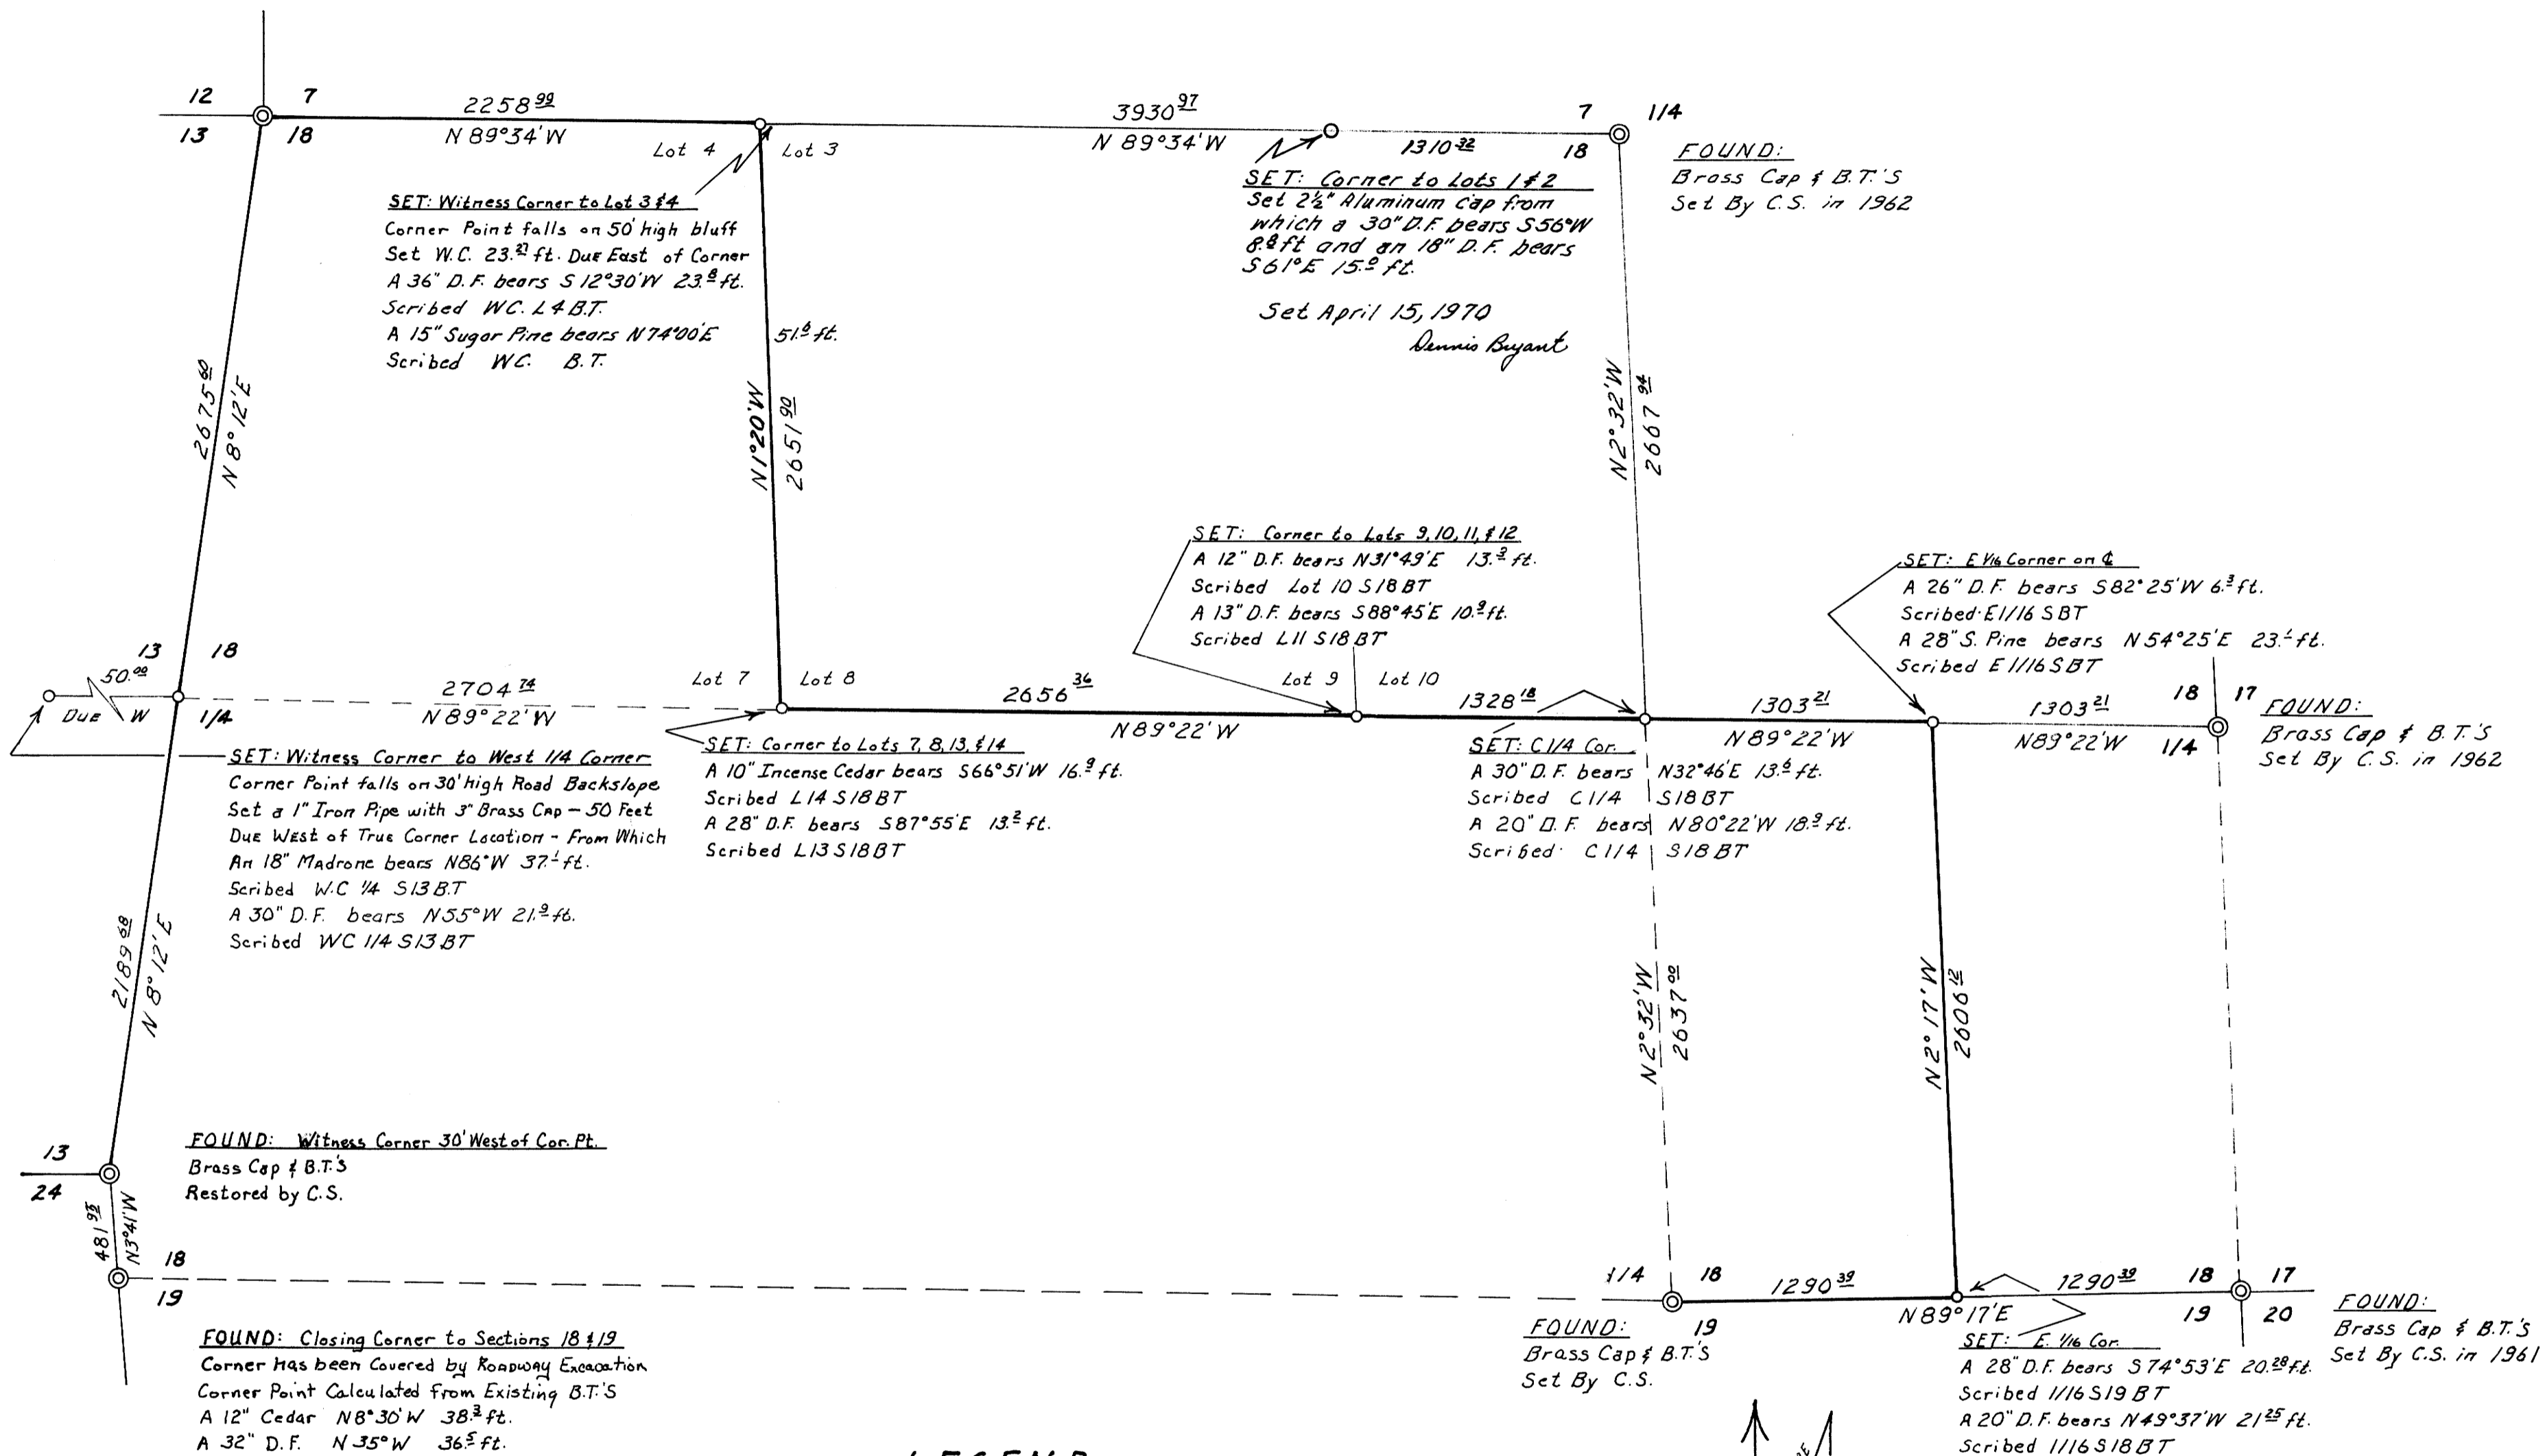

**LEGEND**

- CORNER SET  
(Set 3/8" Iron Rod with Aluminum Cap)  
(Unless otherwise noted.)
- ⊙ CORNER FOUND
- LINE RUN
- - - LINE CALCULATED
- LINE RUN & BLAZED

