


COUNTY SURVEYORS FILE DATA
DO NOT REMOVE FROM OFFICE

KIWANIS SCHOOL FOREST

BRITT NICHOLS COUNTY PARK

N1/2 NW1/4 & SW1/4 NW1/4,
SEC. 4 TWP 27 S, RGE 7 W, W.M.

SCALE: 1" = 220'

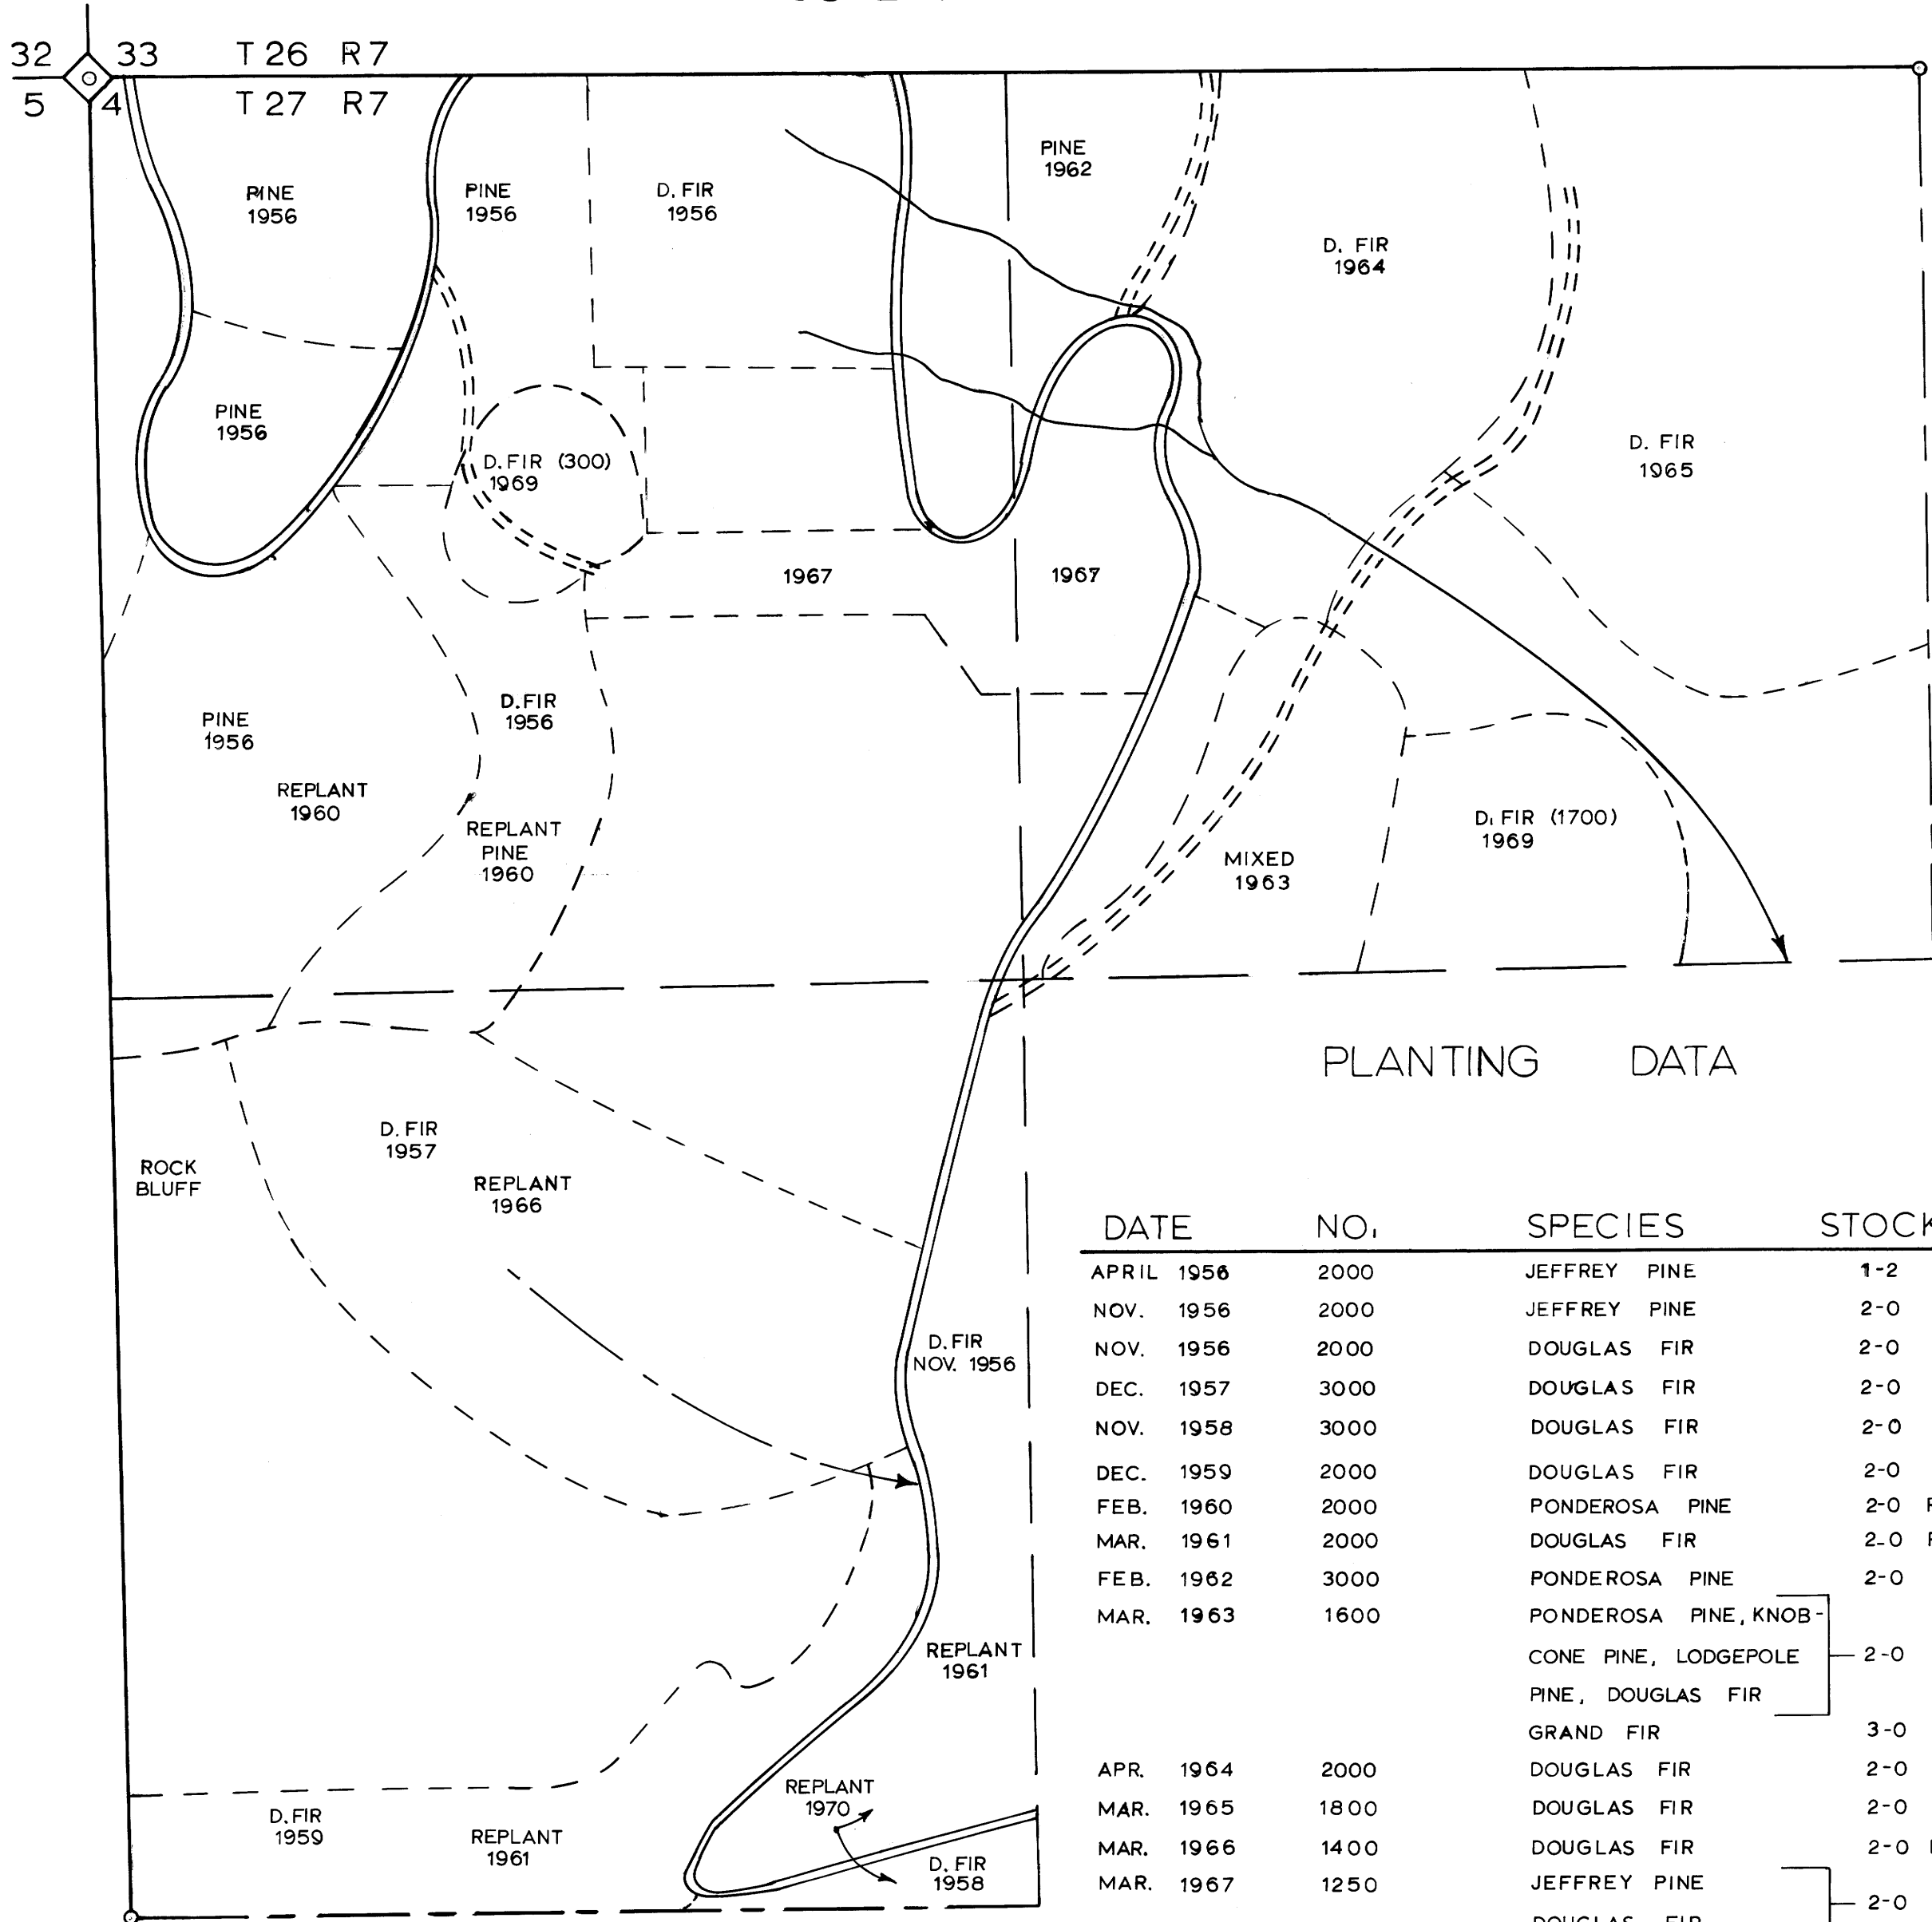

PLANTING DATA

DATE	NO.	SPECIES	STOCK
APRIL 1956	2000	JEFFREY PINE	1-2
NOV. 1956	2000	JEFFREY PINE	2-0
NOV. 1956	2000	DOUGLAS FIR	2-0
DEC. 1957	3000	DOUGLAS FIR	2-0
NOV. 1958	3000	DOUGLAS FIR	2-0
DEC. 1959	2000	DOUGLAS FIR	2-0
FEB. 1960	2000	PONDEROSA PINE	2-0 REPLANT
MAR. 1961	2000	DOUGLAS FIR	2-0 REPLANT
FEB. 1962	3000	PONDEROSA PINE	2-0
MAR. 1963	1600	PONDEROSA PINE, KNOB- CONE PINE, LODGEPOLE PINE, DOUGLAS FIR	2-0
		GRAND FIR	3-0
APR. 1964	2000	DOUGLAS FIR	2-0
MAR. 1965	1800	DOUGLAS FIR	2-0
MAR. 1966	1400	DOUGLAS FIR	2-0 REPLANT
MAR. 1967	1250	JEFFREY PINE	2-0
		DOUGLAS FIR	
APR. 1969	2000	DOUGLAS FIR	2-0
APR. 1970	1000	DOUGLAS FIR	2-0 REPLANT