


FIELD  
RECORD

# SURVEY TO SET PROPERTY CORNERS IN SEC. 14, T 27 S, R 6 W. W. M. ROSEBURG, ORE.

SURVEYED FOR - DOW KEASY  
SURVEYED BY - W.S. BARNES

MAR. 1970  
SCALE 1" = 50'

**COUNTY SURVEYORS FILE DATA  
DO NOT REMOVE FROM OFFICE**

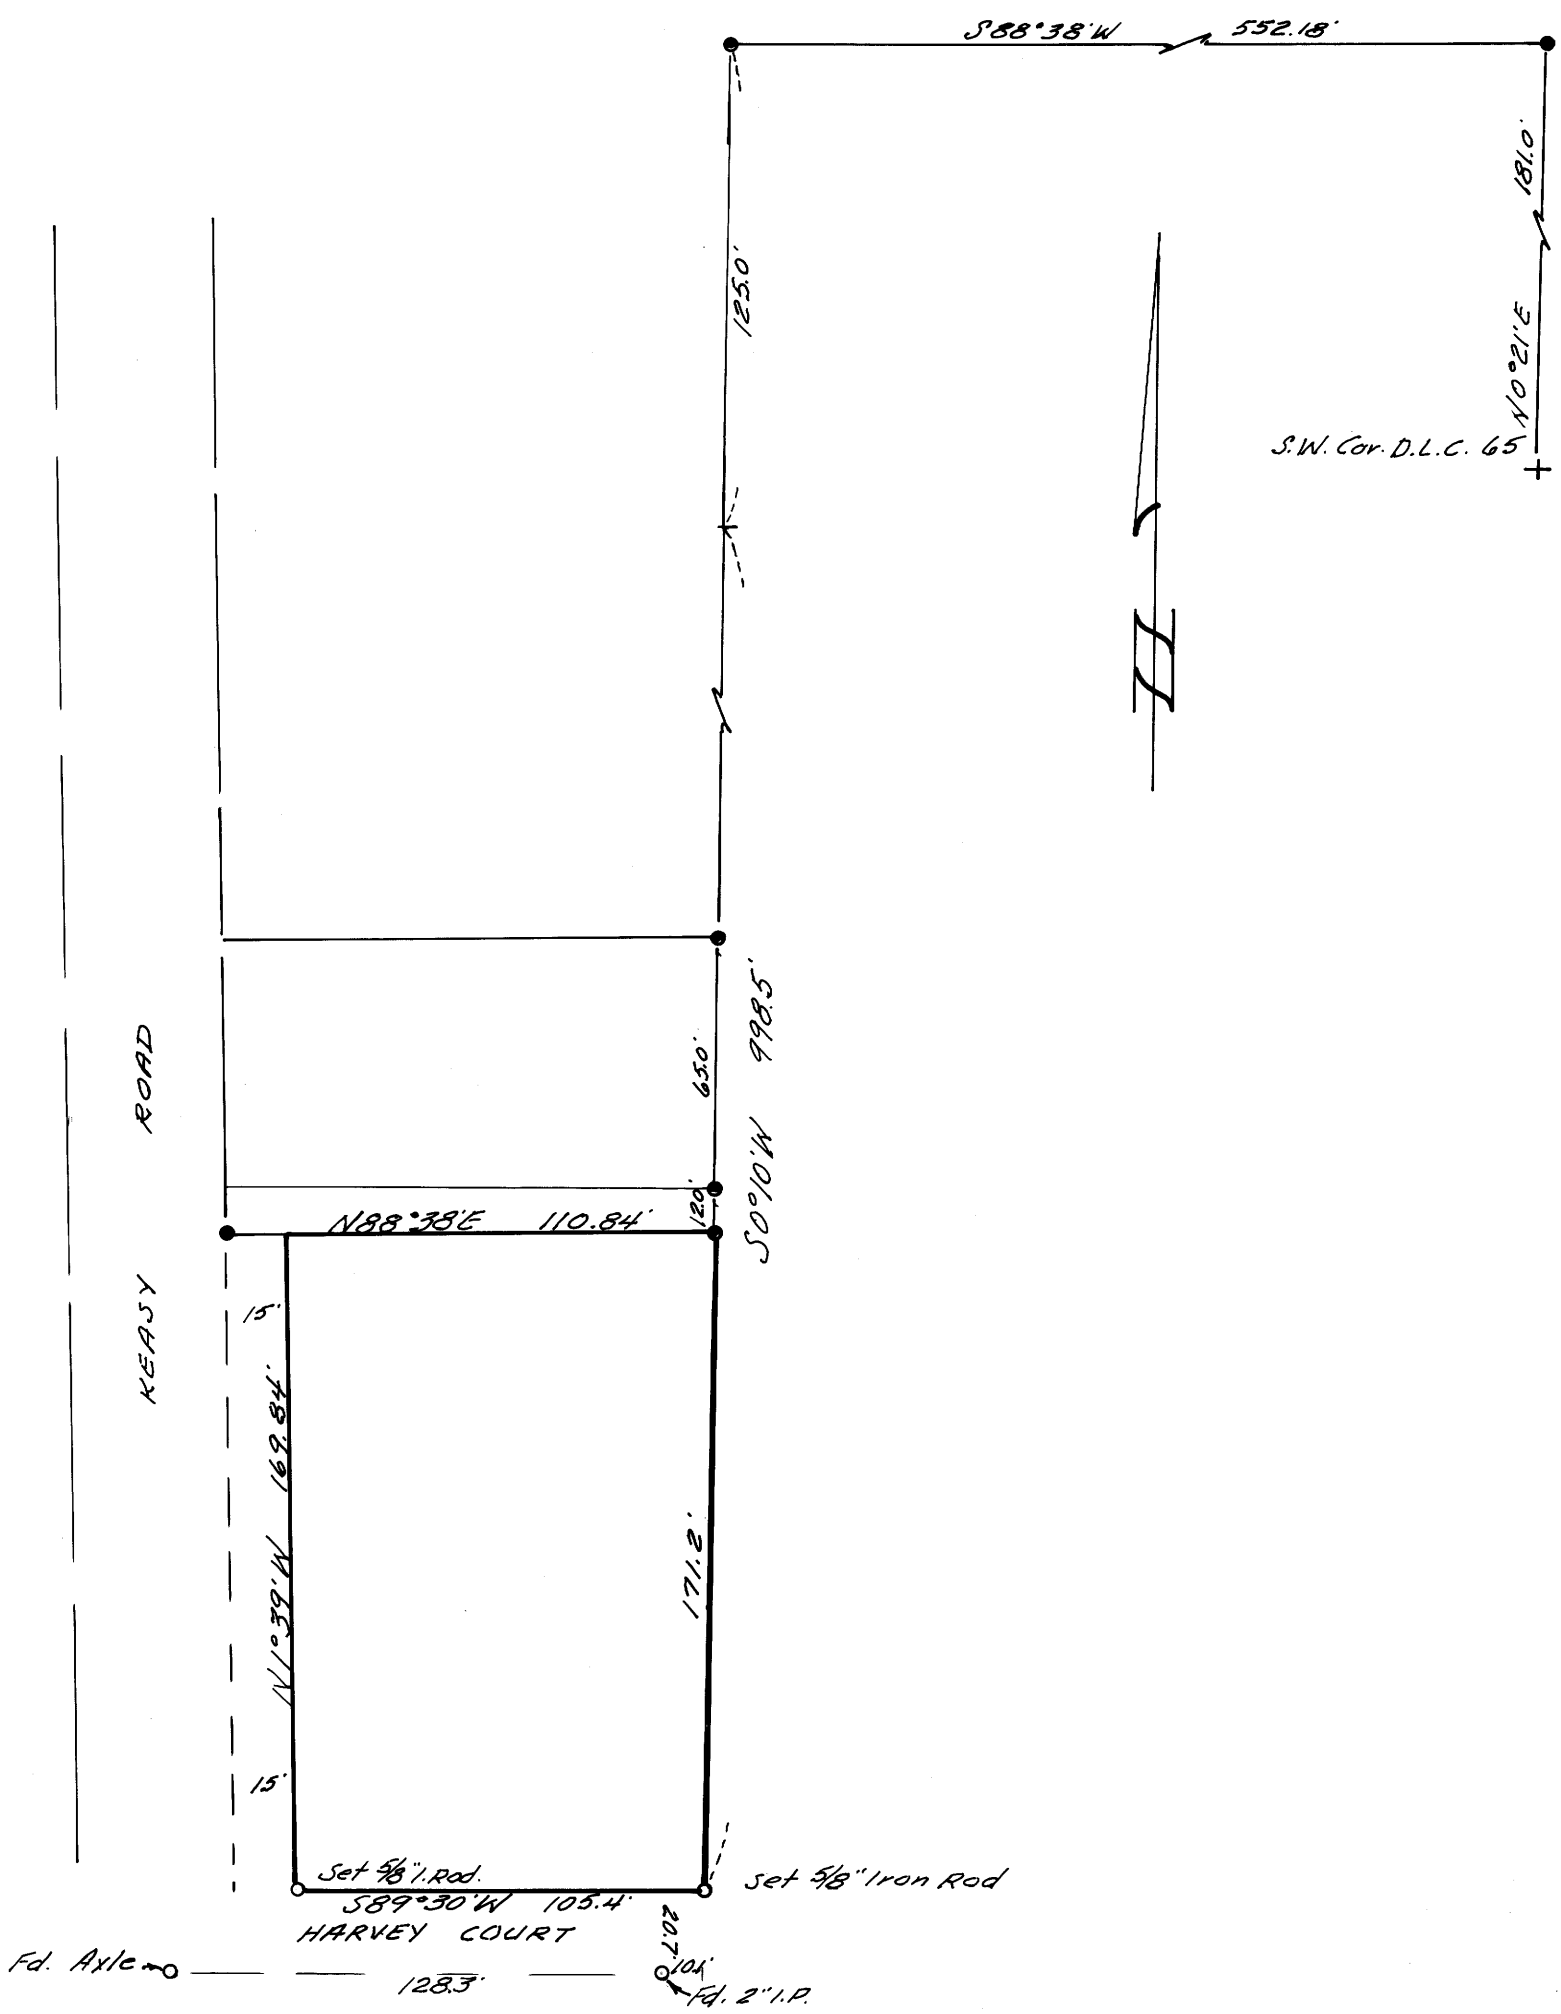

- Monuments found.

Base bearing taken from Deed Record.  
 Note: Survey based on Deed Record Vol. 127. Pg. 170.  
 Refr. - C.S. File 51-285 and M7-56.

