

COUNTY SURVEYORS FILE
DO NOT REMOVE FROM OFFICE


SURVEY FOR DEED DESCRIPTIONS
IN SECTION 16, T 24 S, R 7 W. W.M.

SURVEYED FOR - DOUG BROWNSON
SURVEYED BY - W.S. BARNES.


MAR. 1970
SCALE 1"=100'

SB

M 39-50

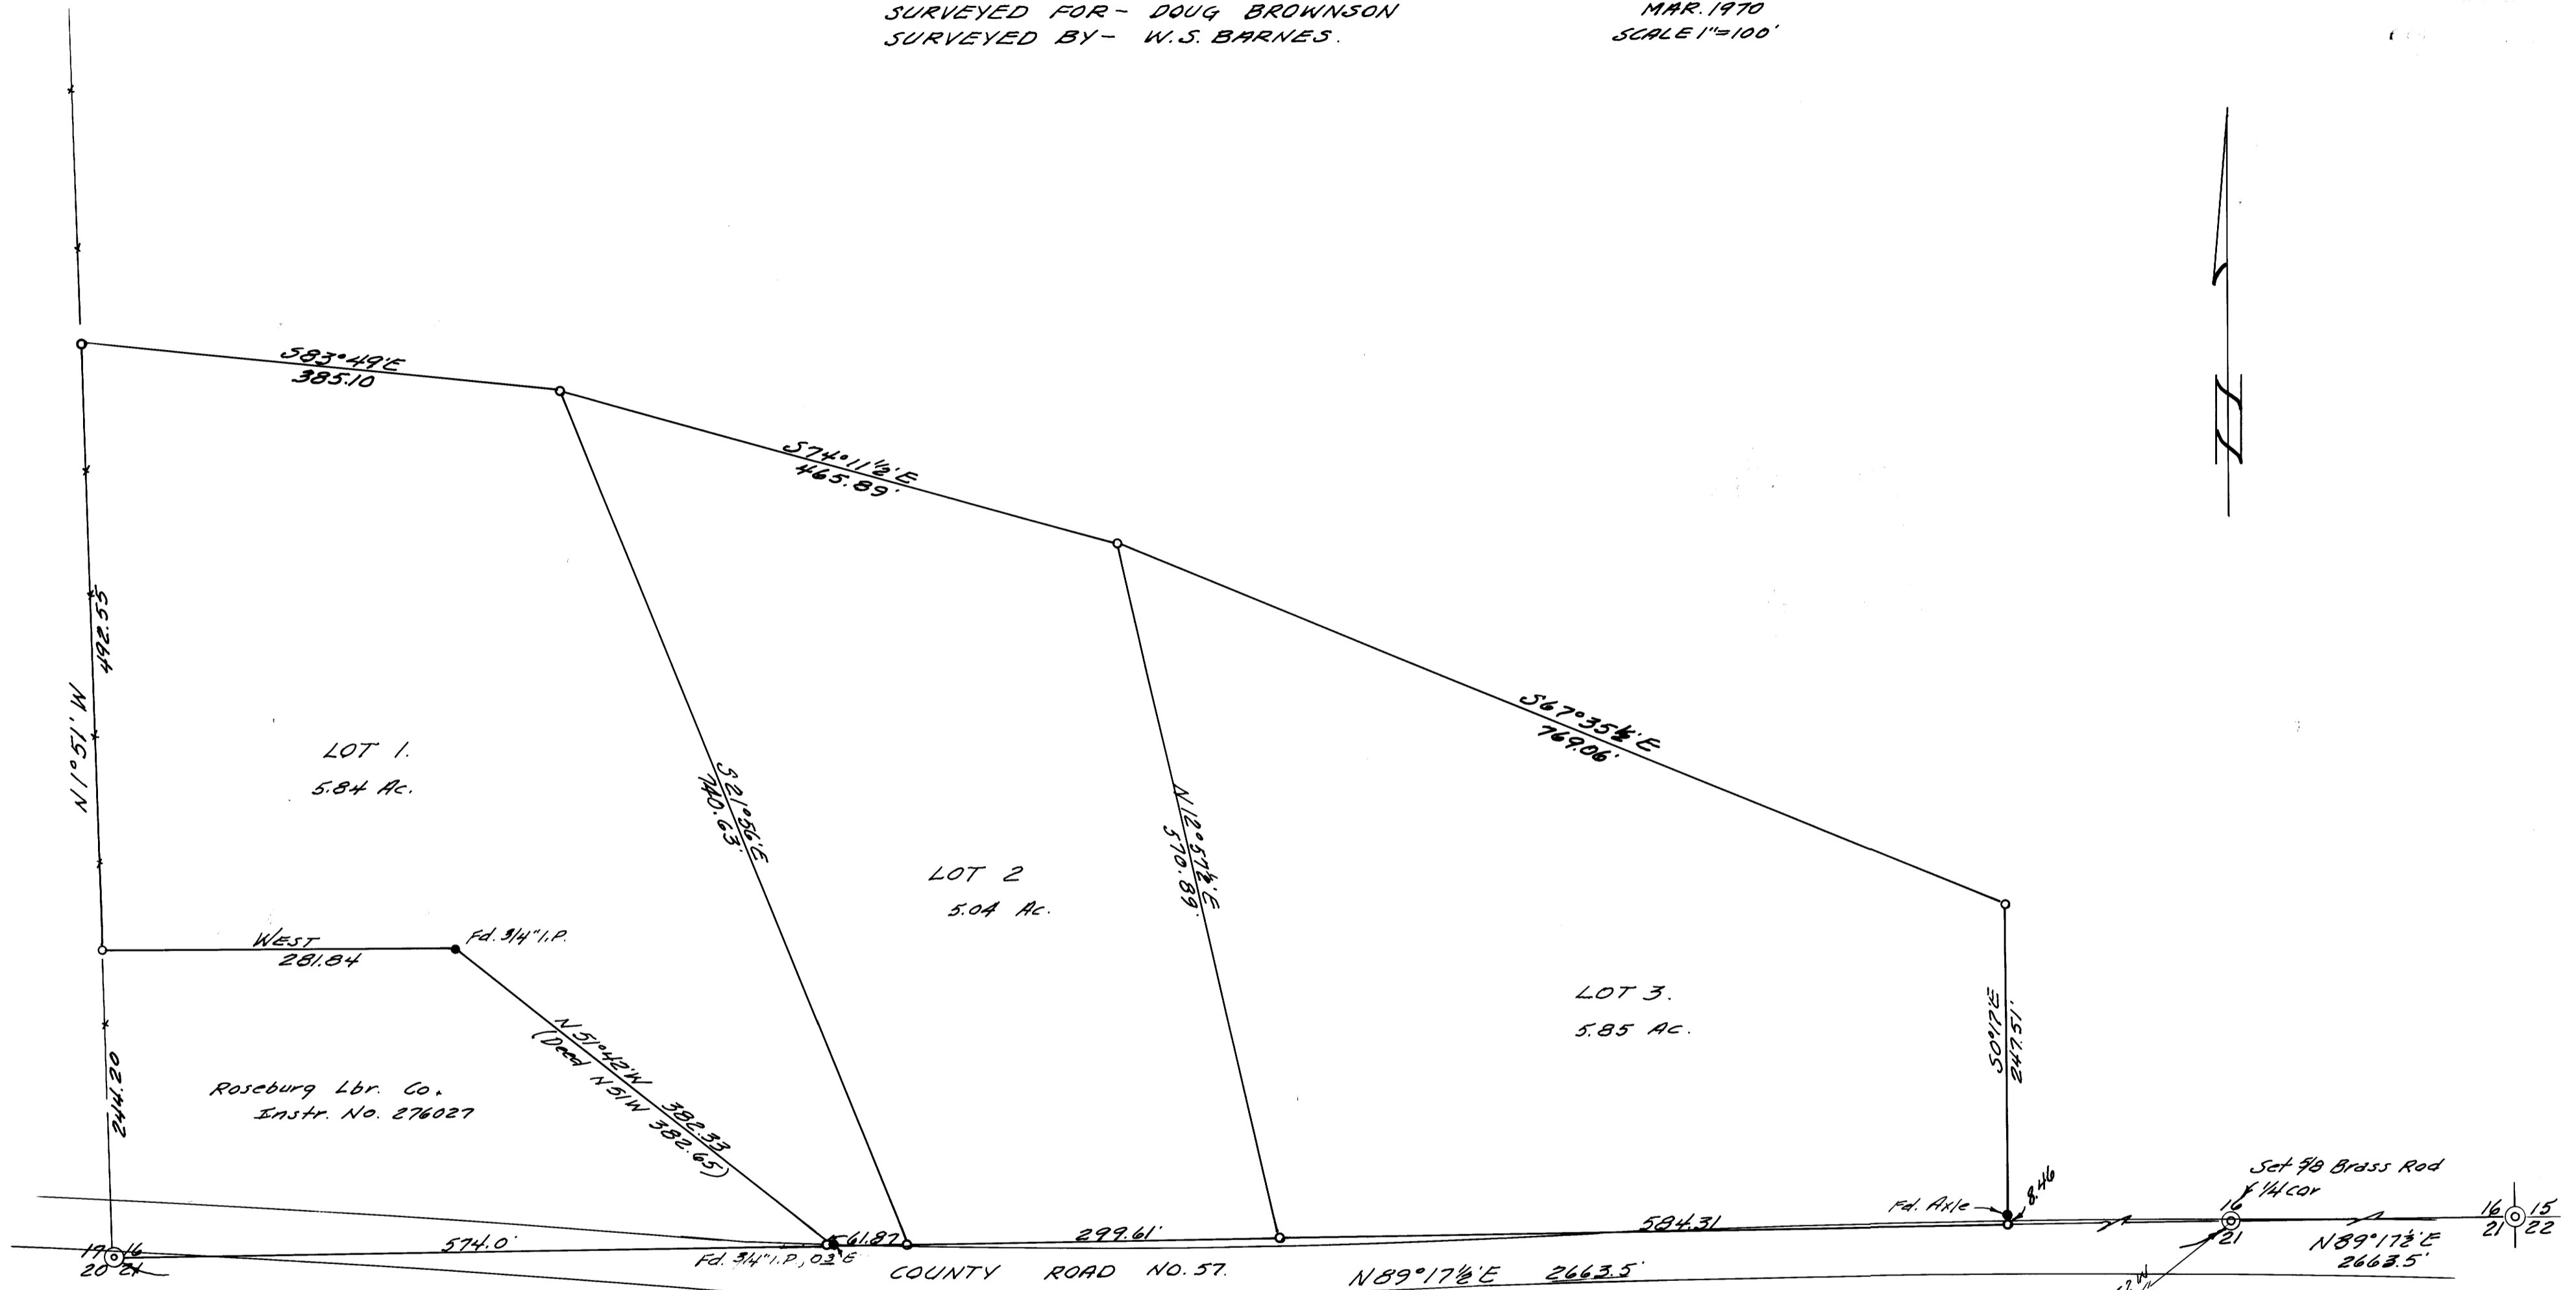

- 3/8" iron rods set
- Monuments found
- Base bearing taken from south line of sec. 16.
- Refr. M 39-51

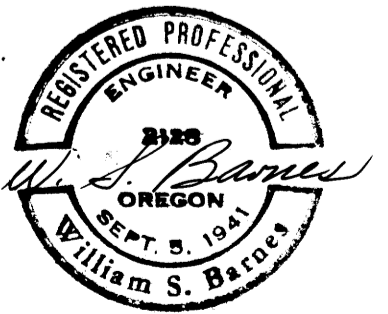

M 39-50