
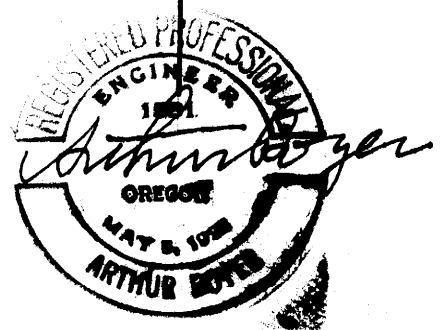


FILED
 RECEIVED
 MAY 4 1970
 COUNTY SURVEYOR
 DOUGLAS COUNTY, ORE.

MAP FILE N39-57

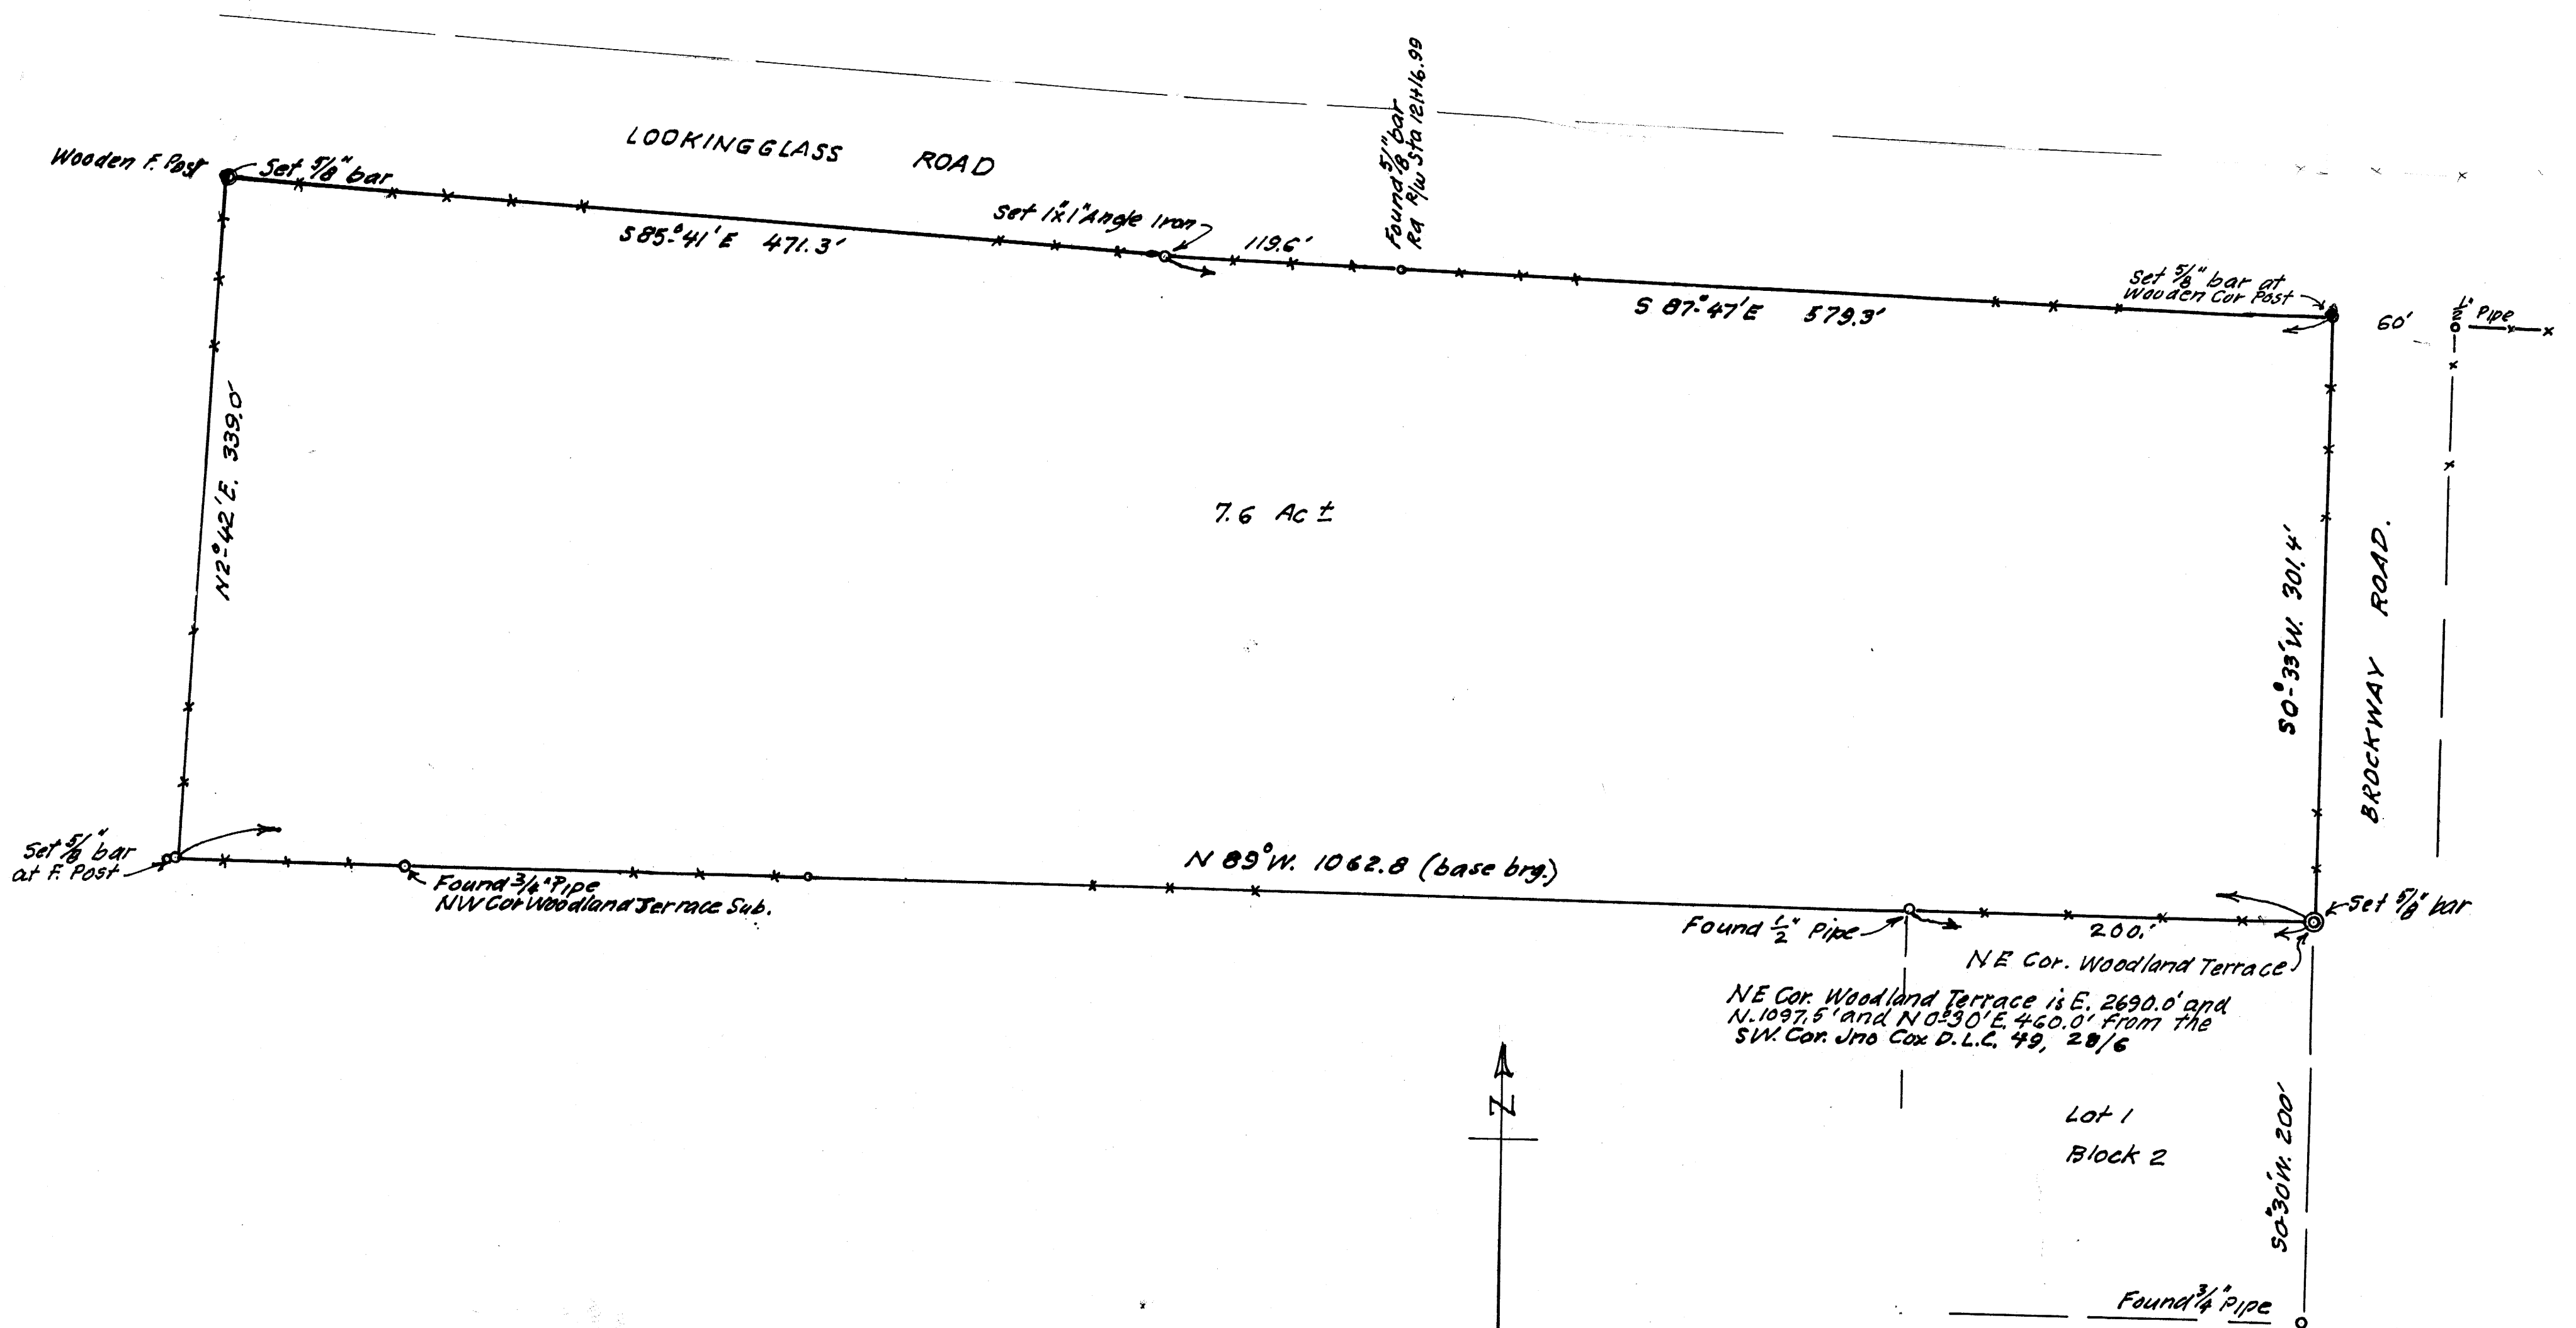

JIM RICHEY JR.
 ACREAGE FROM HAROLD EMERT
 IN JNO. COX D.L.C. 49, SEC. 20, T.28S; R.6W; WM;
 DOUGLAS COUNTY, ORE.

MAY 1970 1 1/2 60'

COUNTY SURVEYORS FILE
 DO NOT REMOVE FROM OFFICE

N39-57