


99-66W

FILED  
RECEIVED

JUL 19 1970

COUNTY SURVEYOR  
DOUGLAS COUNTY, ORE.

19 20 Found Cor.  
30 29  
T28S R7W

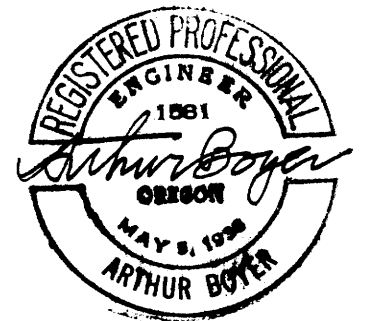

1297.5'

2594.9'  
N2°08'E

1297.4'

Set 1/2" Iron Rod  
208.0'  
Not to scale

Set 5/8" re bar 36" Long  
1086.5'  
589°08'W 1294.5'

Found 3/4" Pipe

Set 1 1/2" Iron Pipe  
7.26' E & 15.91' S  
of pipe found

171/158

LOT 5 SEC. 29

Found Corner

Needle bearings Dec 20°

COUNTY SURVEYORS FILE DATA  
DO NOT REMOVE FROM OFFICE

LESLIE HILL  
RT. 4, BOX 817, ROSEBURG  
N. LINE LOT 5, SEC. 29, T.28S; R.7W; W.M.,  
DOUGLAS COUNTY, ORE.

MAY, 1970

1"=200 ft

MAP FILE M39-66