


COUNTY SURVEYORS FILE DATA
DO NOT REMOVE FROM OFFICE

FILED
RECEIVED

JUN 11 1970

COUNTY SURVEYOR
DOUGLAS COUNTY, OREGON

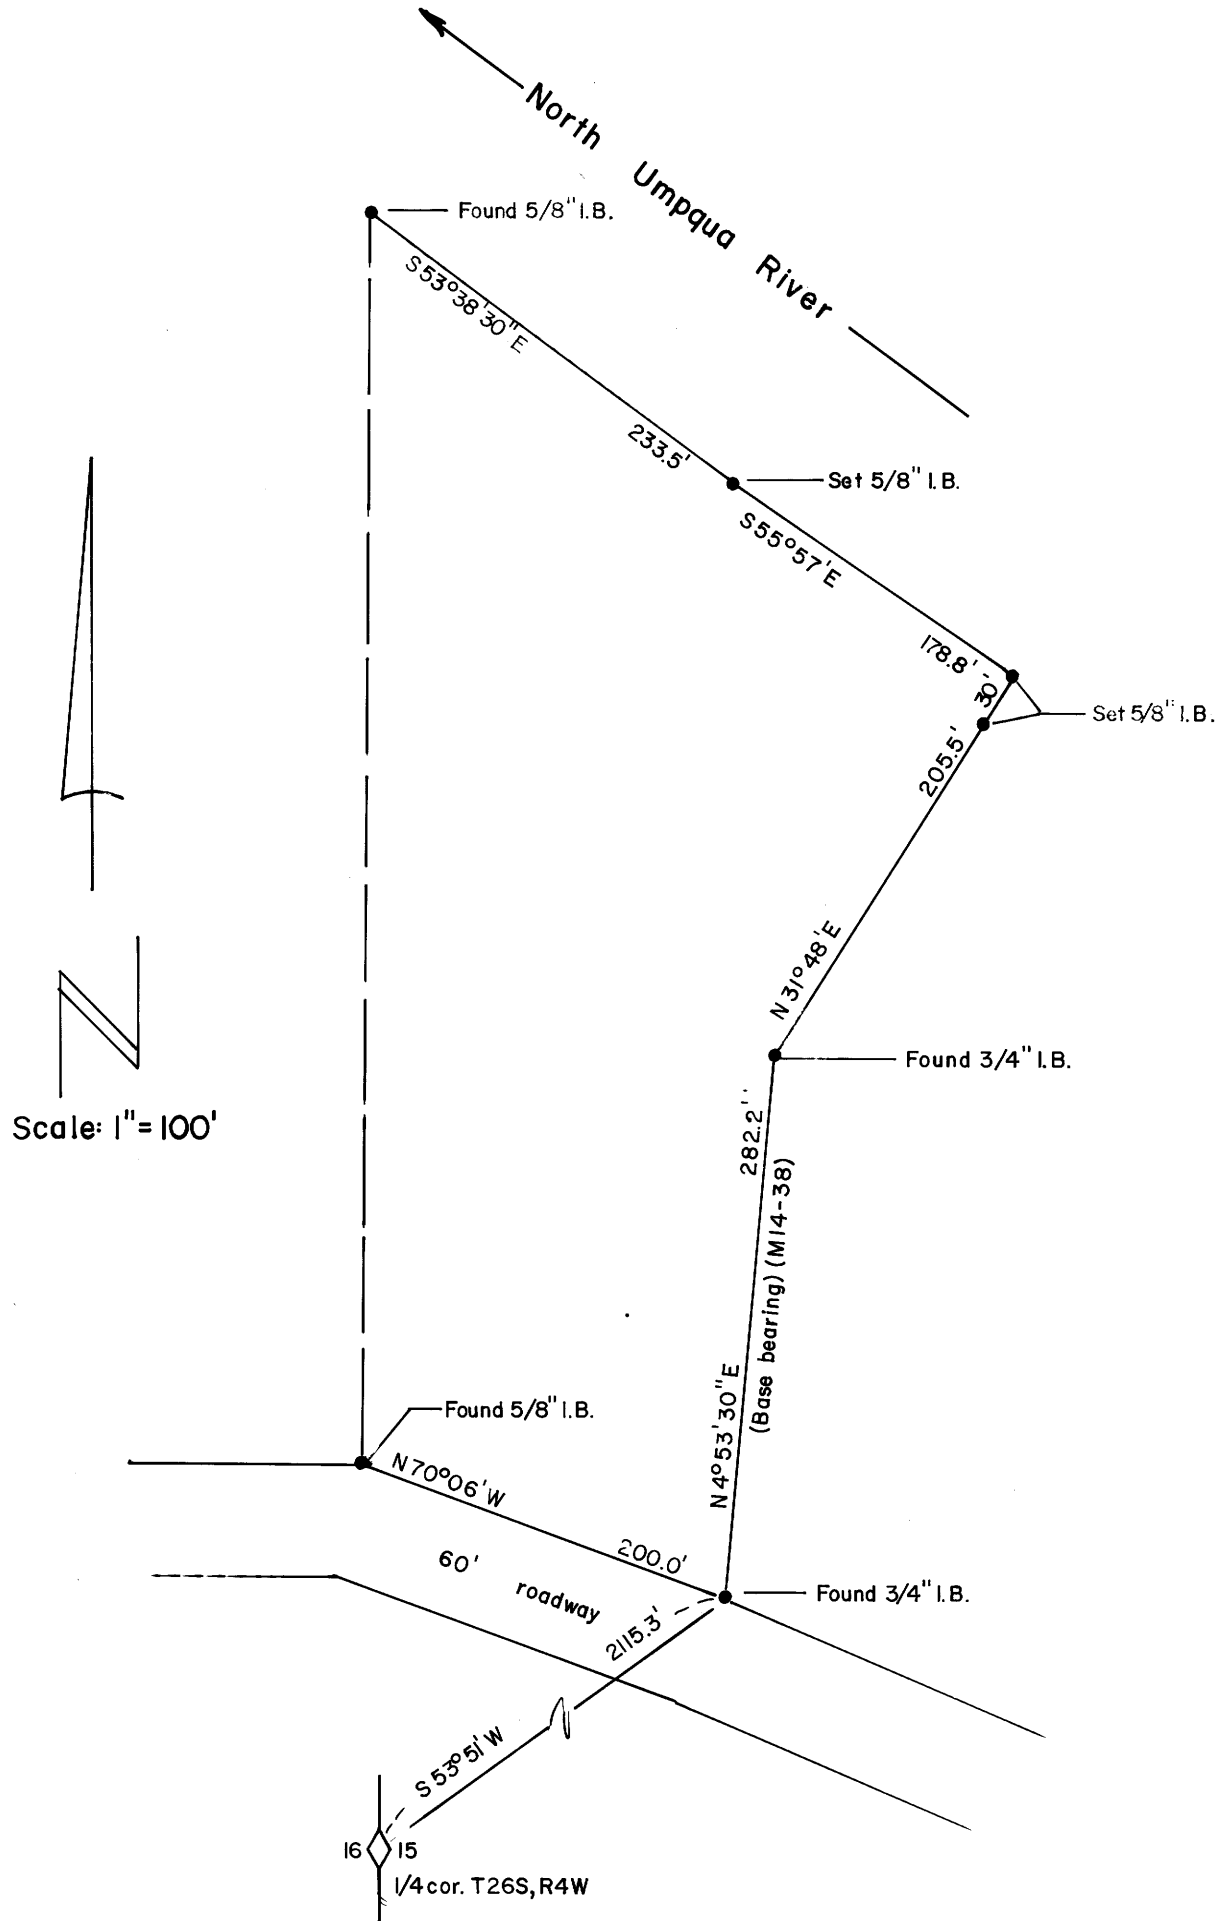

Survey for L. K. Cornwell
Section 15, T26S, R4W, W.M.

Surveyed by SEEK, INC. Aug., 1968

REGISTERED
OREGON
LAND SURVEYOR

William C. Stiles

OCT. 4, 1957
WILLIAM C. STILES
432

M39 - 72