


COUNTY SURVEYORS FILE DATA
DO NOT REMOVE FROM OFFICE

SURVEY FOR DEED DESCRIPTION
IN SECS 6 & 7, T29S, R8W, W.M.

SURVEYED FOR - FRANK KINNAN AUG. 1970
SURVEYED BY - W.S. BARNES SCALE 1"=100'

LL

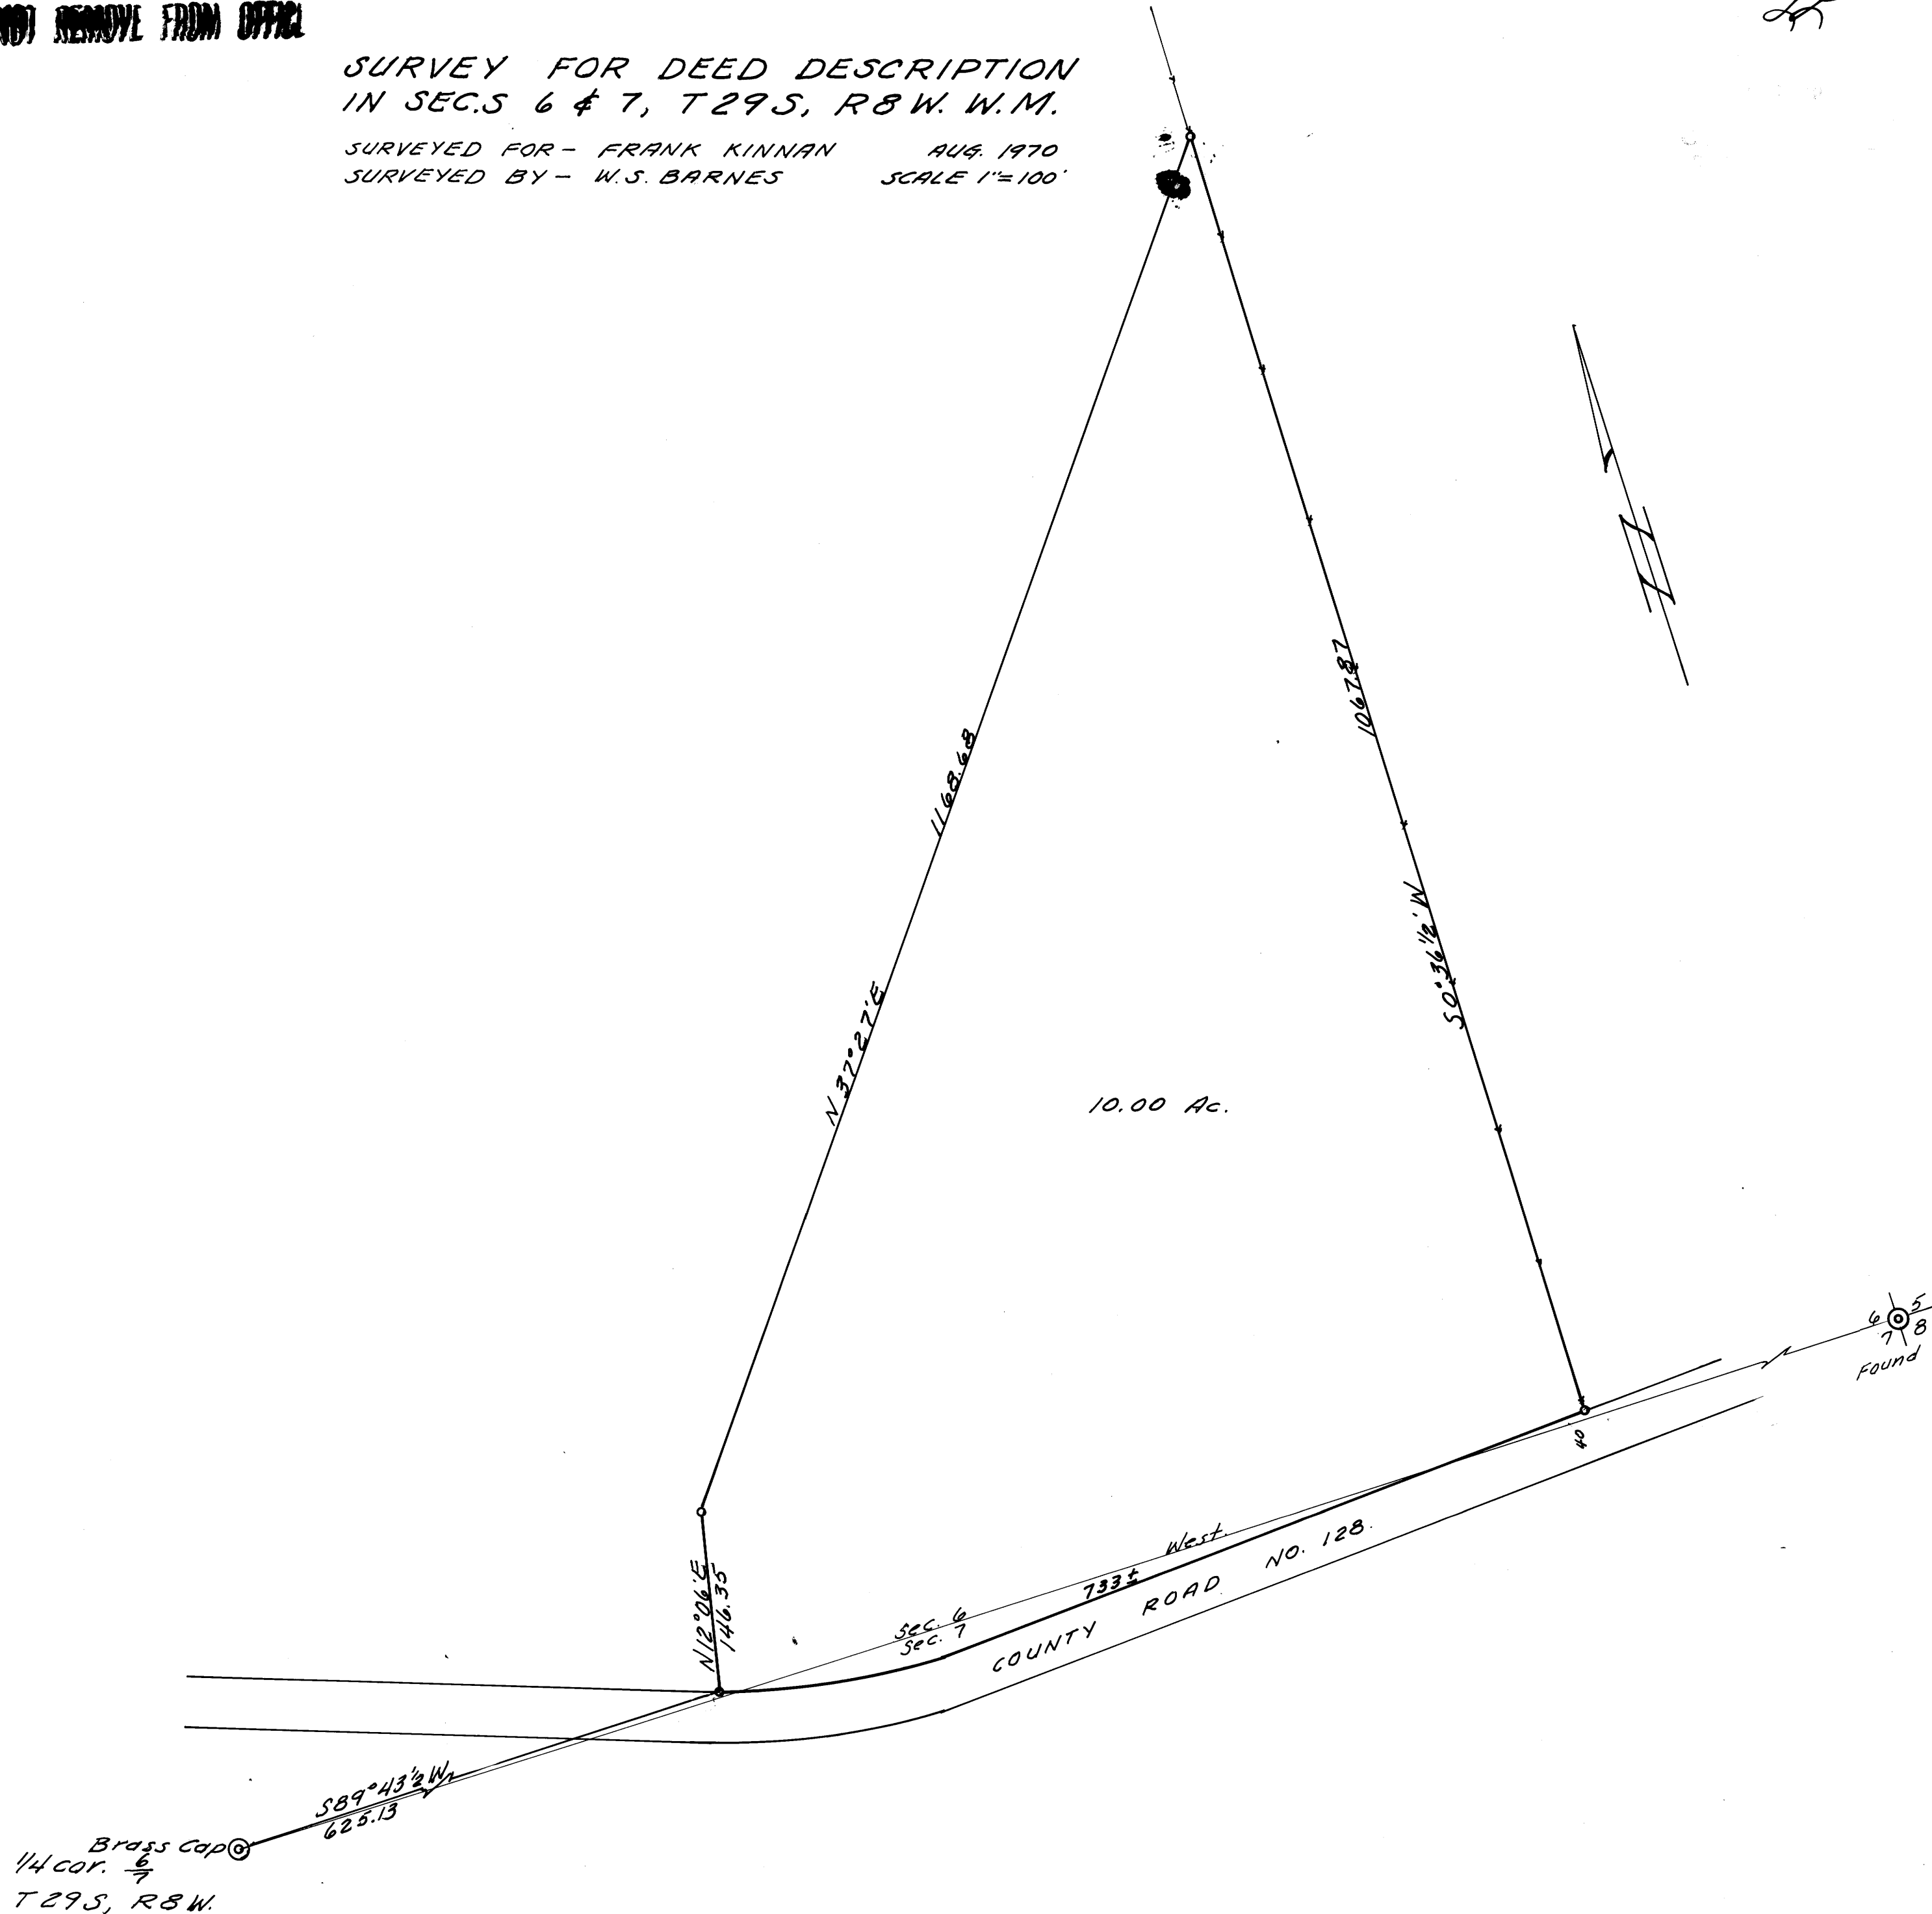

o Denotes 5/8" iron rods set
Base bearing taken from sec. line 6/7

