

**COUNTY SURVEYORS FILE DATA
DO NOT REMOVE FROM OFFICE**

SURVEY IN SEC. 15, T 28 S, R 6 W, W.M.
SURVEYED FOR DORIS McLAUGHLIN
SURVEYED BY DON E. GARRETT
AUGUST 1970


FILED
RECEIVED

SEP 6 1970

COUNTY SURVEYOR
DOUGLAS COUNTY, ORE.

M 40 - 25

P.

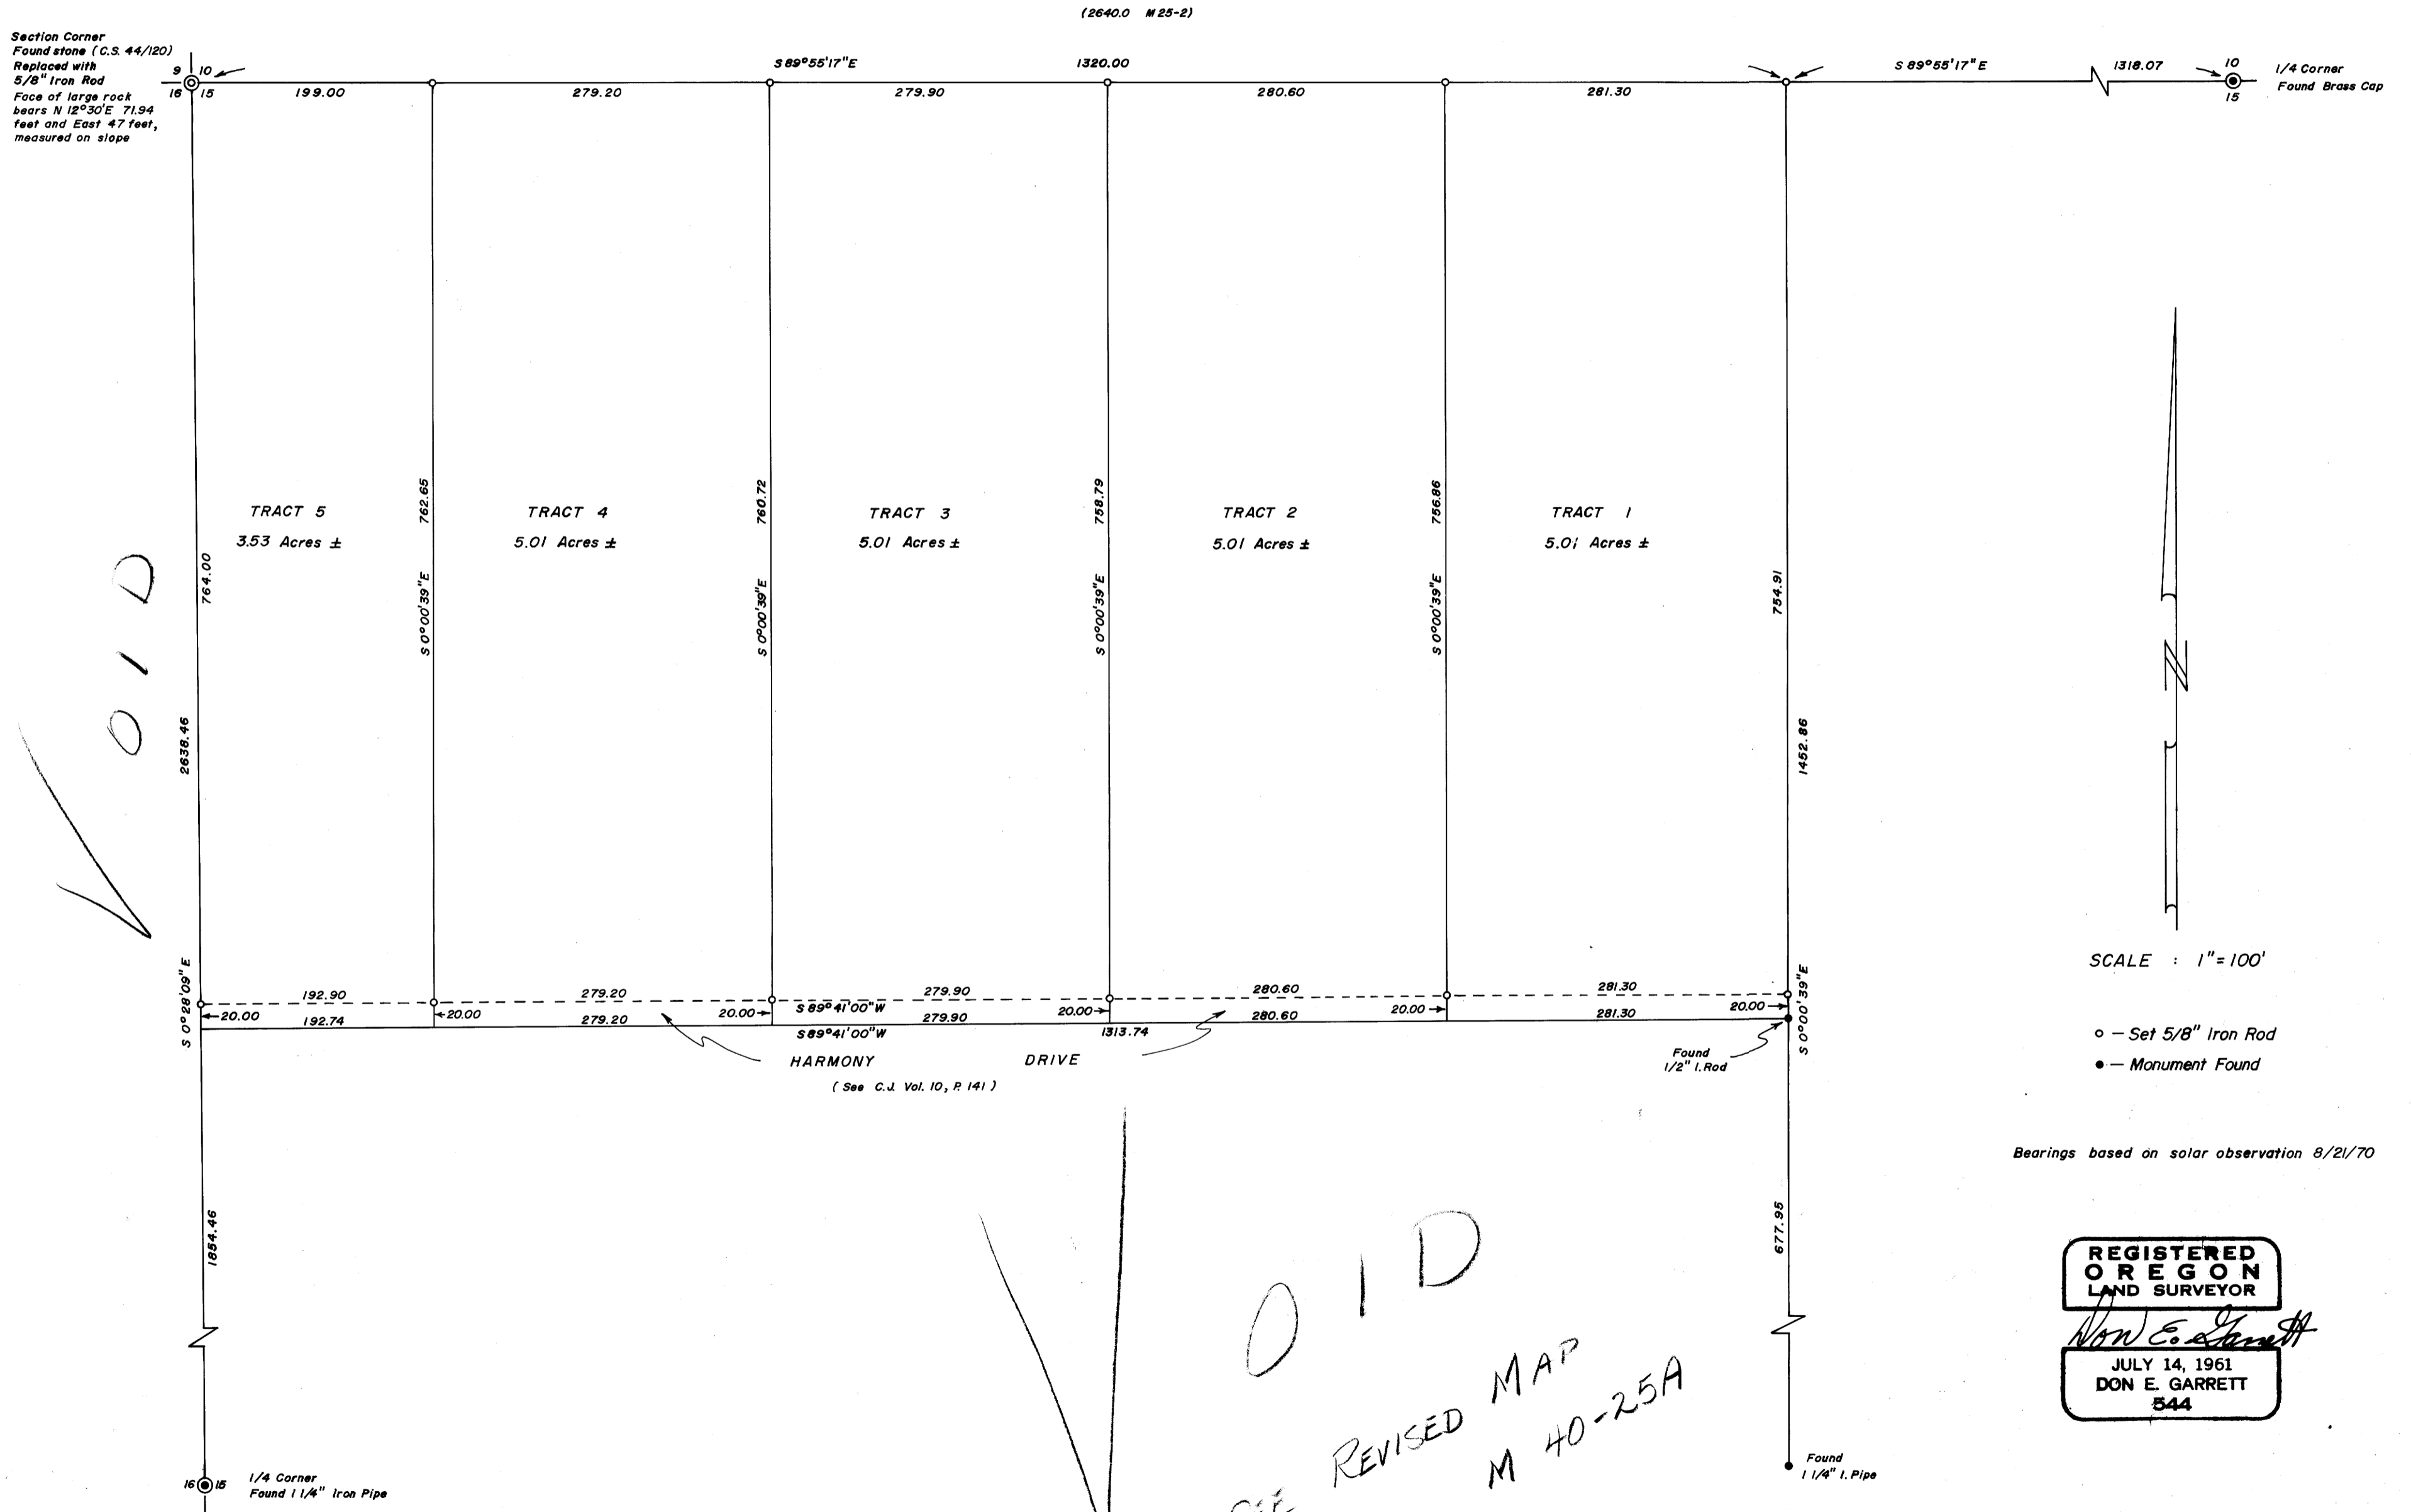

M 40 - 25