


COUNTY SURVEYORS FILE DATA  
DO NOT REMOVE FROM OFFICE

SURVEY TO ESTABLISH PROPERTY LINES  
IN SEC. 9, T 30 S, R 5 W. W. M.

SURVEYED FOR - WILSON MEARS  
SURVEYED BY - W. S. BARNES

OCT. 1970  
SCALE 1" = 400'

4

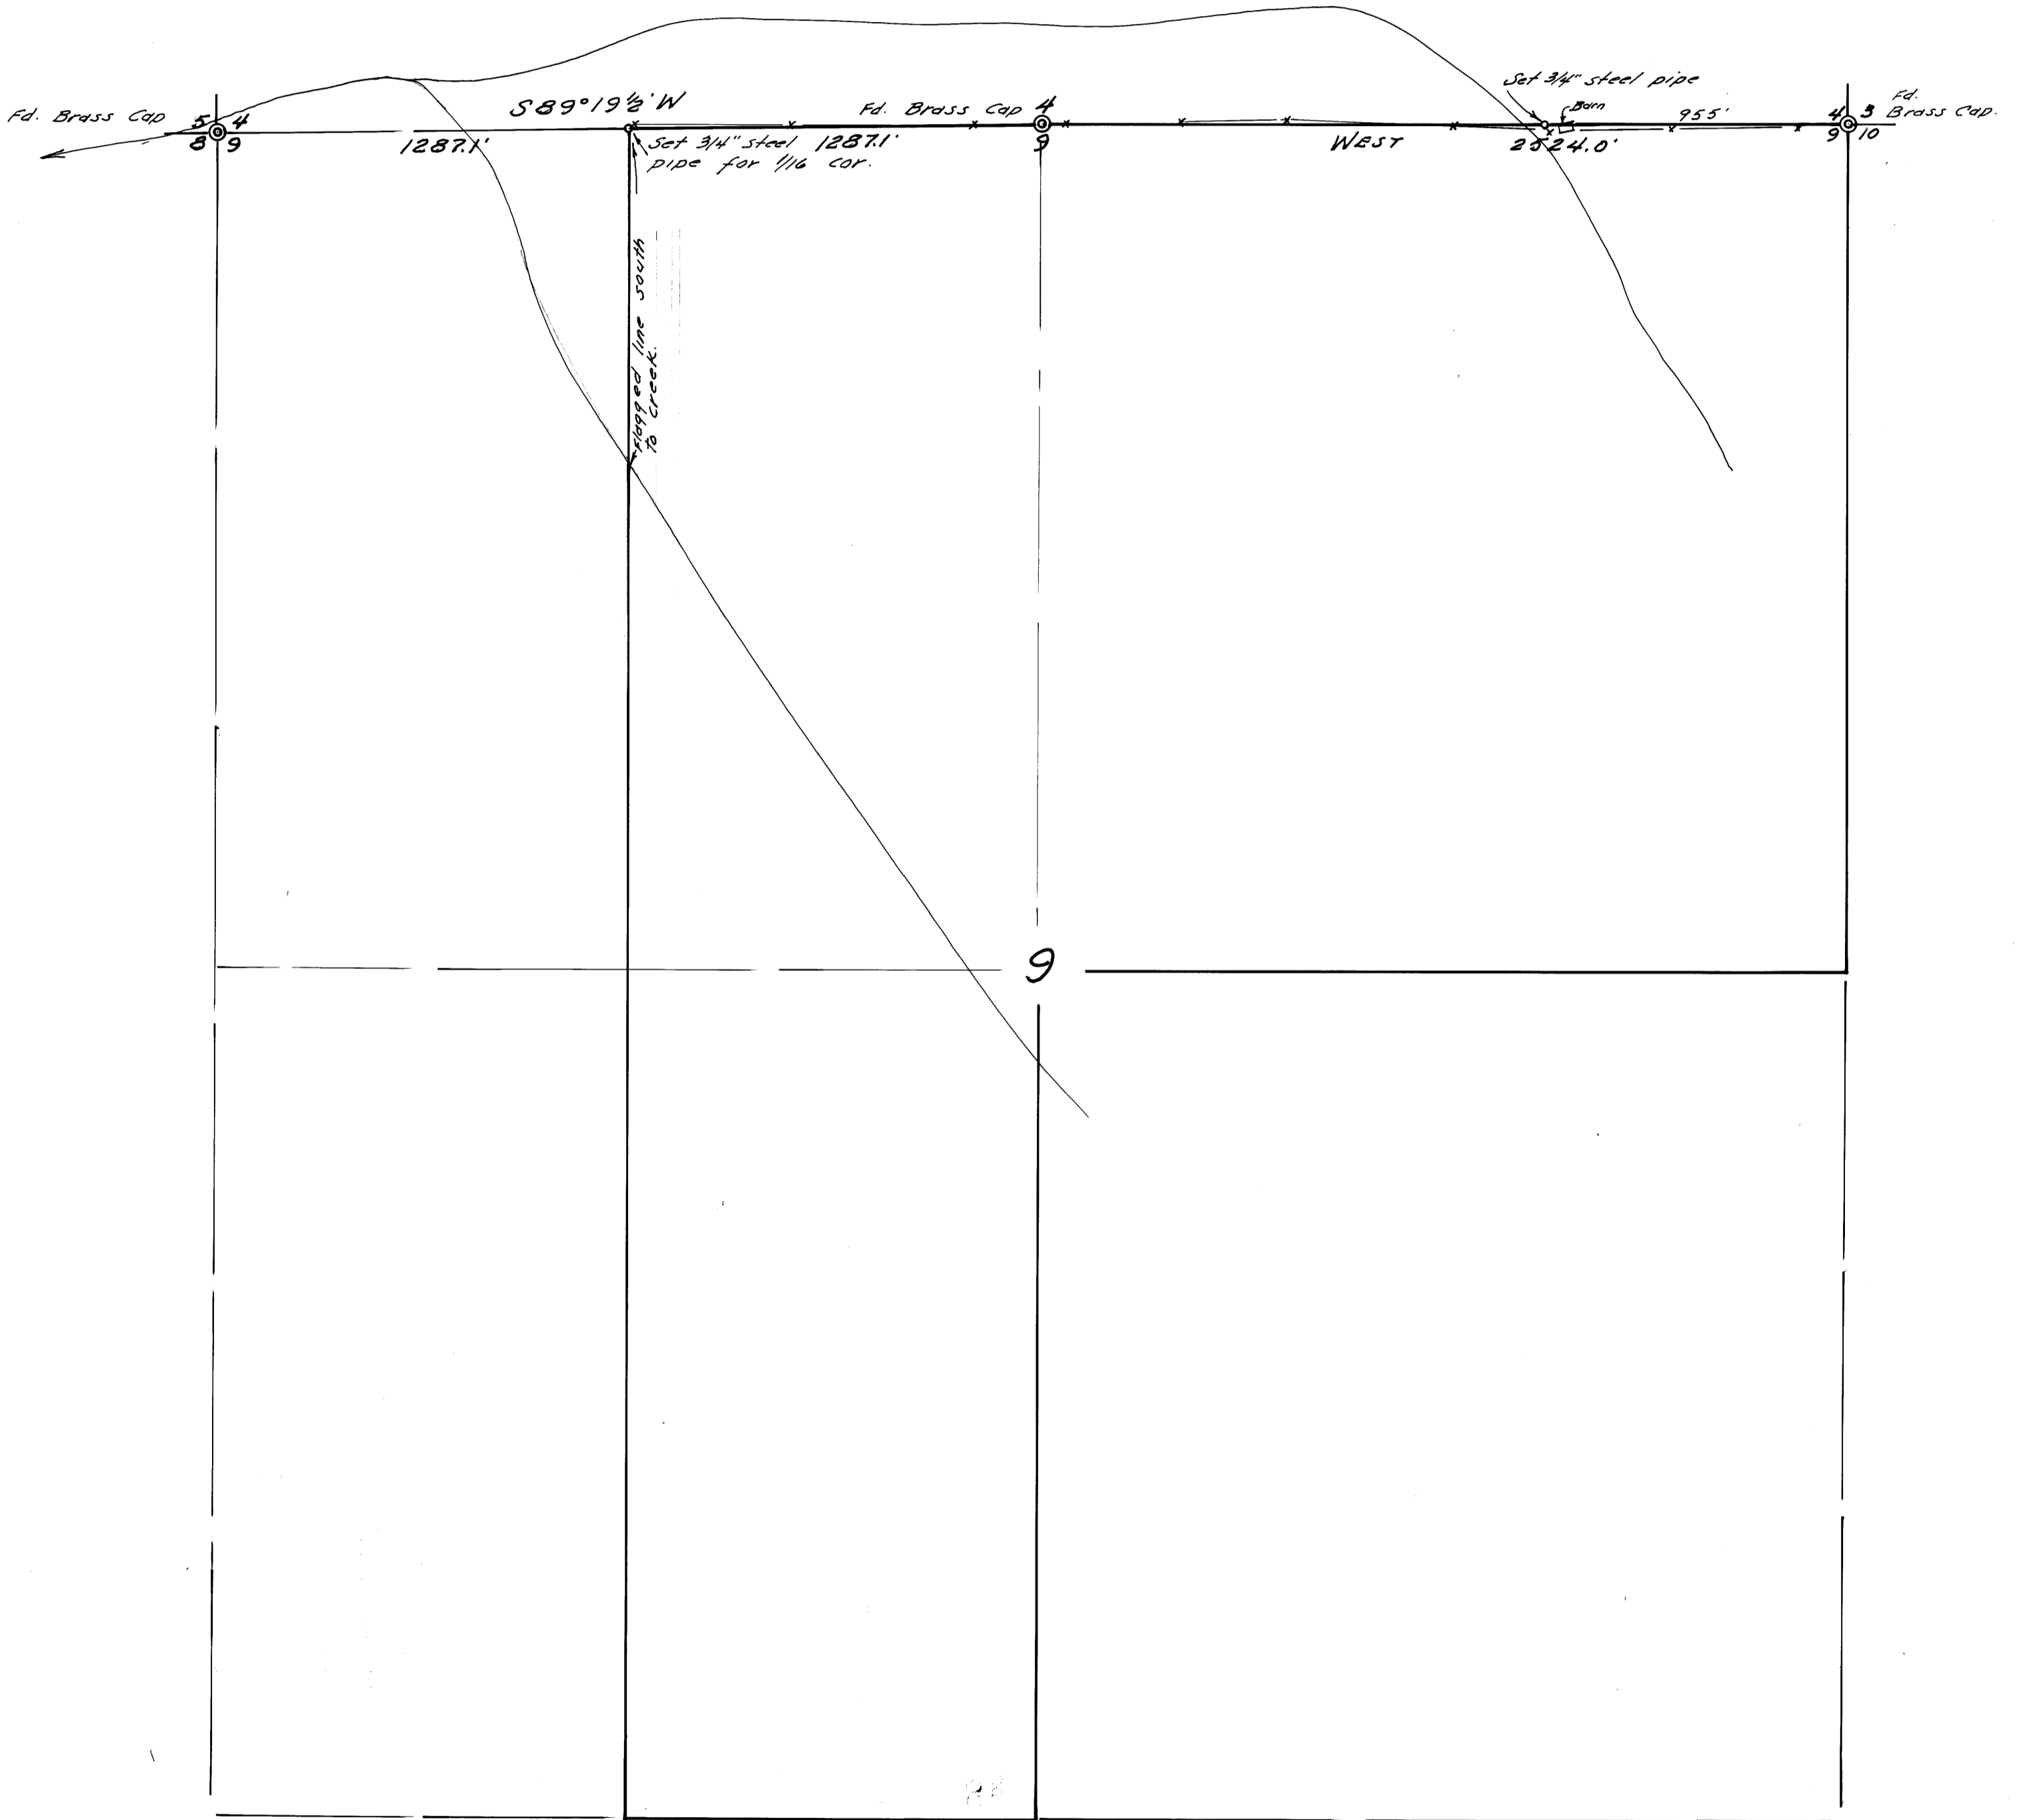

Note: Base bearing taken from north line of Sec. 9.

