


BASE OF BEARINGS ~ EAST LINE  
 OF LOT 5 (SEE C.S. M 23-66)  
 SET 5/8" IRON

REGISTERED  
 OREGON  
 LAND SURVEYOR  
 DONALD A. BENTZ  
 JULY 12, 1968  
 839

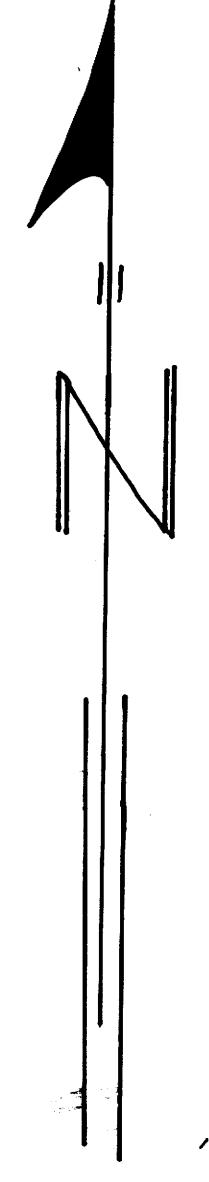

SCALE 1" = 40'

SURVEYED BY ~ DONALD A. BENTZ  
 NOVEMBER, 1970

A PORTION OF LOT 5, PLAT 'F', ROSEBURG  
 HOME ORCHARD TRACT, DOUGLAS COUNTY  
 OREGON

RON & GLENDA ALEXANDER

for

FIELD SURVEY & PLAT

COUNTY SURVEYORS FILE DATA  
 DO NOT REMOVE FROM OFFICE

*Handwritten initials*

LOTS