


COUNTY SURVEYORS FILE DATA
DO NOT REMOVE FROM OFFICE

SURVEY IN LOT 57, MELROSE ORCHARDS, SECT. 36, TWP. 26 STH., RNG. 7 WEST, WILL. MERID.
Surveyed for Bill Carnley by Don E. Garrett
O-SET 5/8" I. ROD

FILED *LL*
RECEIVED
FEB 10 1971
COUNTY SURVEYOR
CLATSOP COUNTY, ORE.

M41-12

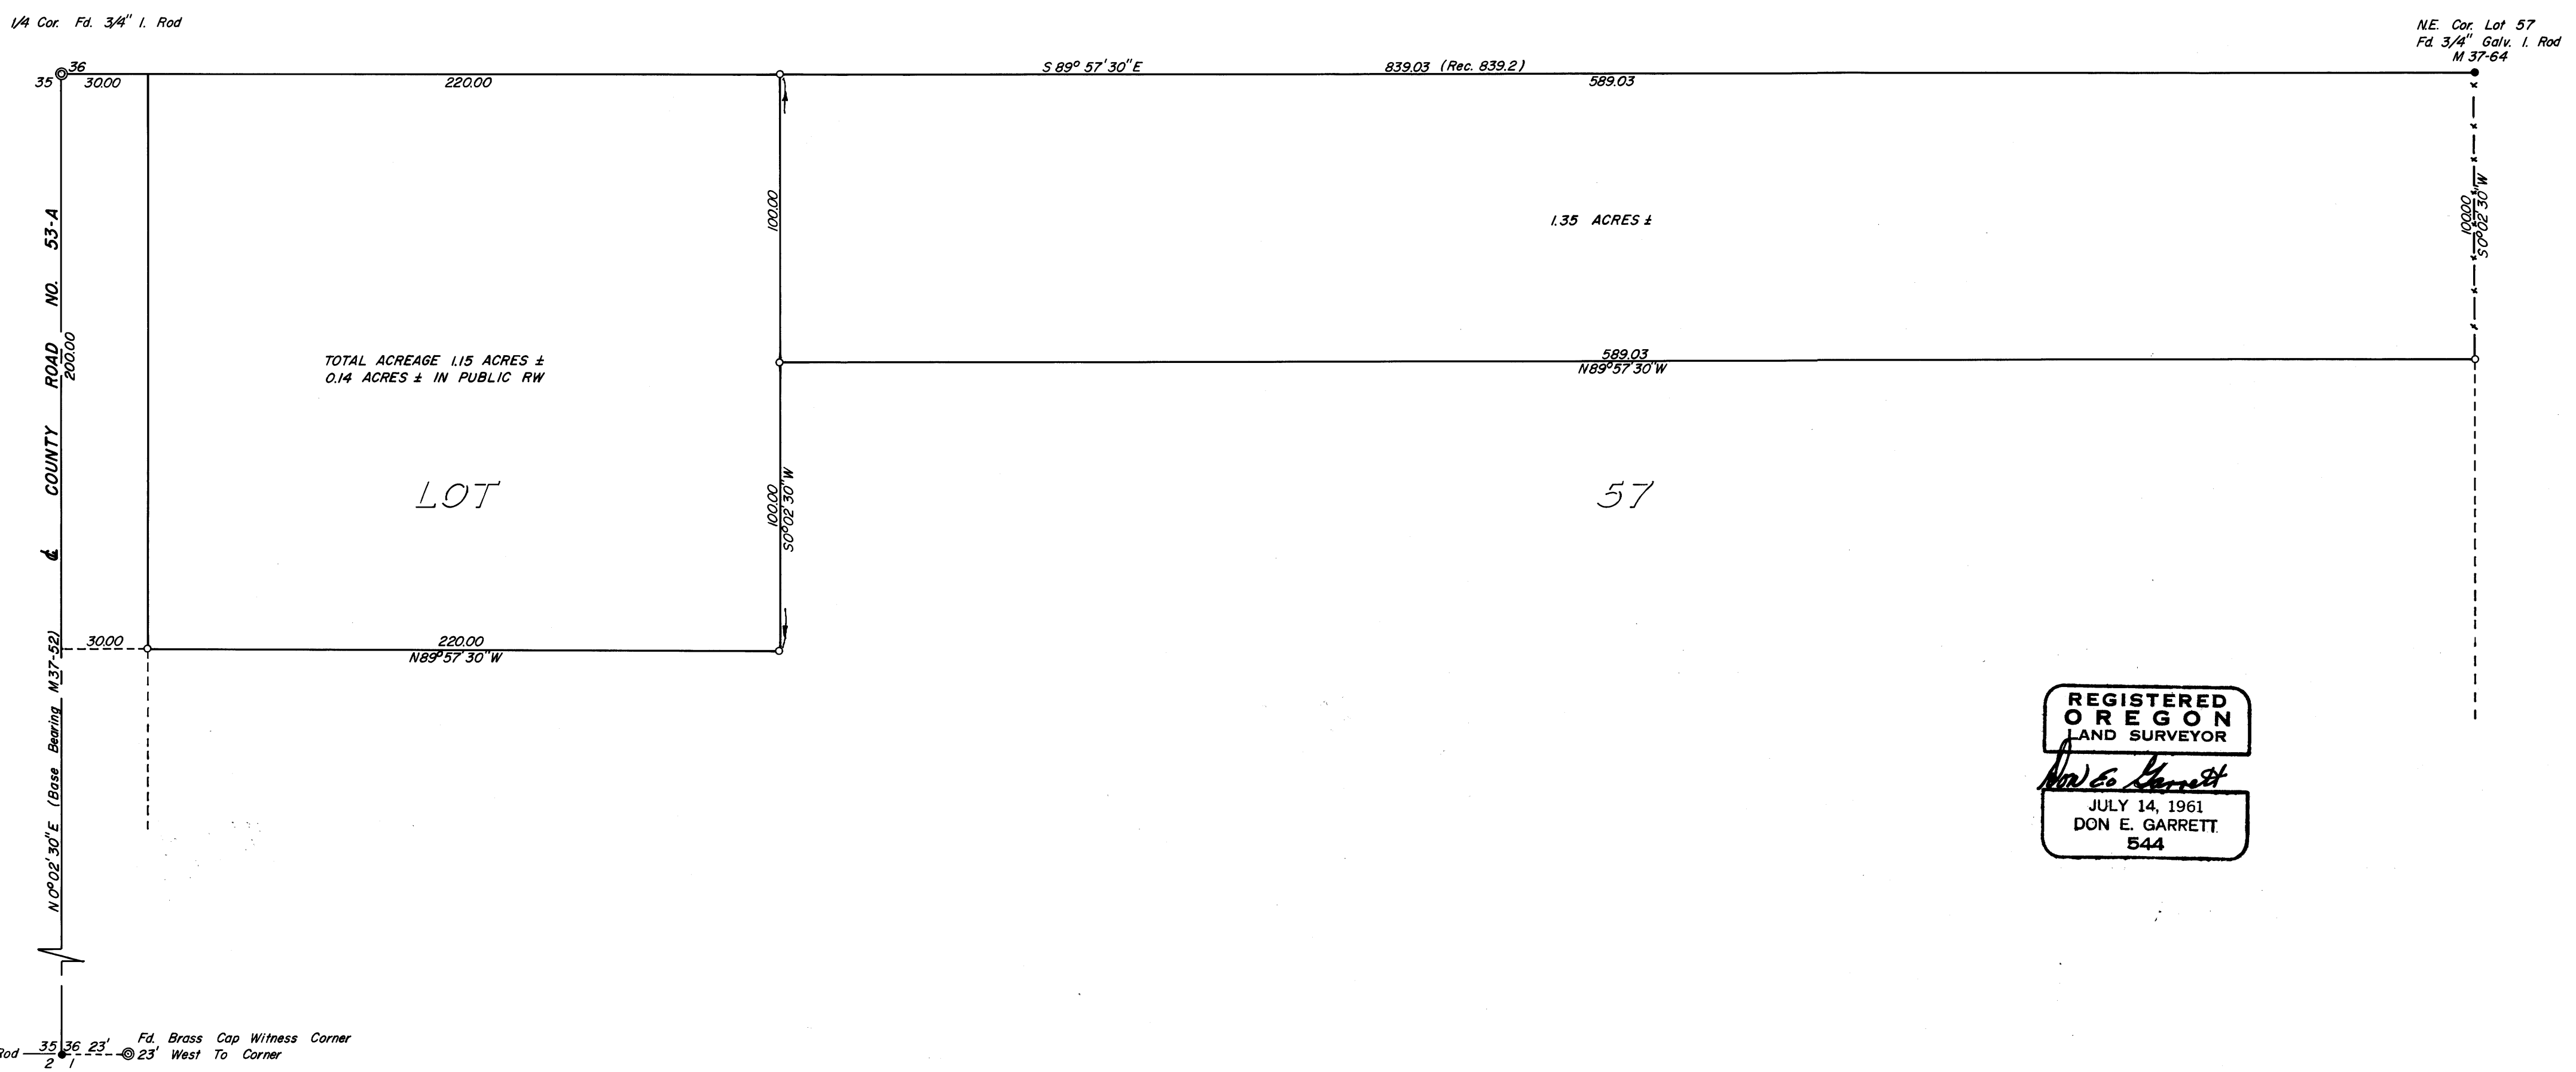

M41-12