


SURVEY IN LOT 7, PLAT 'B', DEER CREEK ORCHARD TRACTS, SEC. 16, T 27 S, R 5 W, W.M.
Surveyed for Neel Simpson by Don E. Garrett
March 1971

Scale 1" = 50'

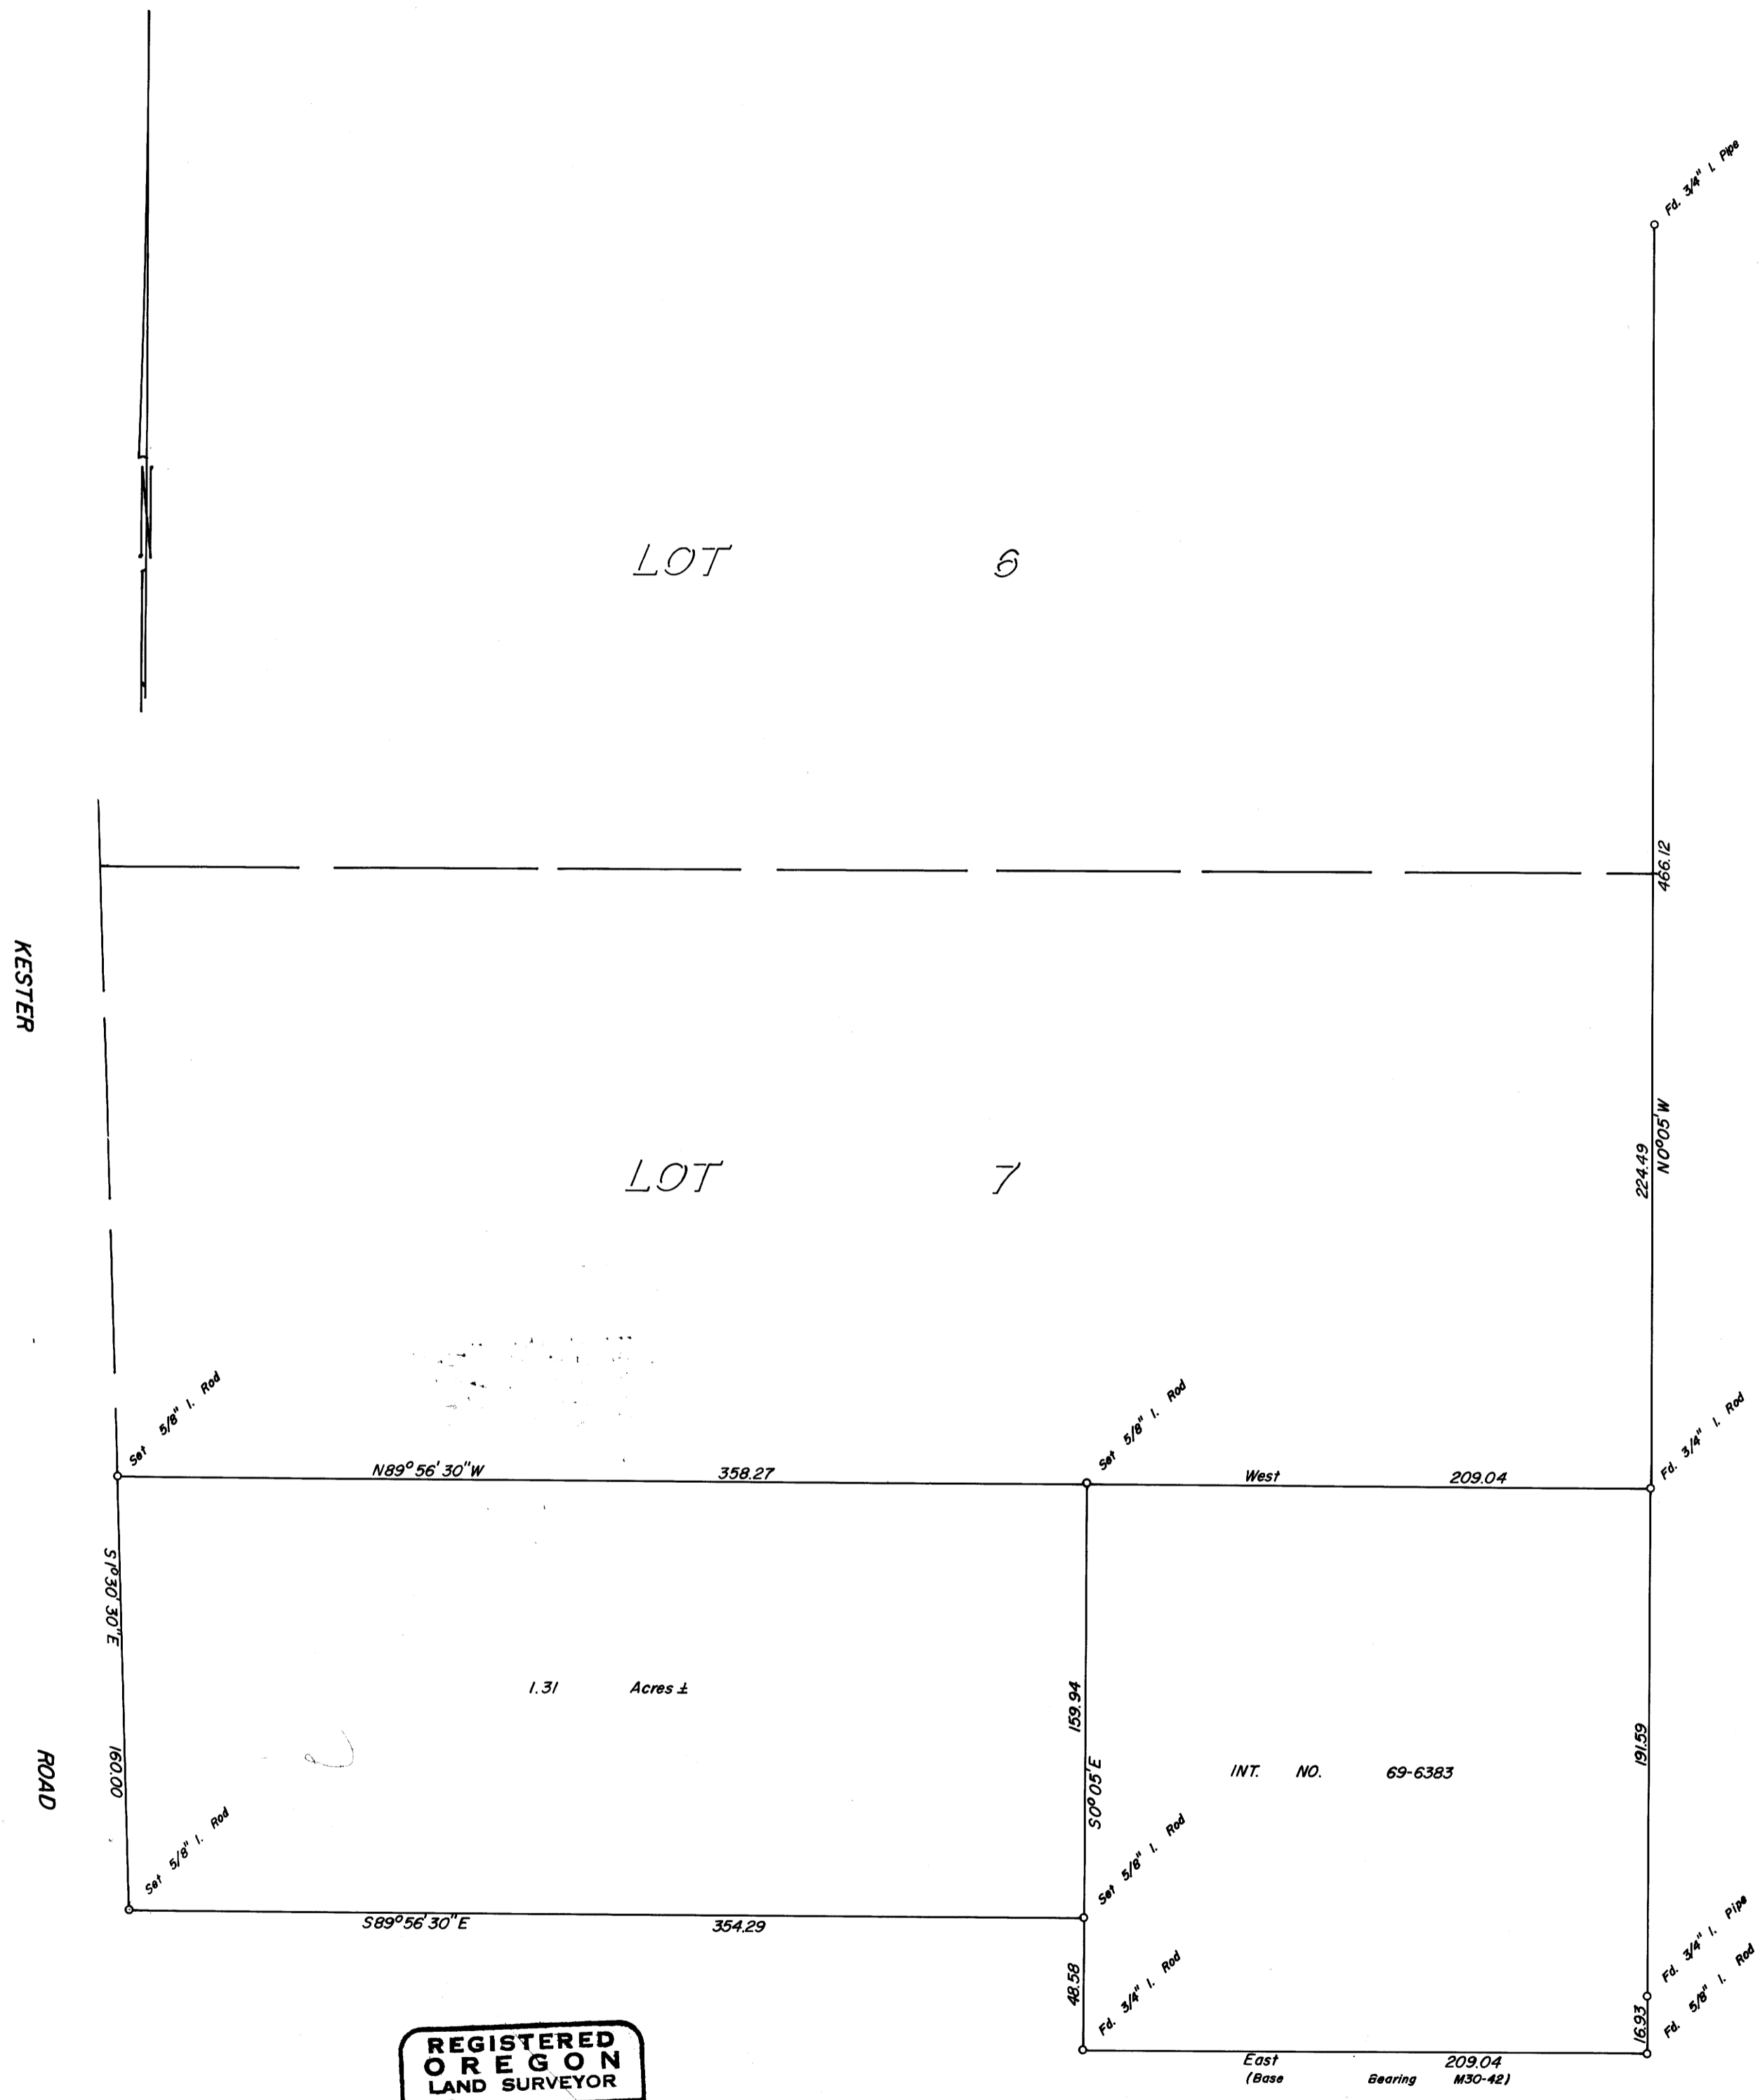

REGISTERED
OREGON
LAND SURVEYOR

Don E. Garrett

JULY 14, 1961
DON E. GARRETT
544