


COUNTY SURVEYORS FILE DATA
DO NOT REMOVE FROM OFFICE

FILED
RECEIVED

APR 2 1971

COUNTY SURVEYOR
DOUGLAS COUNTY, OREGON

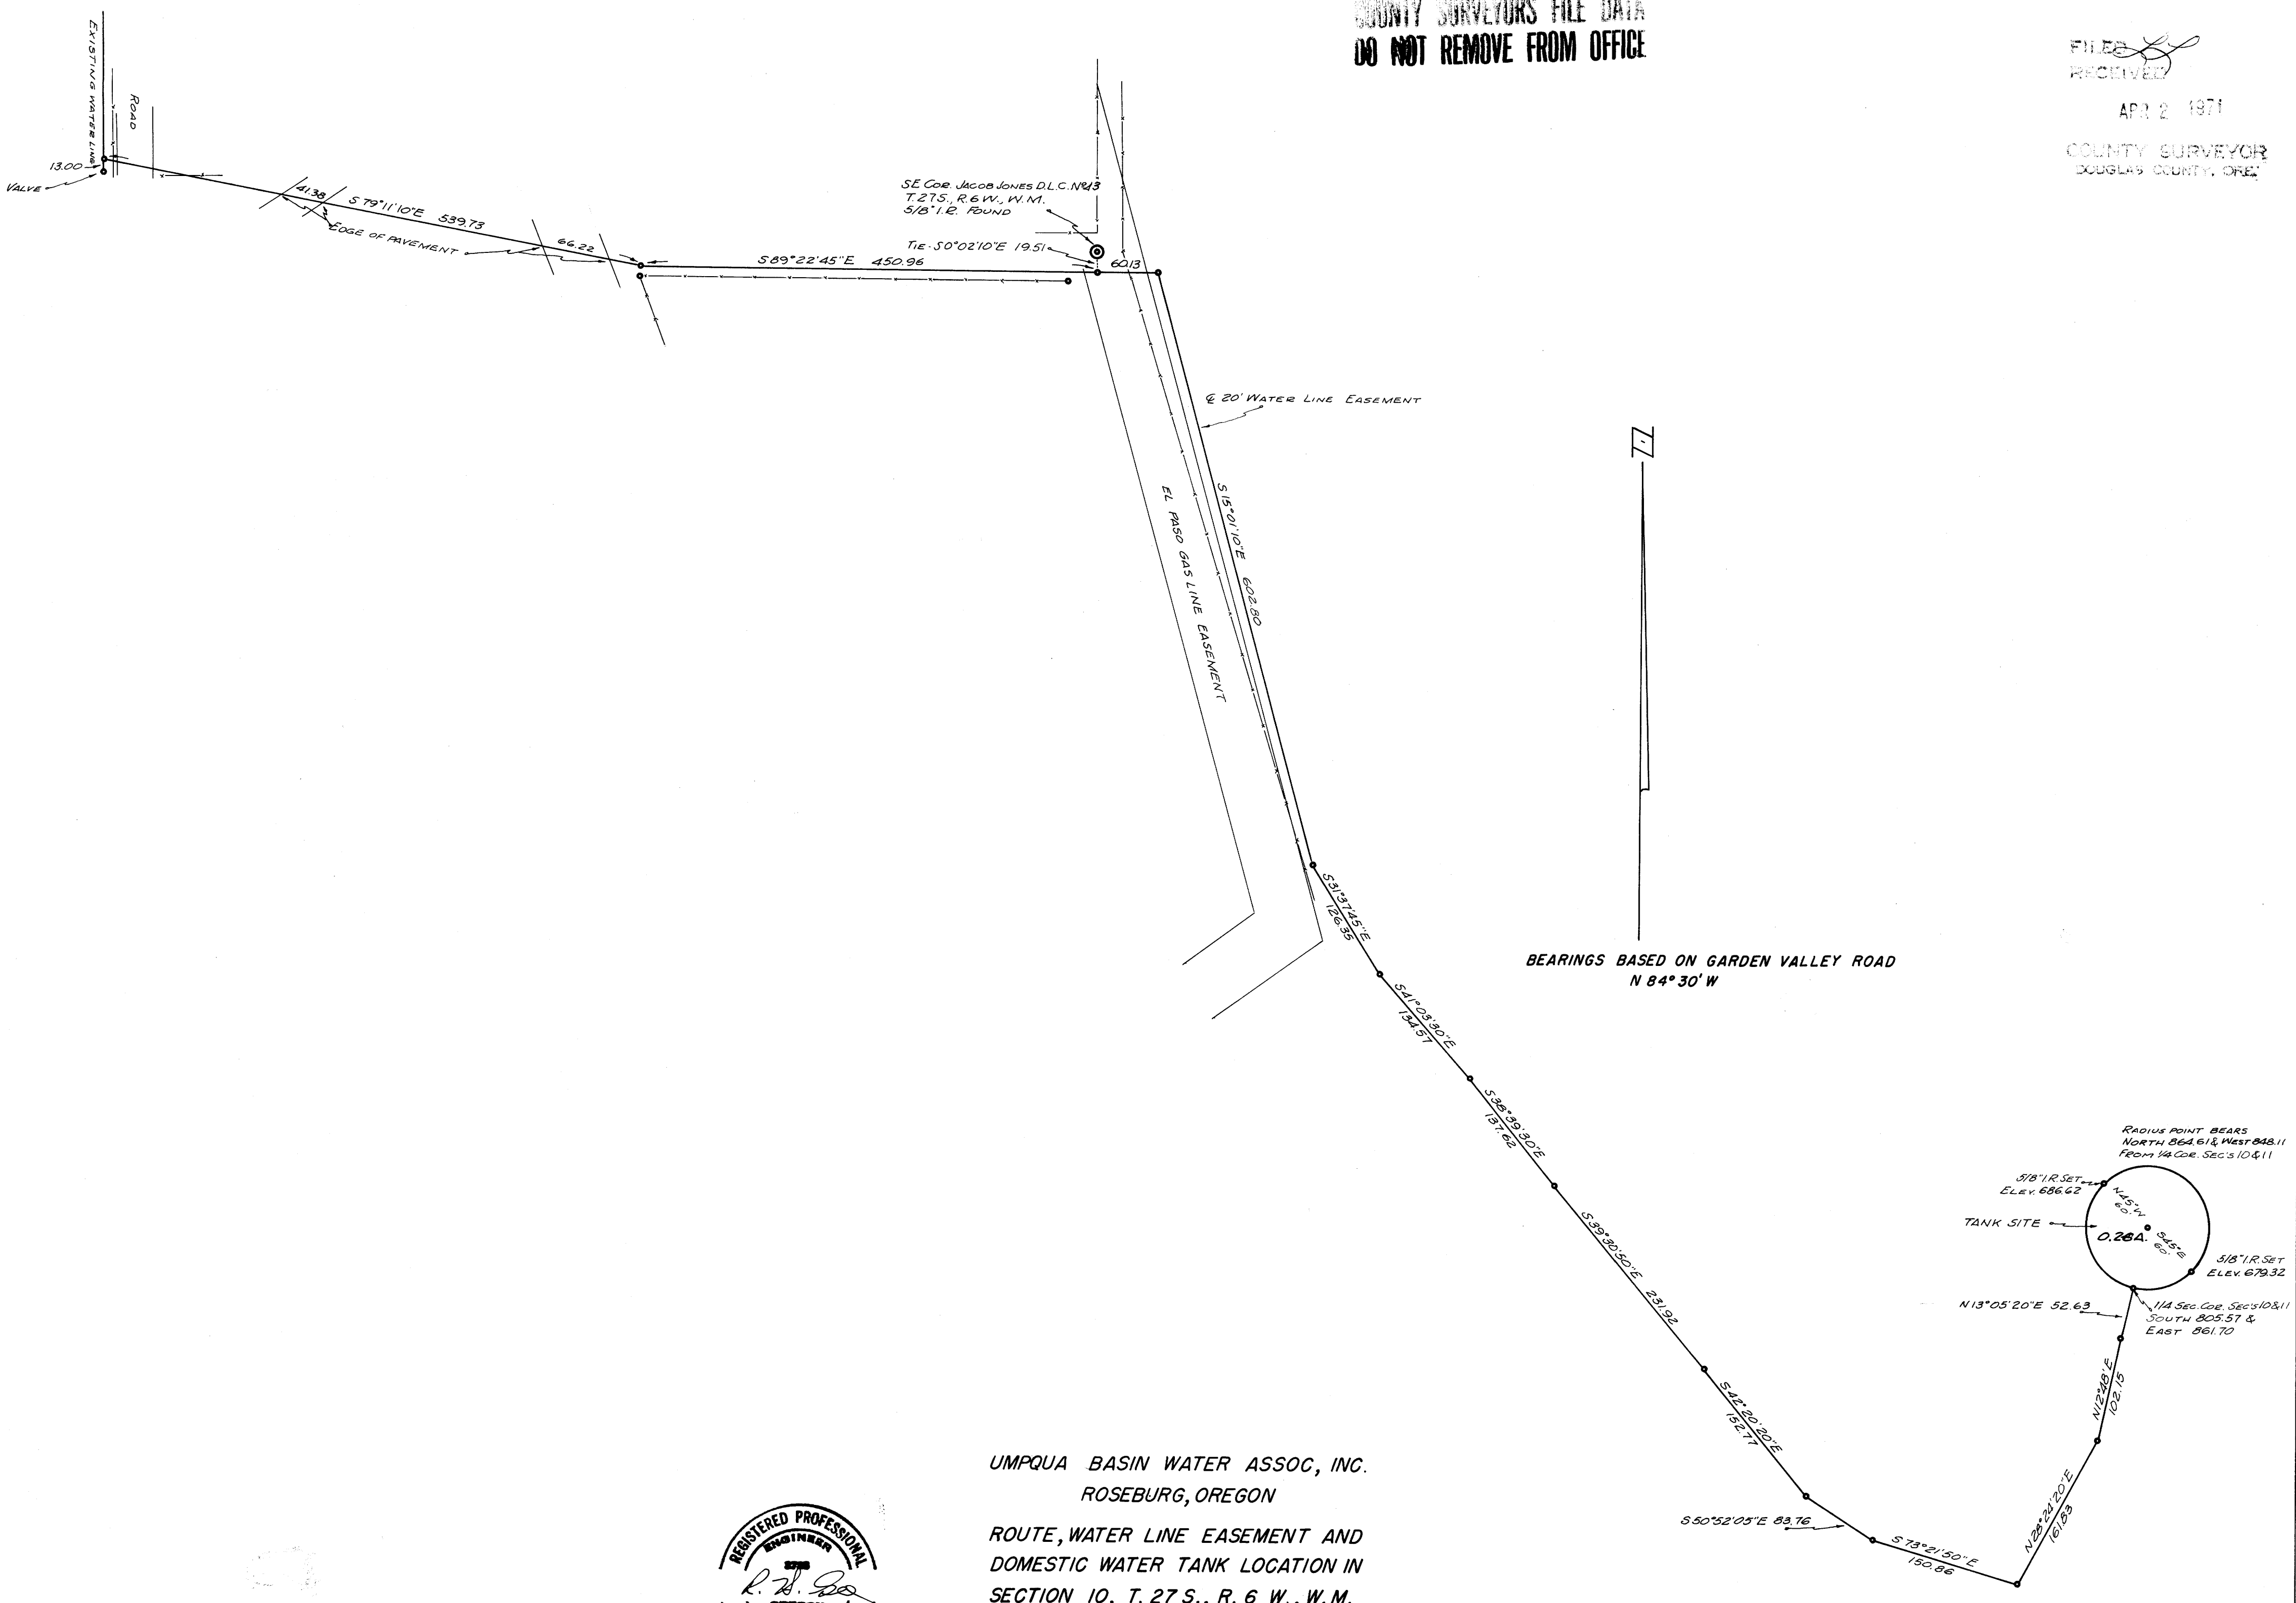

UMPQUA BASIN WATER ASSOC, INC.
ROSEBURG, OREGON

ROUTE, WATER LINE EASEMENT AND
DOMESTIC WATER TANK LOCATION IN
SECTION 10, T. 27 S., R. 6 W., W.M.

R. H. GEE MARCH, 1971
SCALE 1" = 100'



M 41 - 37

M 41 - 37