



41-45

THIS IS A  
REPRODUCTION  
OF THE ORIGINAL  
SURVEY RECORD

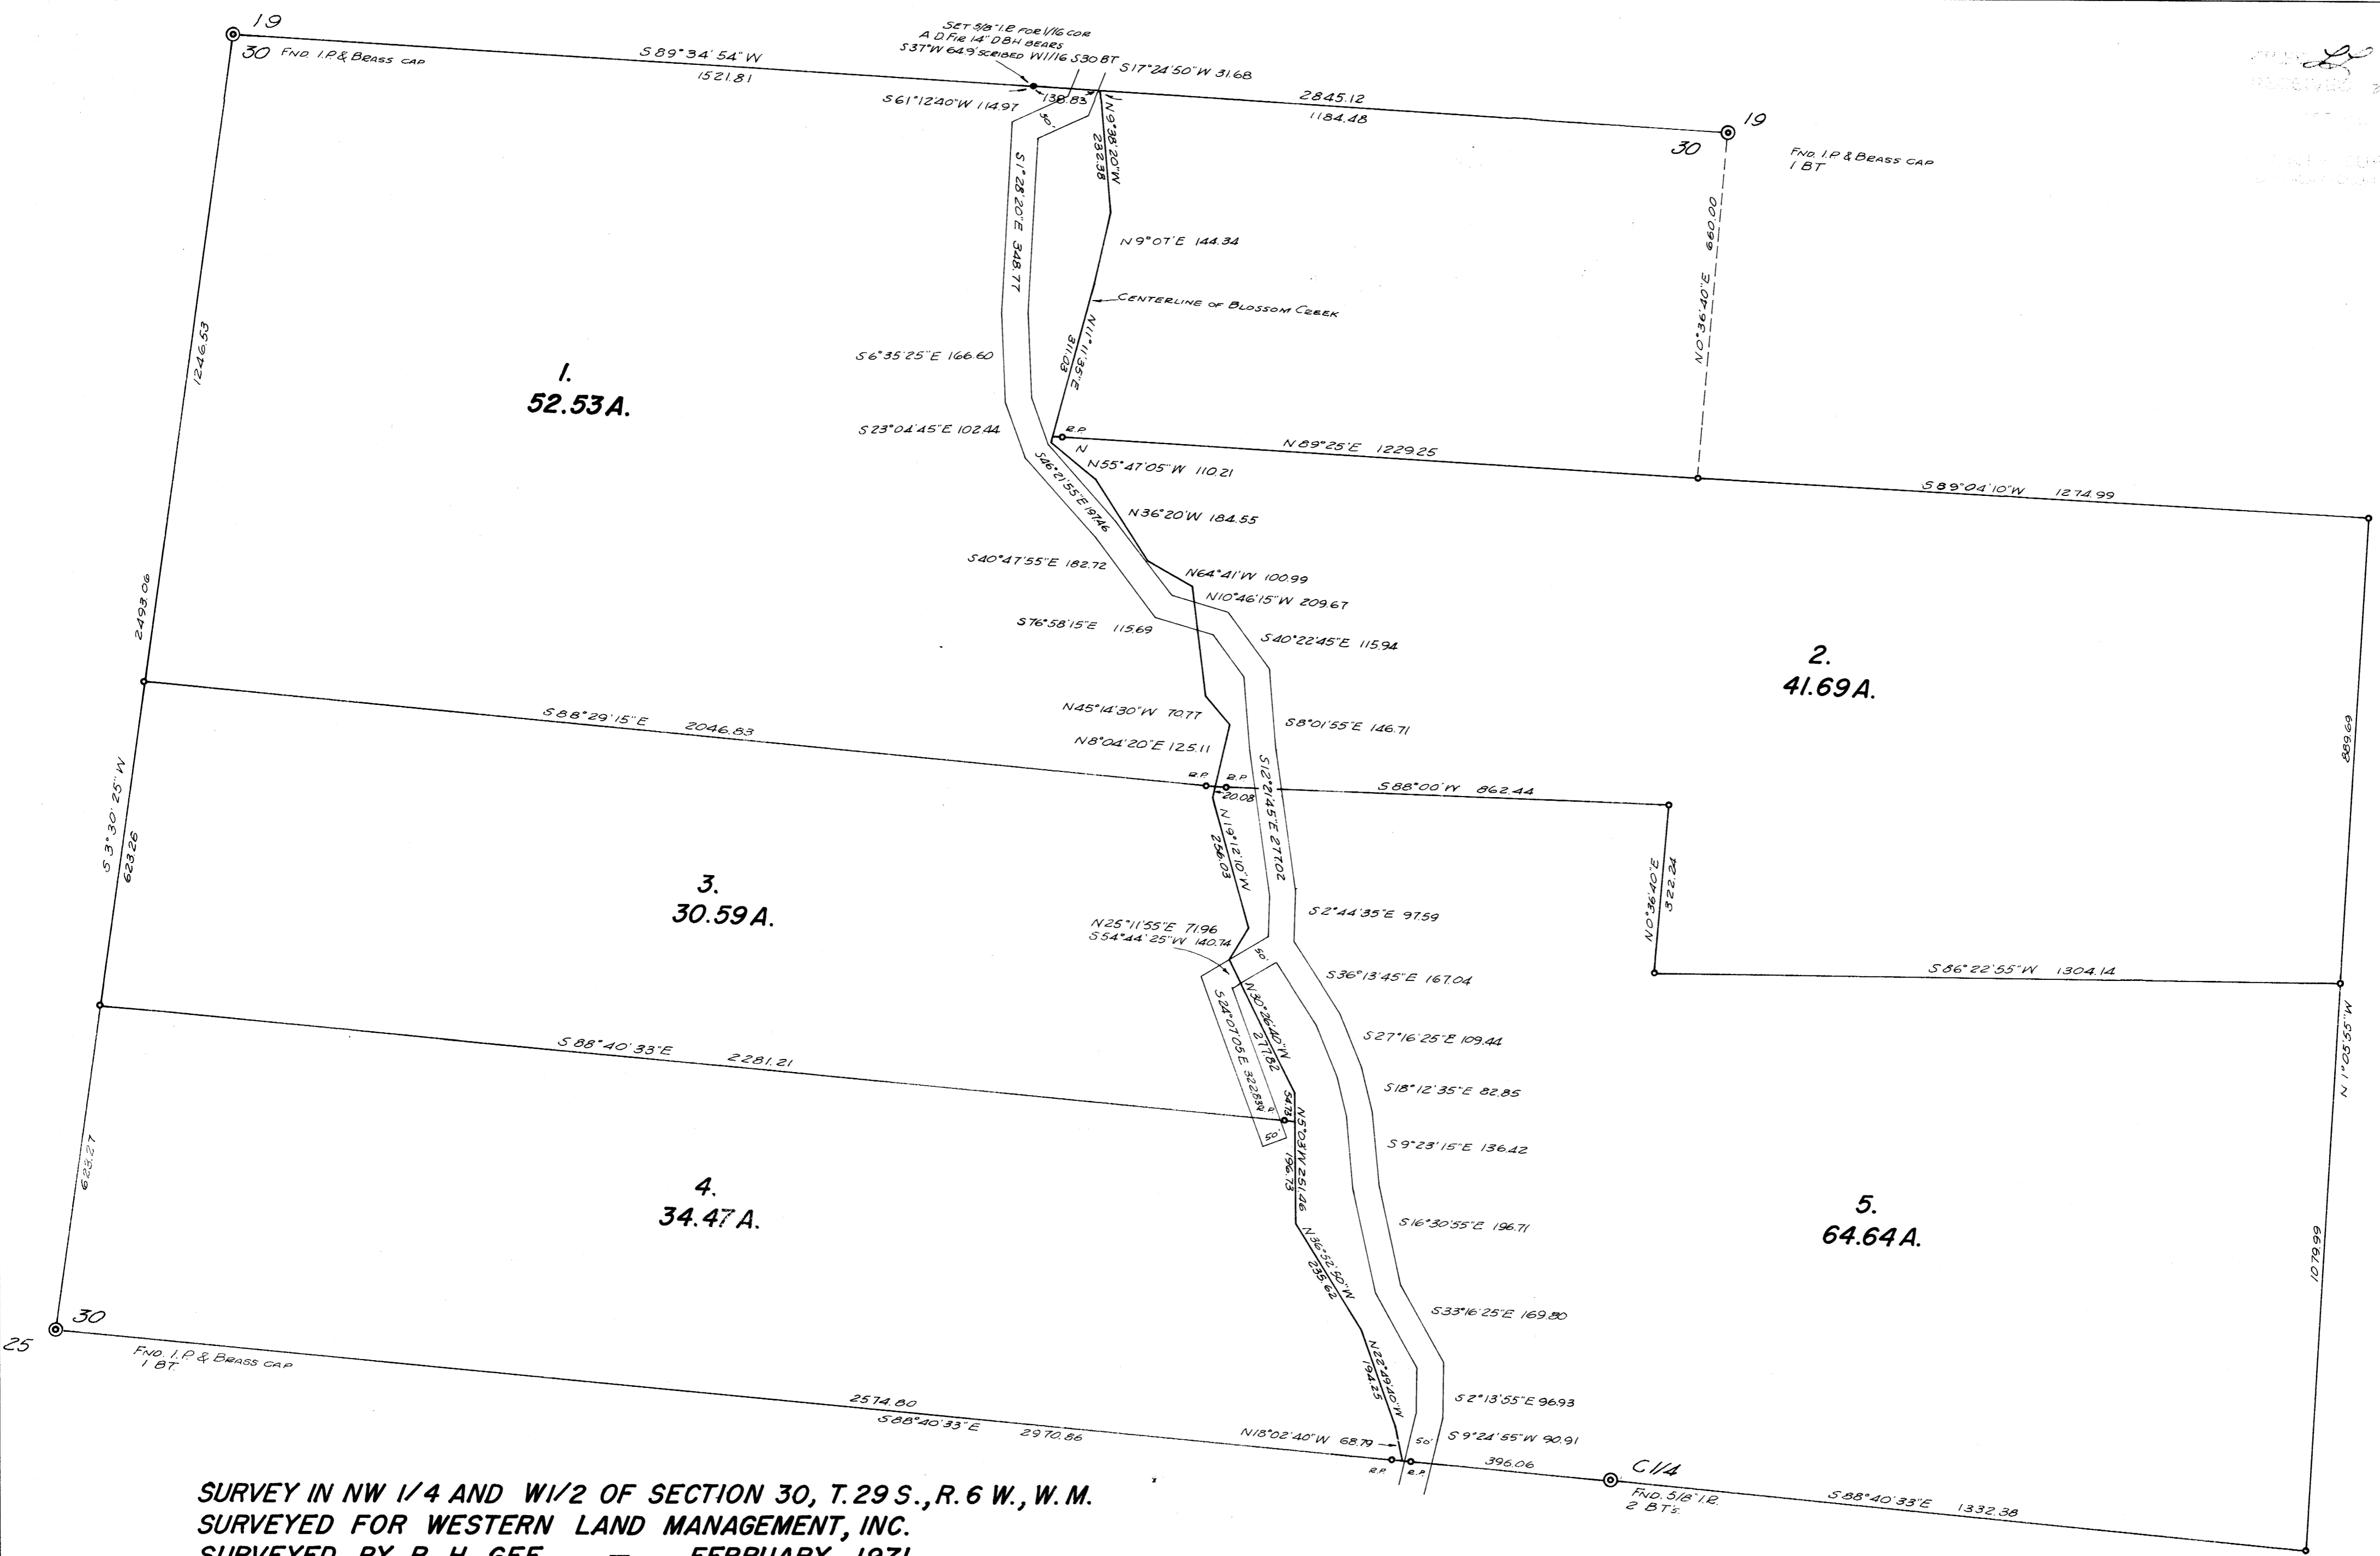

SURVEY IN NW 1/4 AND W 1/2 OF SECTION 30, T.29 S., R.6 W., W.M.  
 SURVEYED FOR WESTERN LAND MANAGEMENT, INC.  
 SURVEYED BY R. H. GEE — FEBRUARY, 1971  
 SCALE 1" = 200'

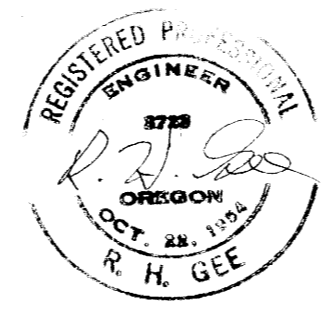

o DENOTES 5/8" I.R. SET  
 BEARINGS BASED ON C. S. FILE M 40-17

M 41-45