


COUNTY SURVEYORS FILE DATA
DO NOT REMOVE FROM OFFICE

SURVEY FOR DESCRIPTION IN SECTION 26, T.28 S., R.7W., W.M., DOUGLAS CO, ORE. FOR MAYNARD STUTZMAN & D.J. BOYD

BY HERBERT L. NORTHCRAFT

SCALE 1" = 100'

MAR. '71

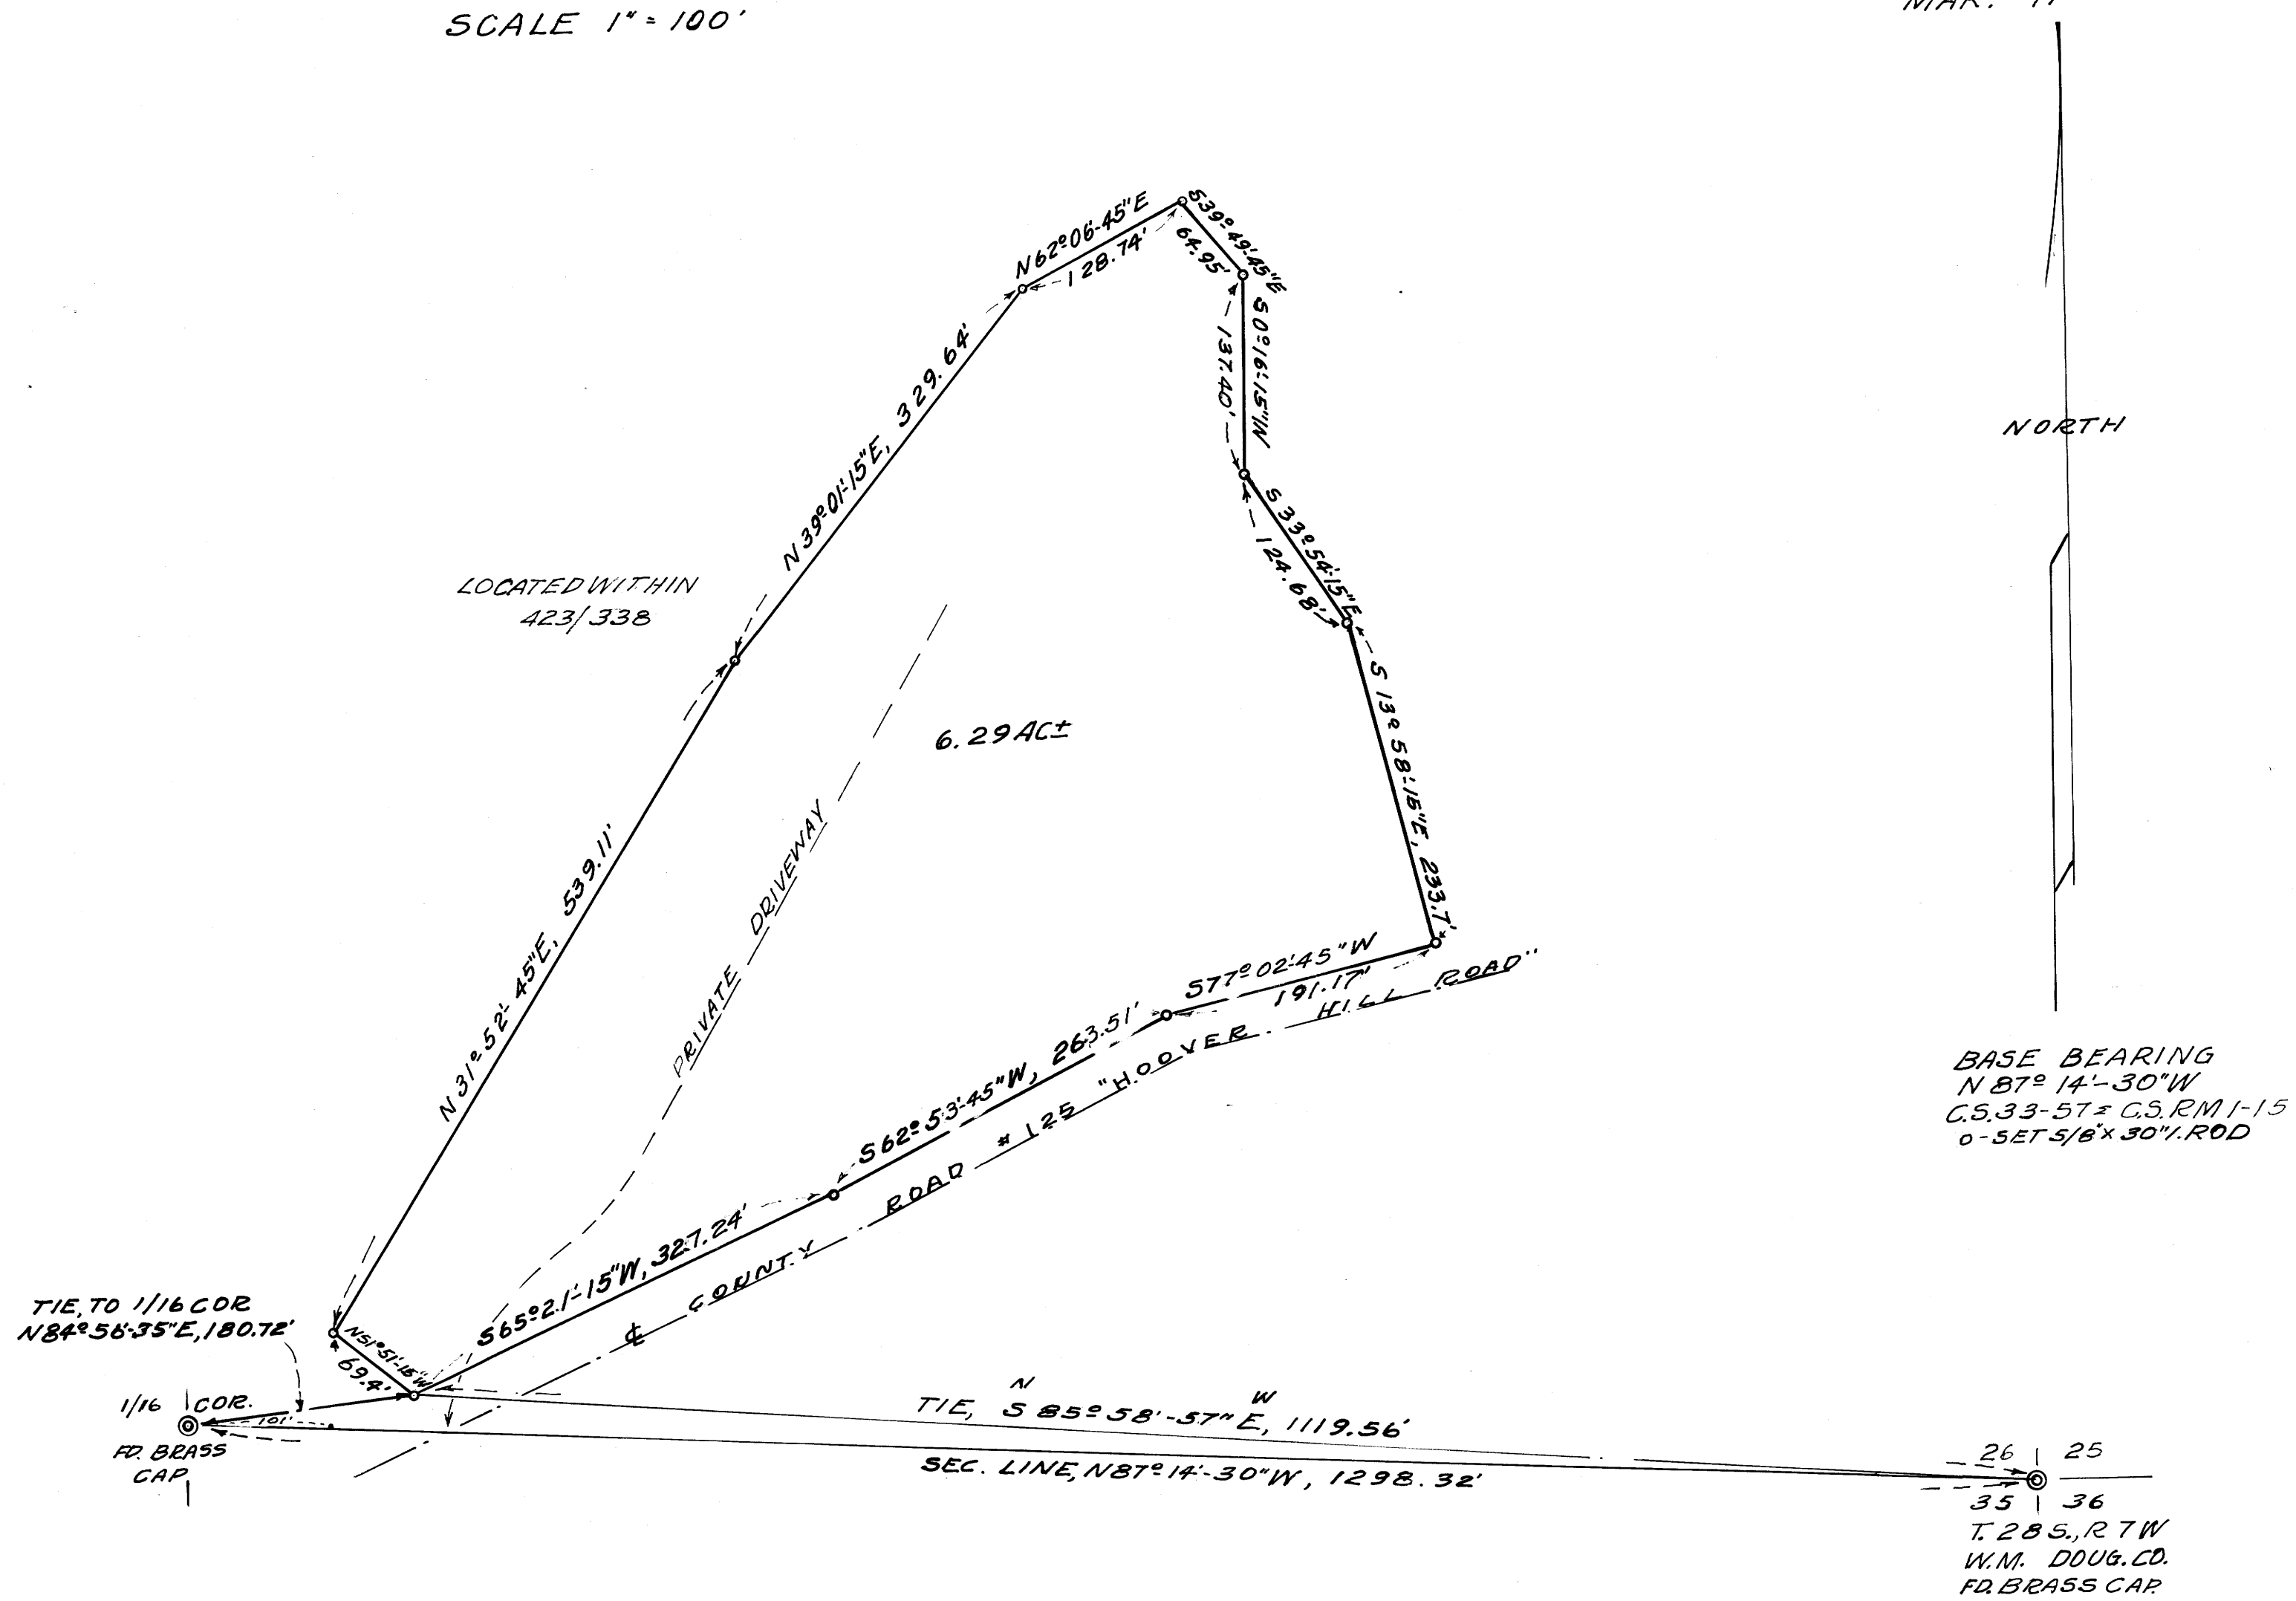

REGISTERED
OREGON
LAND SURVEYOR

Herbert L. Northcraft

JULY 8, 1966
HERBERT L. NORTHCRAFT
750

26 | 25
35 | 36
T. 28 S., R. 7 W.
W.M. DOUG. CO.
FR. BRASS CAP

41 - 46

M 41 - 46