


SURVEYED FOR PROPERTY DESCRIPTION
SITUATED IN T26S-R6W SEC 25
SURVEYED FOR ~ JOE WECKERLE

SURVEYED BY ~ BAUGHMAN SURVEYING

MARCH 1971

COUNTY SURVEYORS FILE DATA
DO NOT REMOVE FROM OFFICE

SL

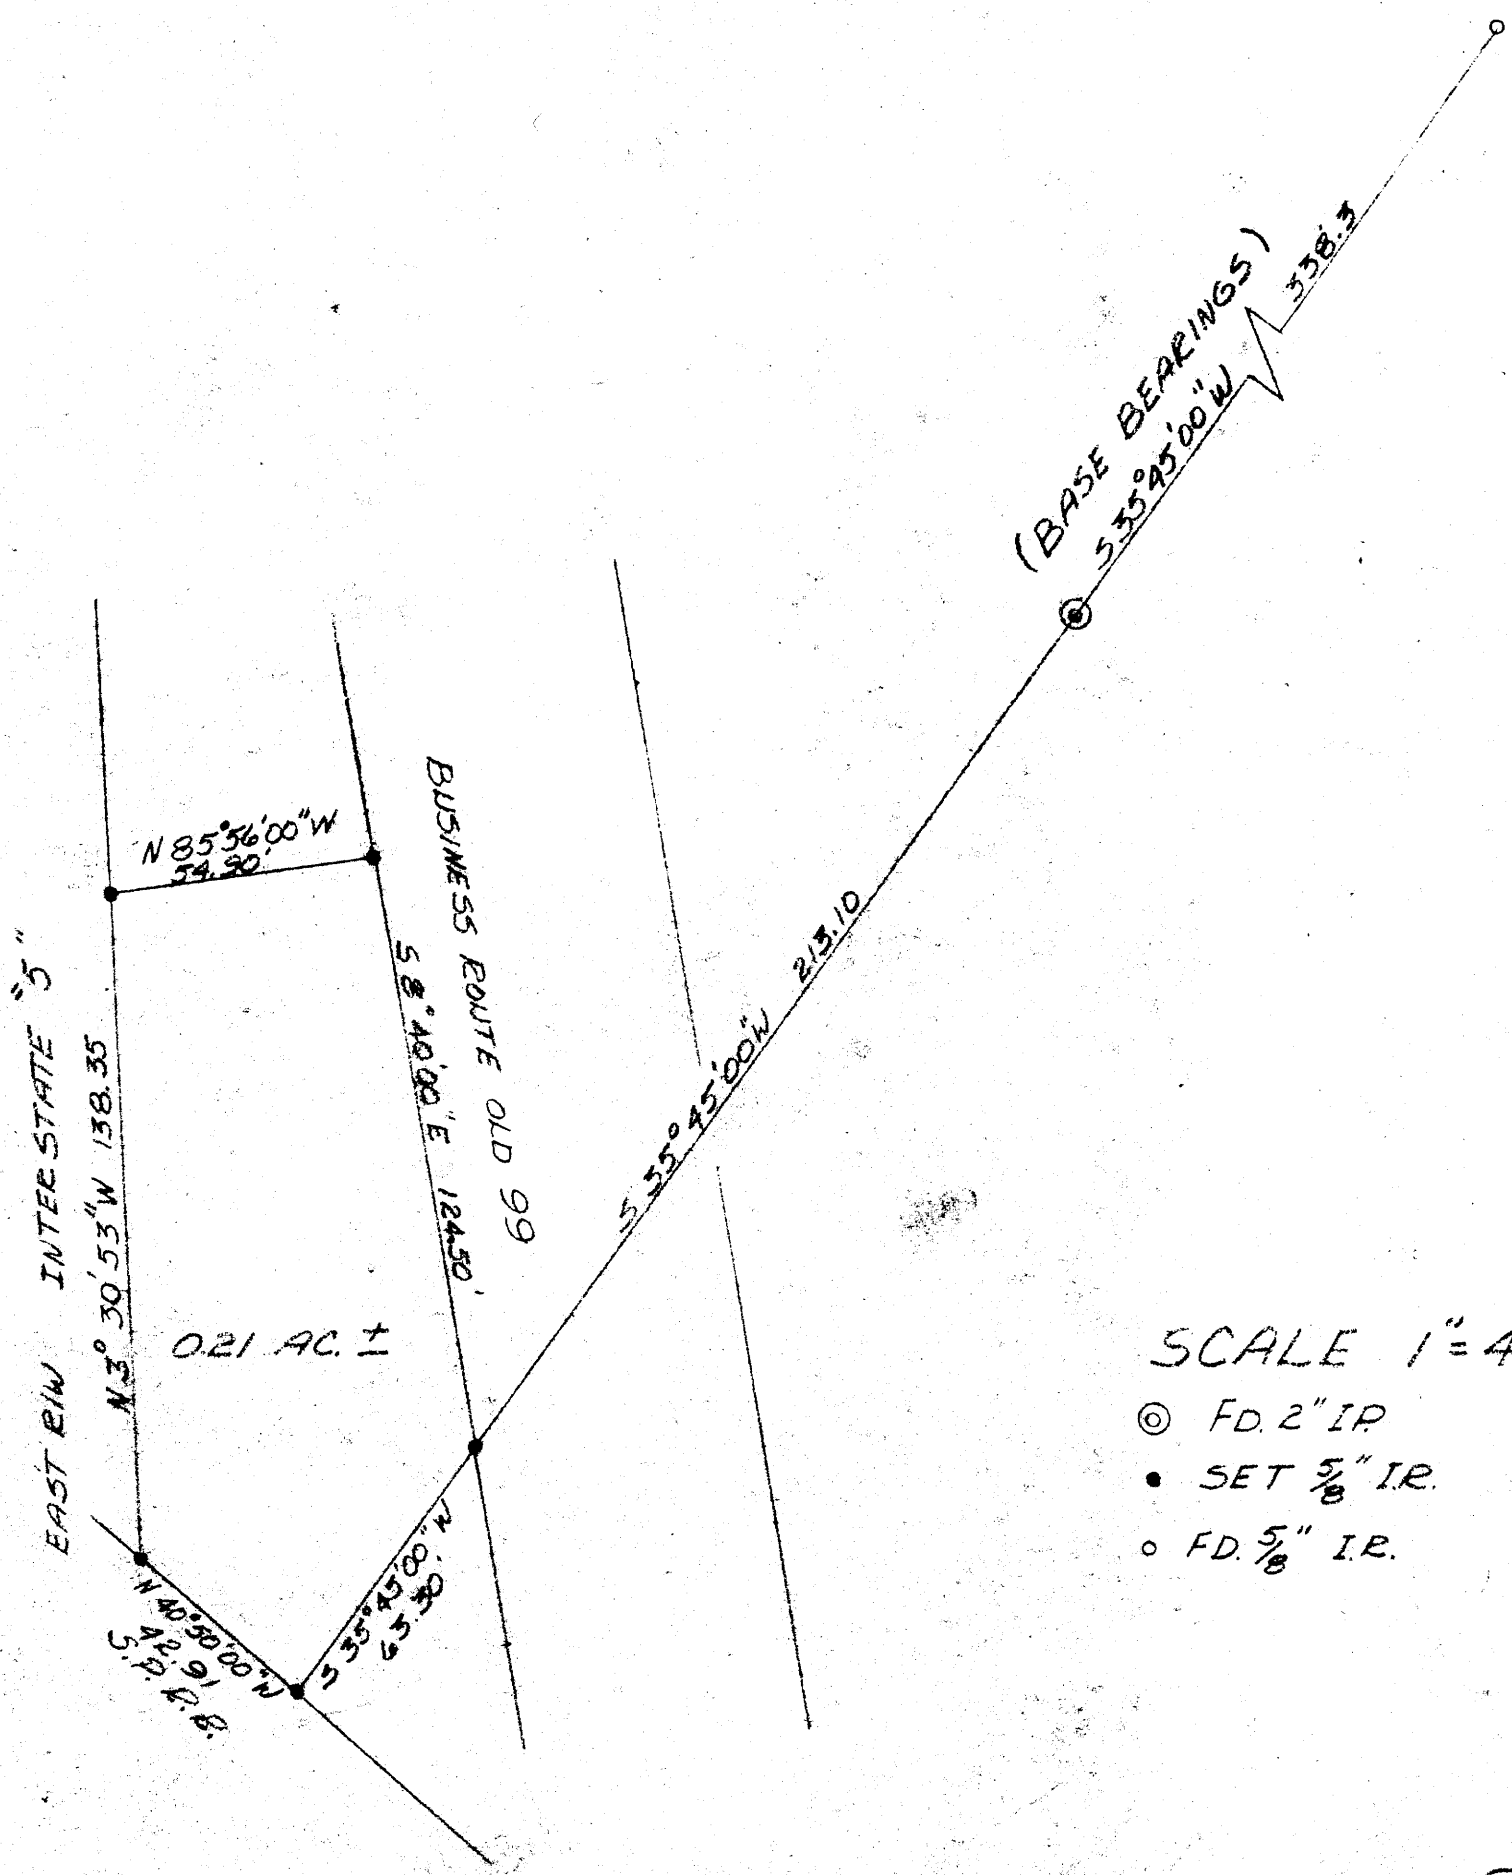

SCALE 1" = 40'

- ⊙ FD. 2" I.R.
- SET 5/8" I.R.
- FD. 5/8" I.R.

REGISTERED
OREGON
LAND SURVEYOR

Glenn S. Baughman

JULY 14, 1961
GLENN S. BAUGHMAN
536