


FILED  
RECEIVED  
JUL 17 1948  
COUNTY SURVEYOR  
POLK COUNTY, ORE.

SECT. 31, T22 S., R.7 W. W.M.

Robert Schulz EIRTON, OREG.

REGISTERED  
OREGON  
LAND SURVEYOR  
*Wilford N. Haines*  
MAY 7, 1948  
WILFORD N. HAINES  
239

North  
1" = 50'

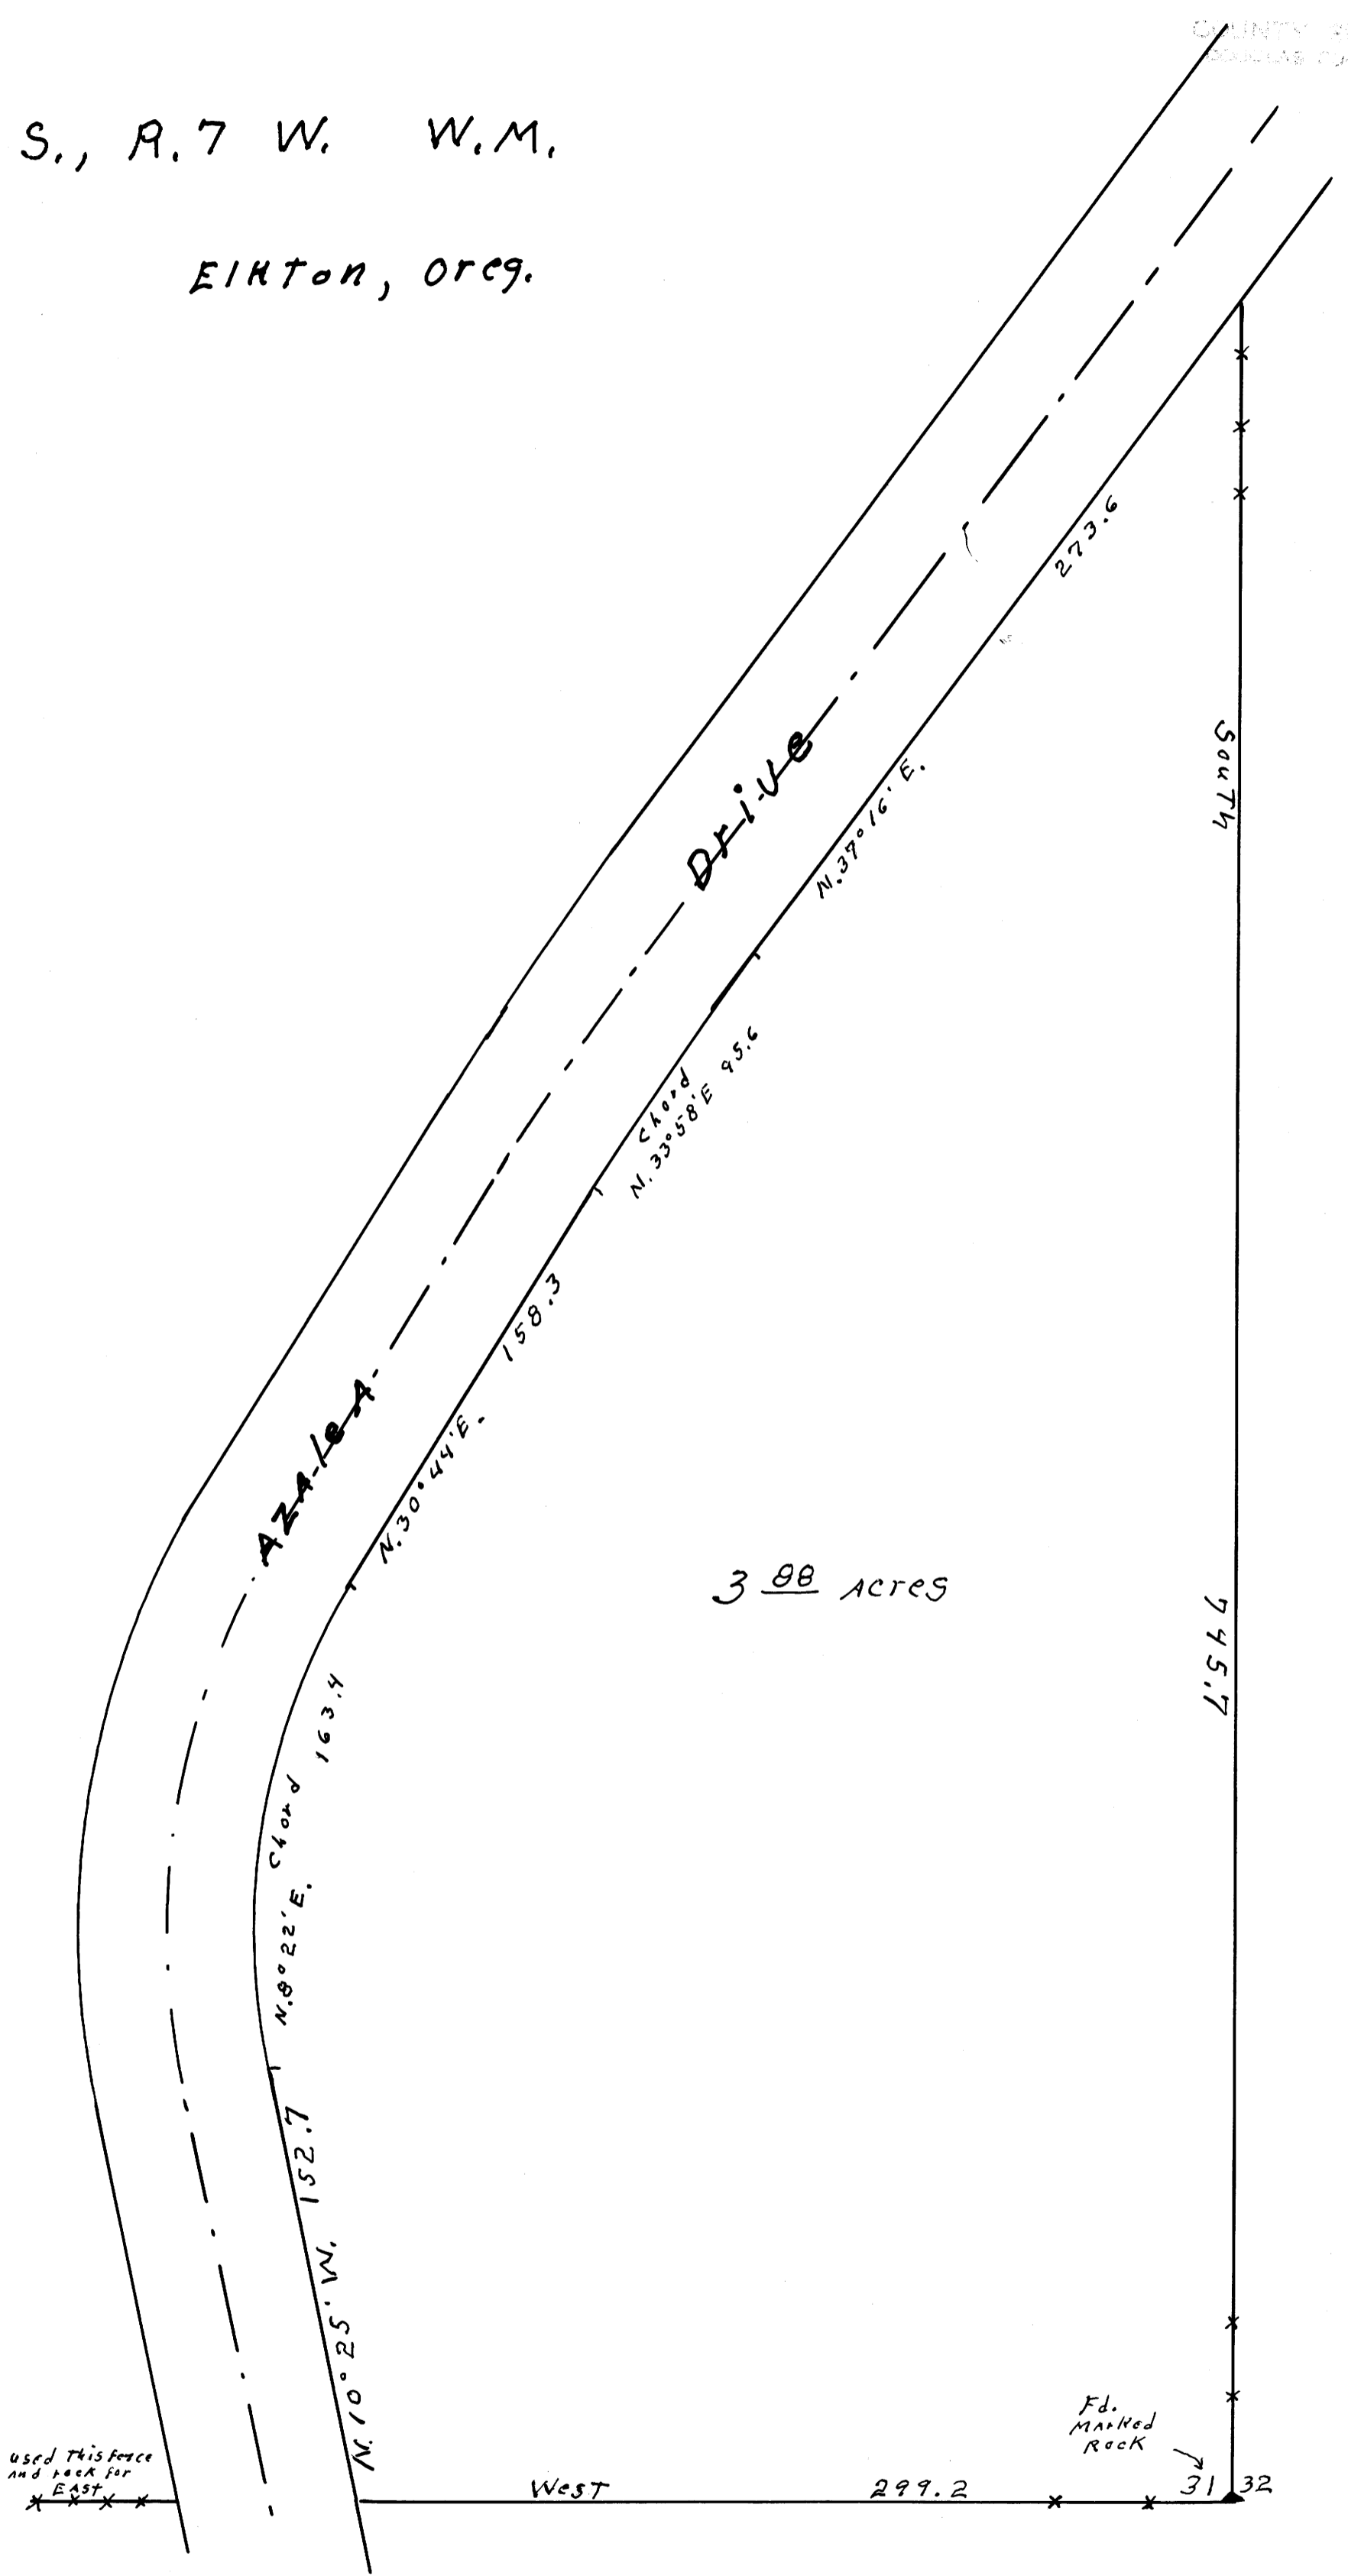

3.88 ACRES