


COUNTY SURVEYORS FILE DATA
DO NOT REMOVE FROM OFFICE

SURVEY OF J.A. DRYER'S DLC #41
IN SECTION 19 & 20, T. 29 S., R. 8 W., W.M., DOUGLAS CO, ORE.
FOR NEAL BROWN
OCT. 1970
SURVEY BY HERBERT L. NORTHGRAFT
SCALE 1" = 200 FT.

FILED
RECEIVED
DEC 30 1971
COUNTY SURVEYOR
DOUGLAS COUNTY, ORE.

M 42 - 13

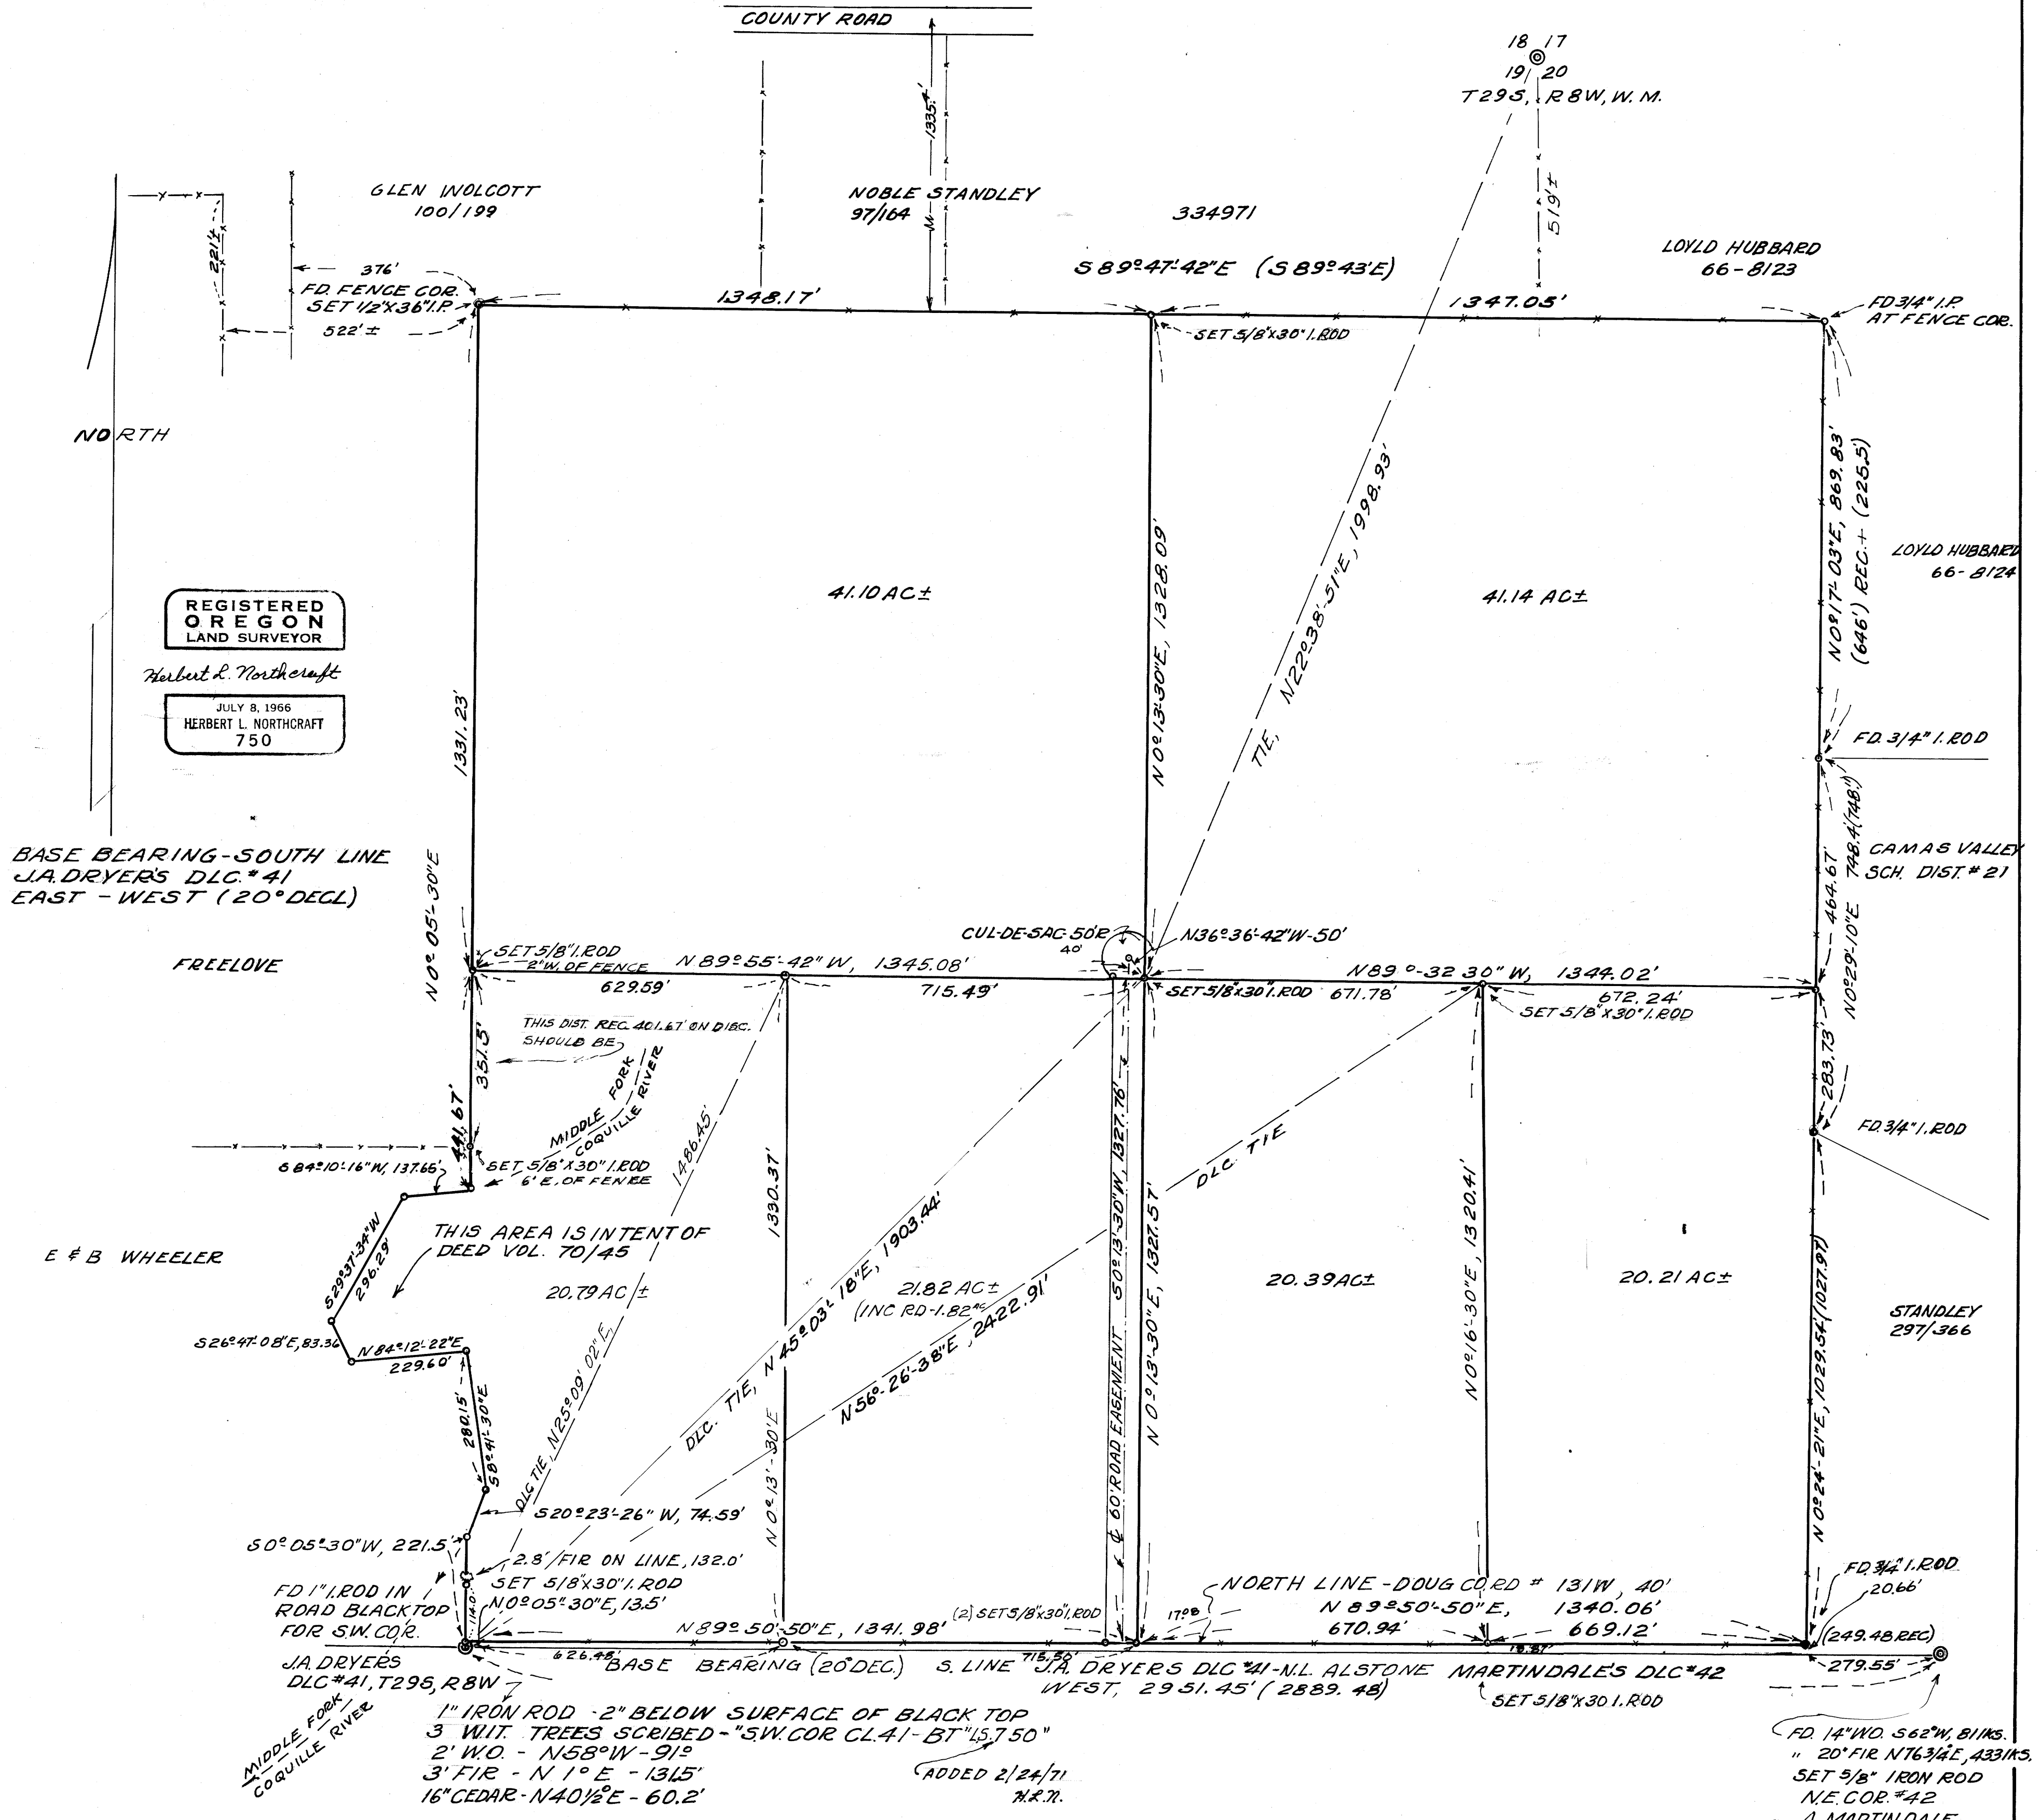

REGISTERED
OREGON
LAND SURVEYOR
Herbert L. Northcraft
JULY 8, 1966
HERBERT L. NORTHGRAFT
750

BASE BEARING-SOUTH LINE
J.A. DRYER'S DLC #41
EAST - WEST (20° DECL)

FRELOVE

E & B WHEELER

J.A. DRYER'S
DLC #41, T29S, R8W

MIDDLE FORK
COQUILLE RIVER

1" IRON ROD - 2" BELOW SURFACE OF BLACK TOP
3 WIT. TREES SCRIBED - "SW COR CL 41 - BT" 45.750"
2' W.O. - N58°W - 91°
3' FIR - N 1° E - 131.5'
16" CEDAR - N40 1/2° E - 60.2'
ADDED 2/24/71
H.R.T.

FD 14" W.O. 562' W, 811' N.
" 20" FIR N76 3/4° E, 433' N.S.
SET 5/8" IRON ROD
N.E. COR. #42
A. MARTINDALE
DLC

COUNTY SURVEYORS FILE DATA
DO NOT REMOVE FROM OFFICE

M 42 - 13