
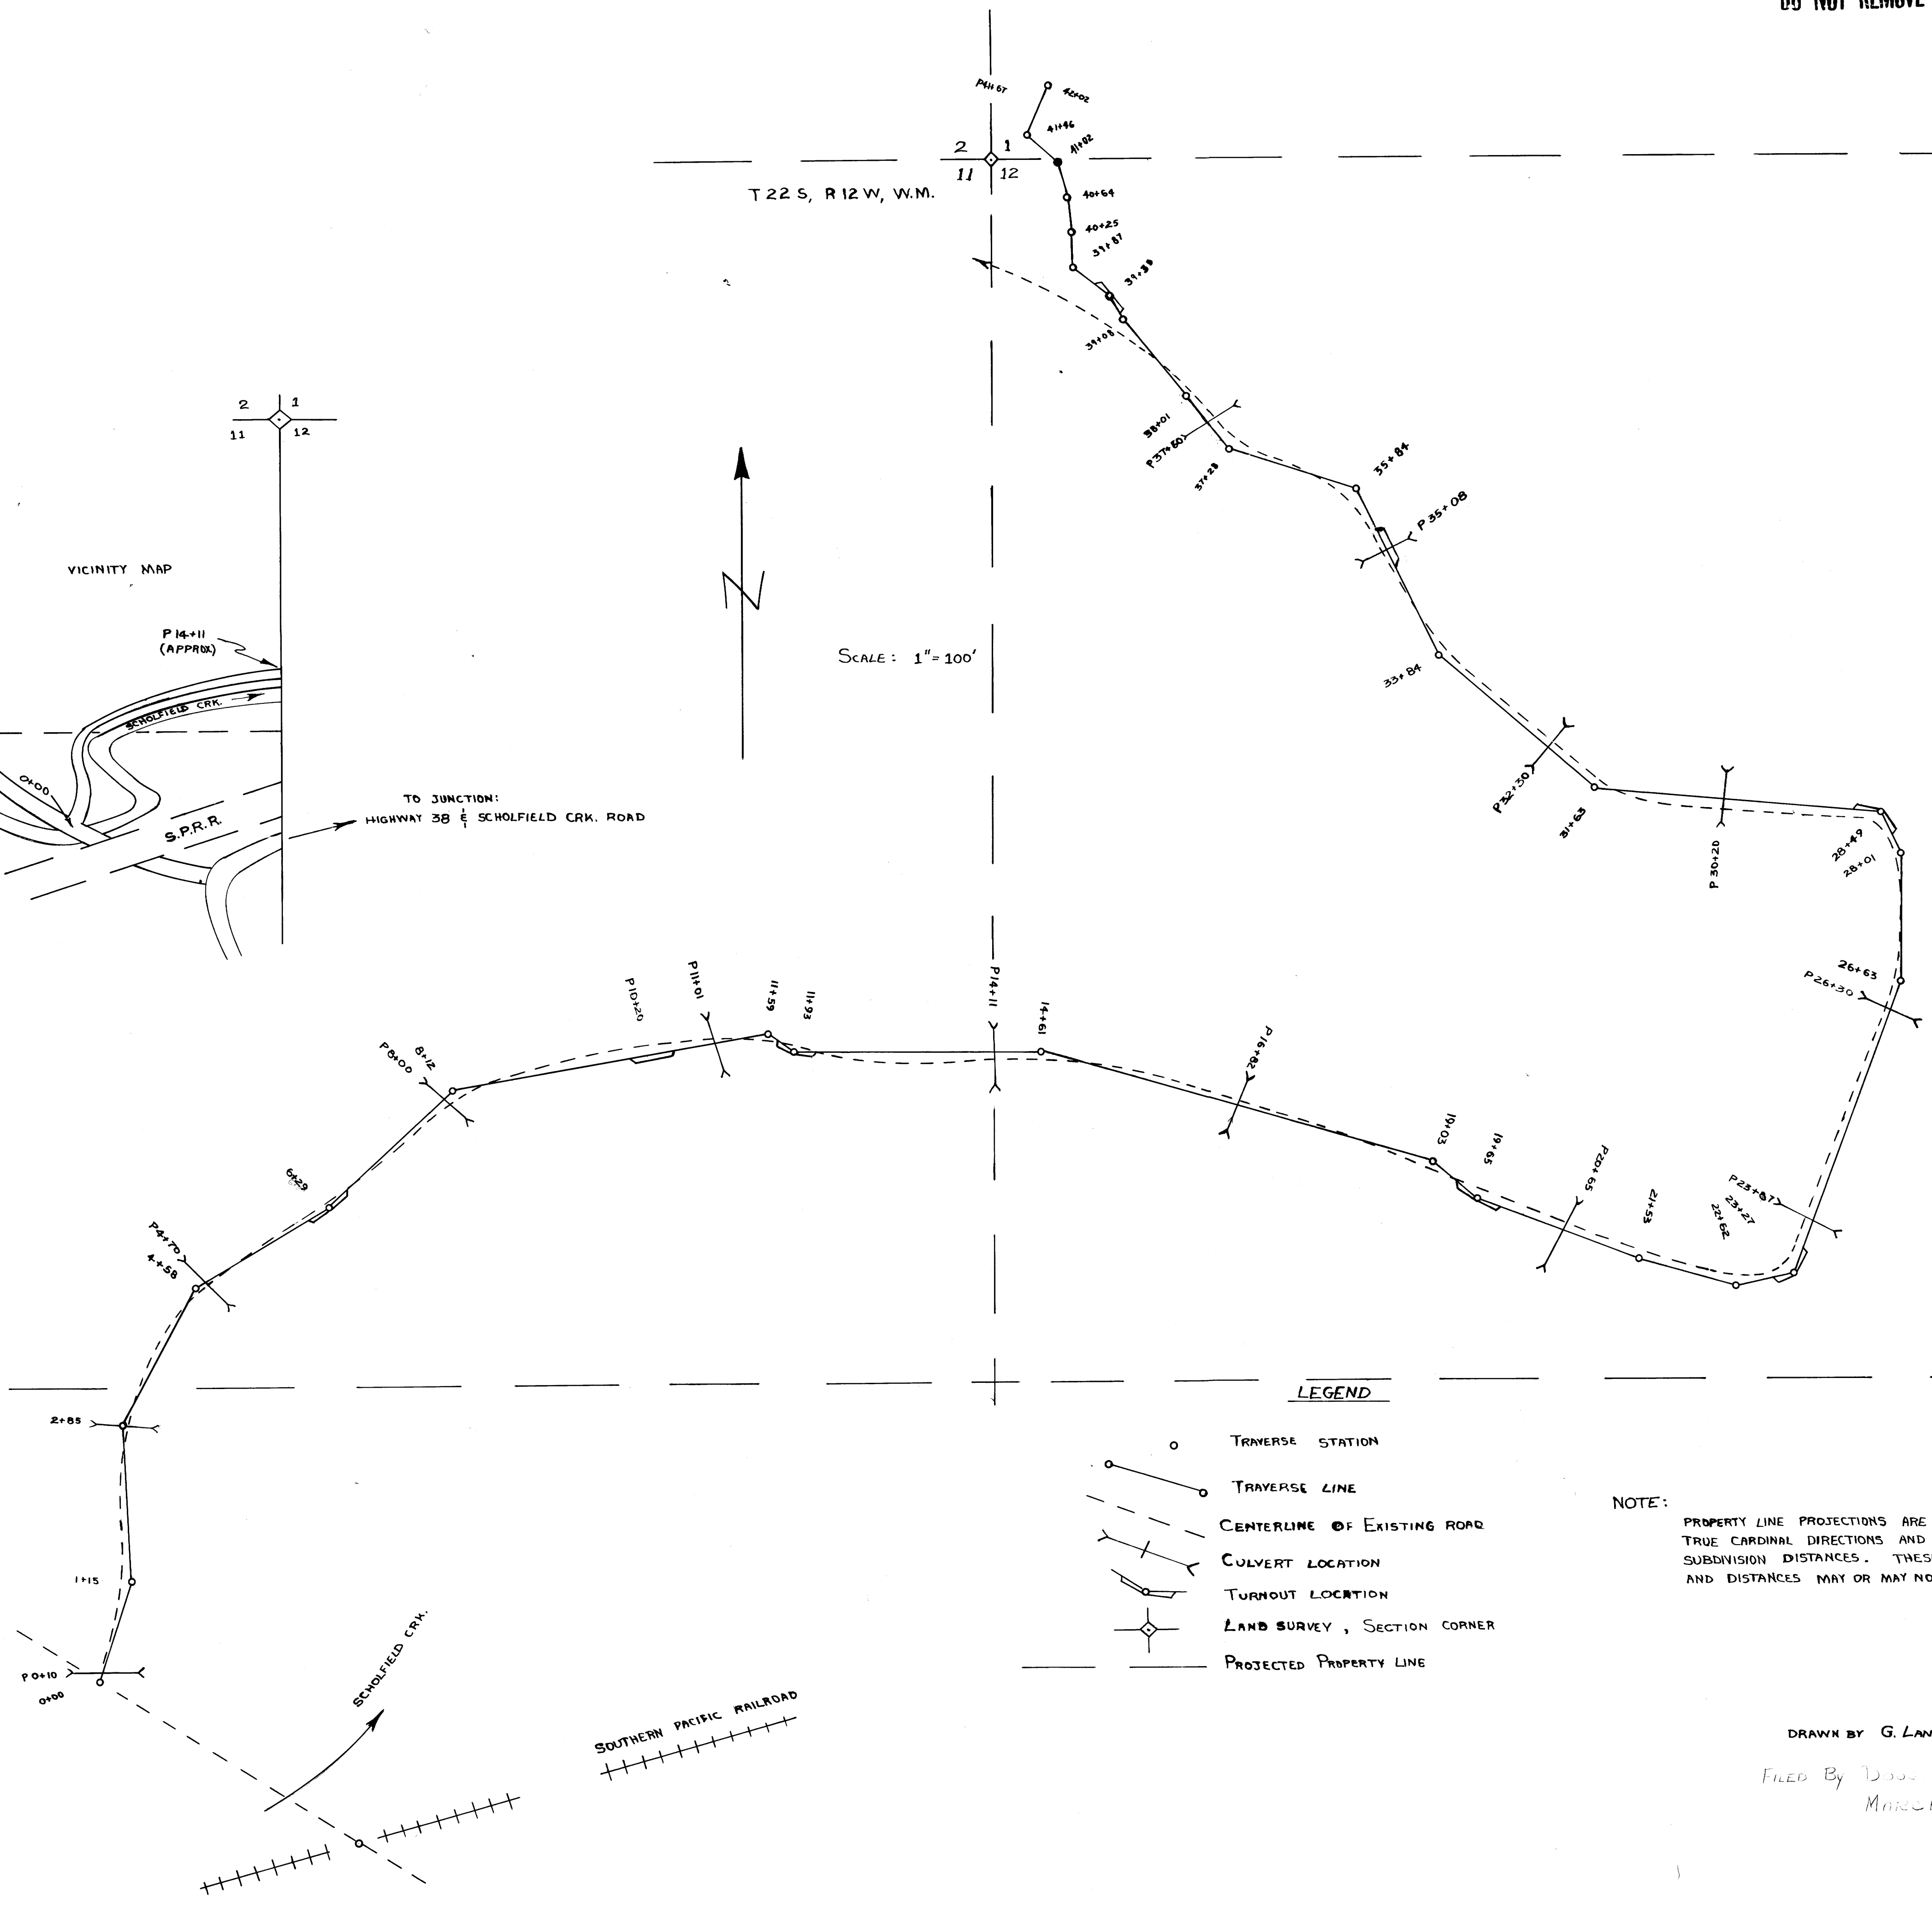


T 22 S, R 12 W, W.M.

SCALE: 1" = 100'

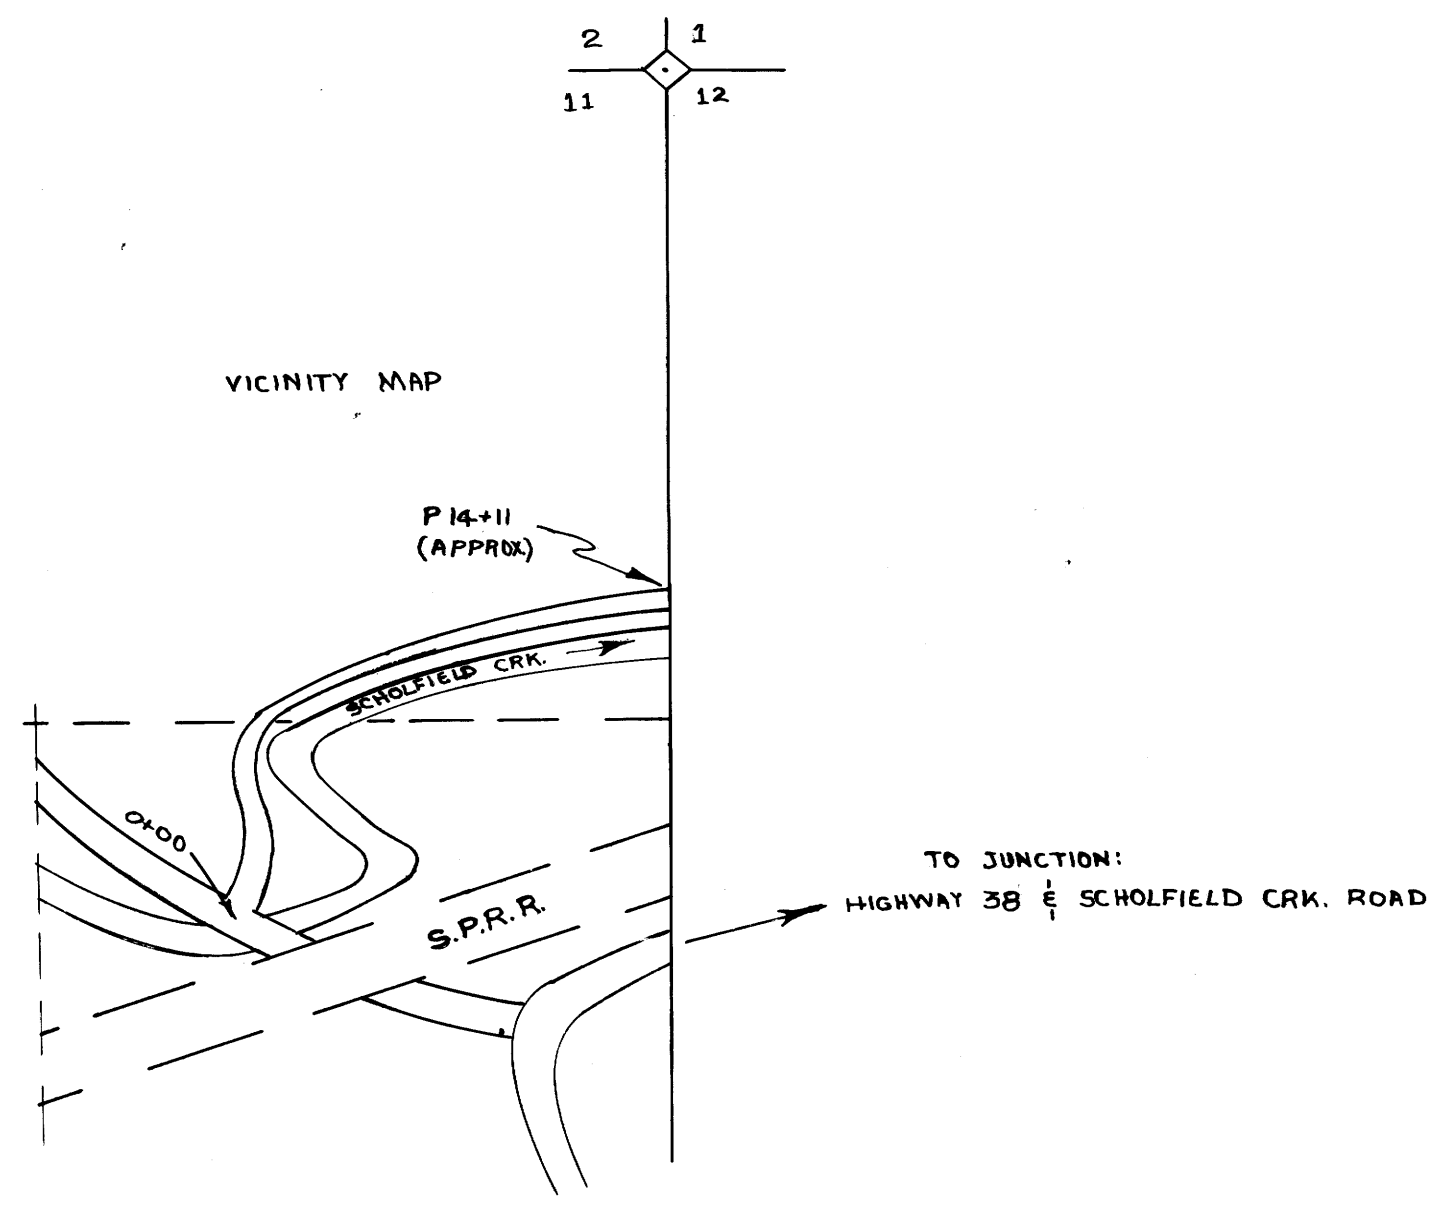

LEGEND

- TRAVERSE STATION
- TRAVERSE LINE
- - - CENTERLINE OF EXISTING ROAD
- |-|-| CULVERT LOCATION
- |-|-| TURNOUT LOCATION
- ◆ LAND SURVEY, SECTION CORNER
- - - PROJECTED PROPERTY LINE

NOTE:
PROPERTY LINE PROJECTIONS ARE BASED UPON TRUE CARDINAL DIRECTIONS AND STANDARD SUBDIVISION DISTANCES. THESE DIRECTIONS AND DISTANCES MAY OR MAY NOT BE CORRECT.

DRAWN BY G. LANGLITZ

FILED BY D. J. COLEMAN DEPT.
MARCH 4, 1971