
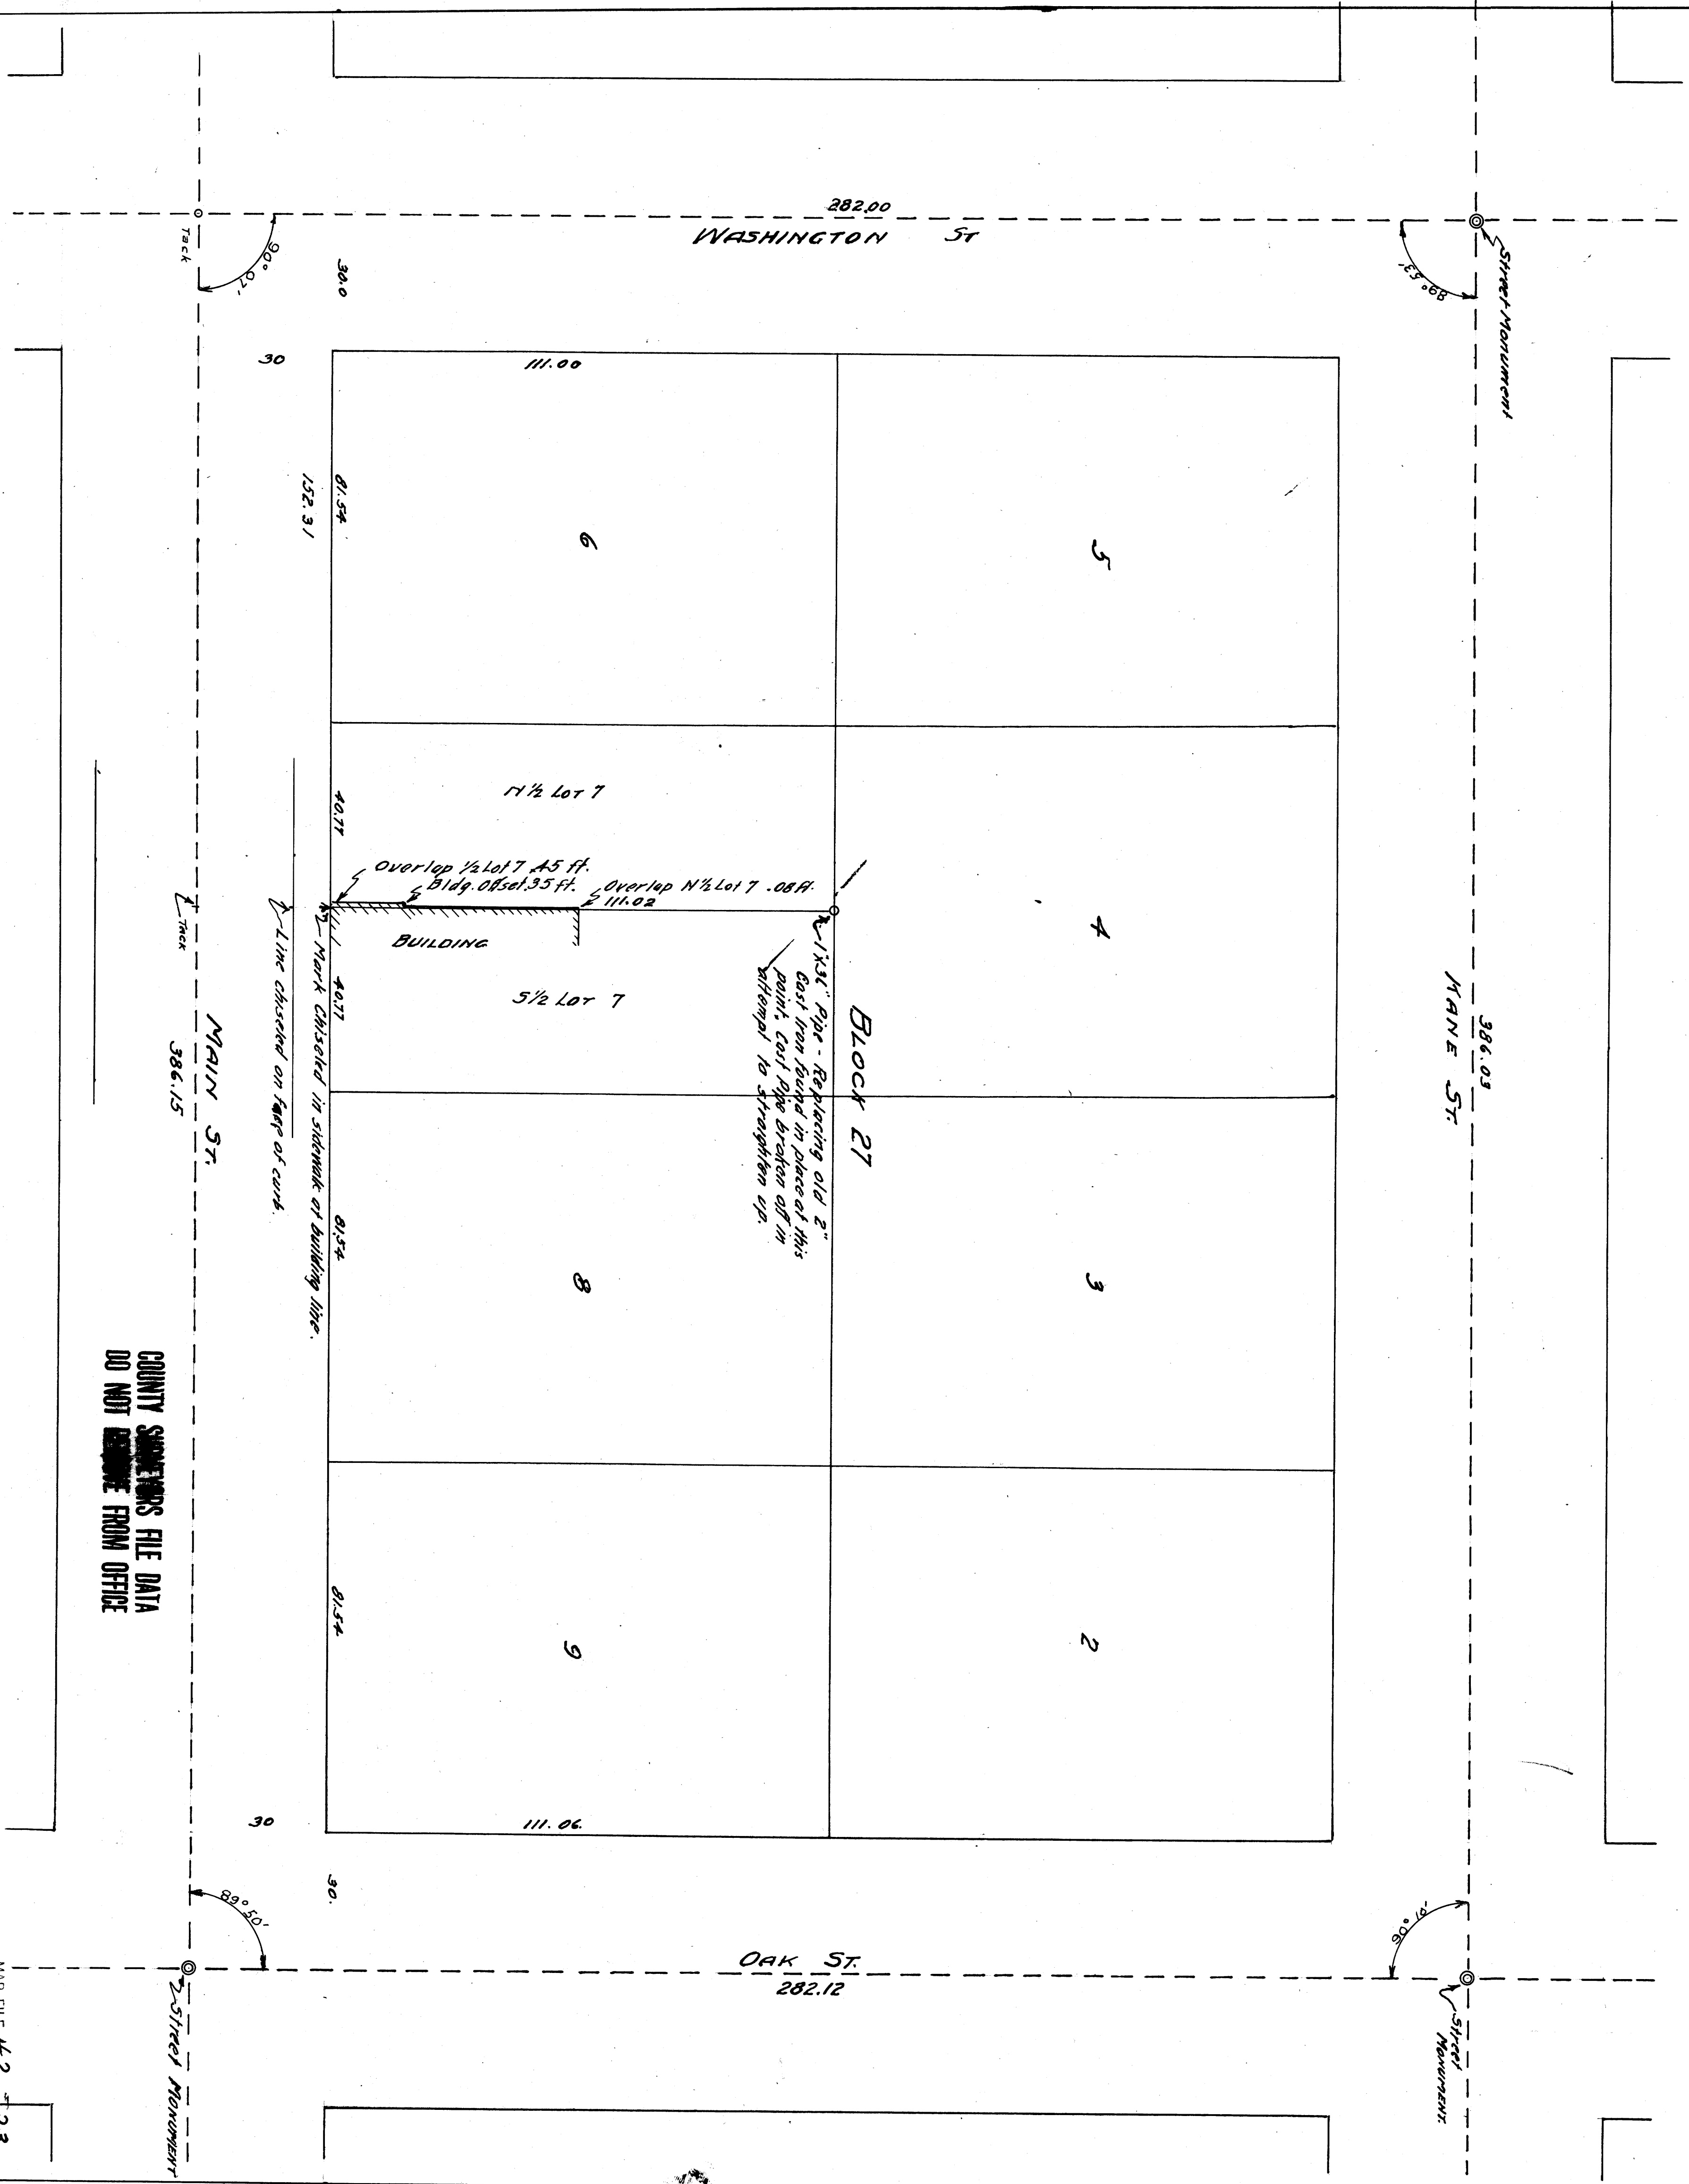


COUNTY SURVEYORS FILE DATA  
DO NOT REMOVE FROM OFFICE

COUNTY SURVEYORS OFFICE  
DOUGLAS COUNTY OREGON

LINE BETWEEN NORTH & SOUTH HALF  
LOT 7 BLOCK 27, EISENBURG,  
OREGON.

BEN B. IRVING COUNTY SURVEYOR  
Surveyed 12-20-45 by  
N.E. RICHARDSON DEPUTY  
SCALE 1" = 20'

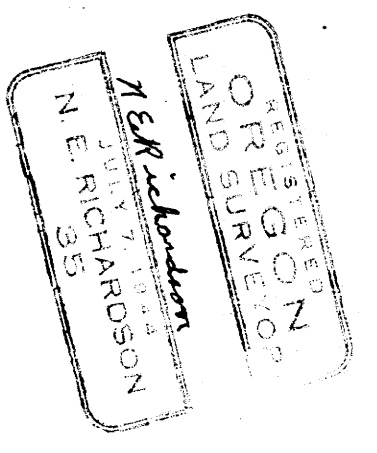

COUNTY SURVEYORS FILE DATA  
DO NOT REMOVE FROM OFFICE