

COUNTY SURVEYORS FILE DATA  
DO NOT REMOVE FROM OFFICE


FILED *SH*  
RECEIVED

JUN 27 1971


COUNTY SURVEYOR  
WASCO COUNTY, ORE

### SURVEY FOR DEED DESCRIPTION

### T26S, R4W, Sec. 17 & 18 W.M.

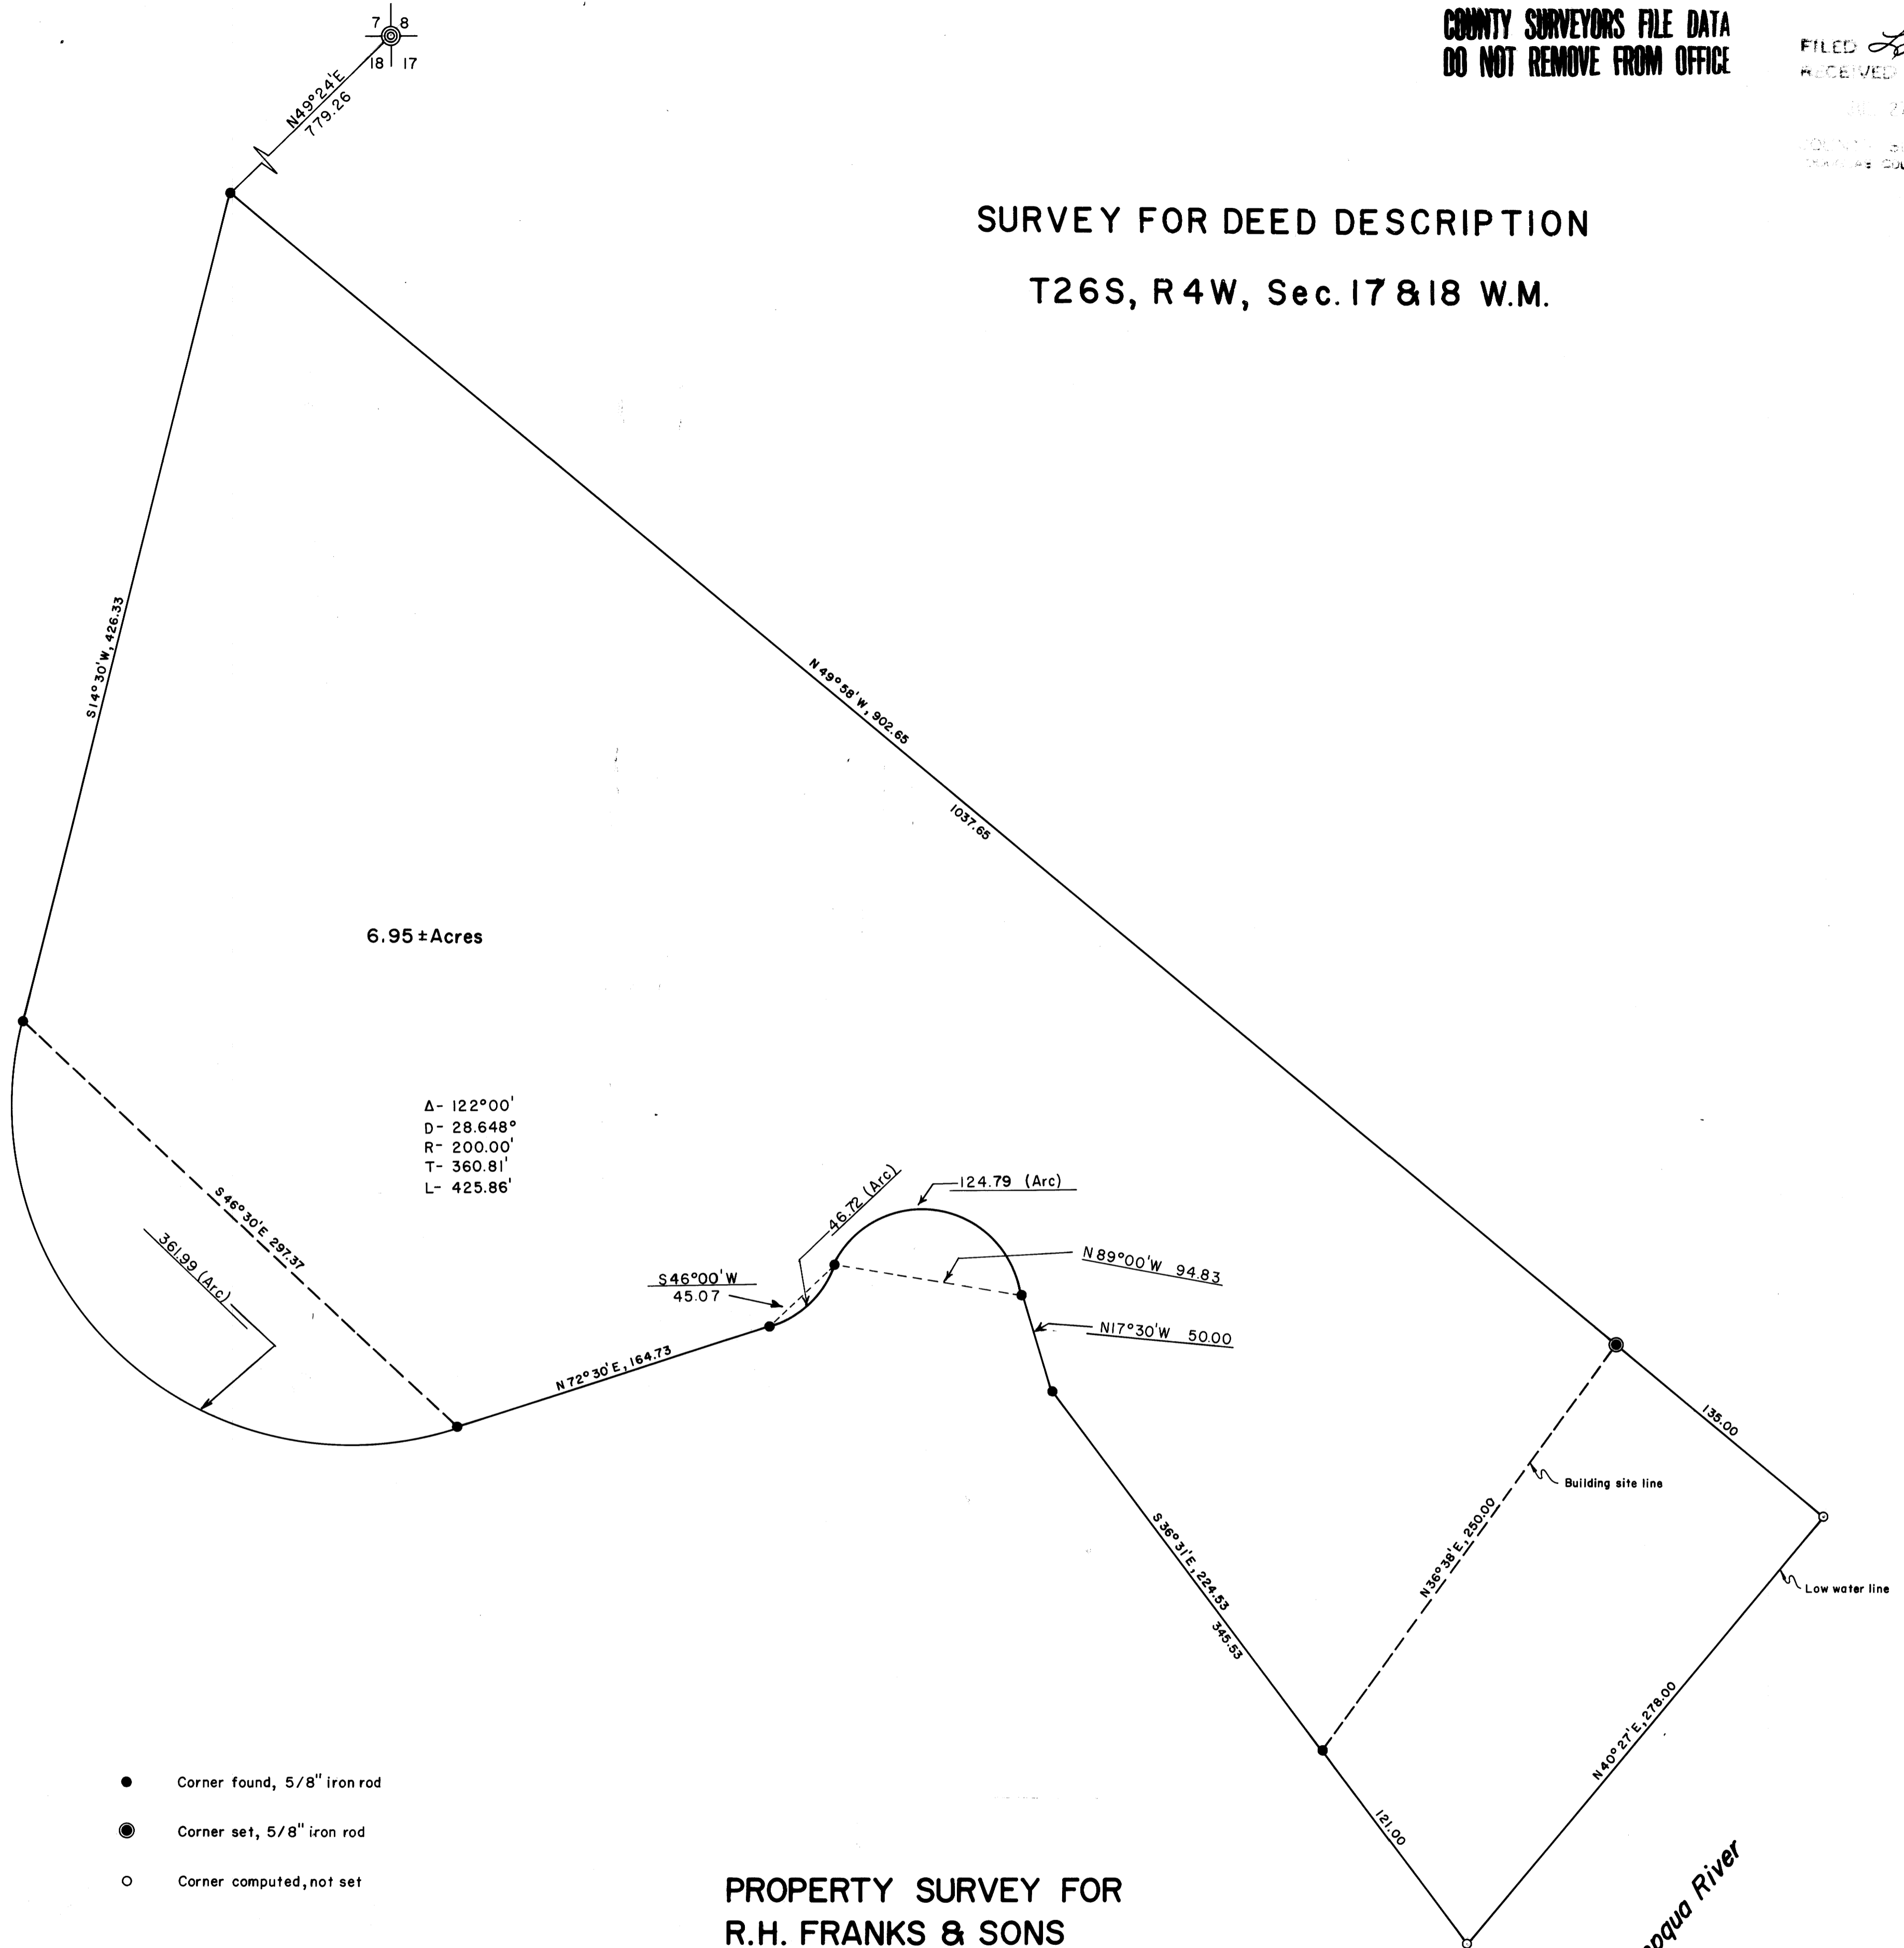

- Corner found, 5/8" iron rod
- ⊙ Corner set, 5/8" iron rod
- Corner computed, not set

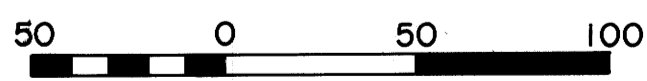

Scale: 1" = 50'

### PROPERTY SURVEY FOR R.H. FRANKS & SONS

Surveyed by Dick Grant  
 June 17, 1971  
 T26S R4W



COUNTY SURVEYORS FILE DATA  
DO NOT REMOVE FROM OFFICE