


SURVEY FOR DEED DESCRIPTION LOCATED IN SEC. 15, T. 23 S., R. 6 W. W.M. SURVEY FOR MR. & MRS. P. W. WOODCOCK SURVEY BY BAUGHMAN SURVEYING SERVICE

Scale 1" = 100'

DECEMBER, 1971

REGISTERED
OREGON
LAND SURVEYOR
Glenn S. Baughman
JULY 14, 1961
GLENN S. BAUGHMAN
536

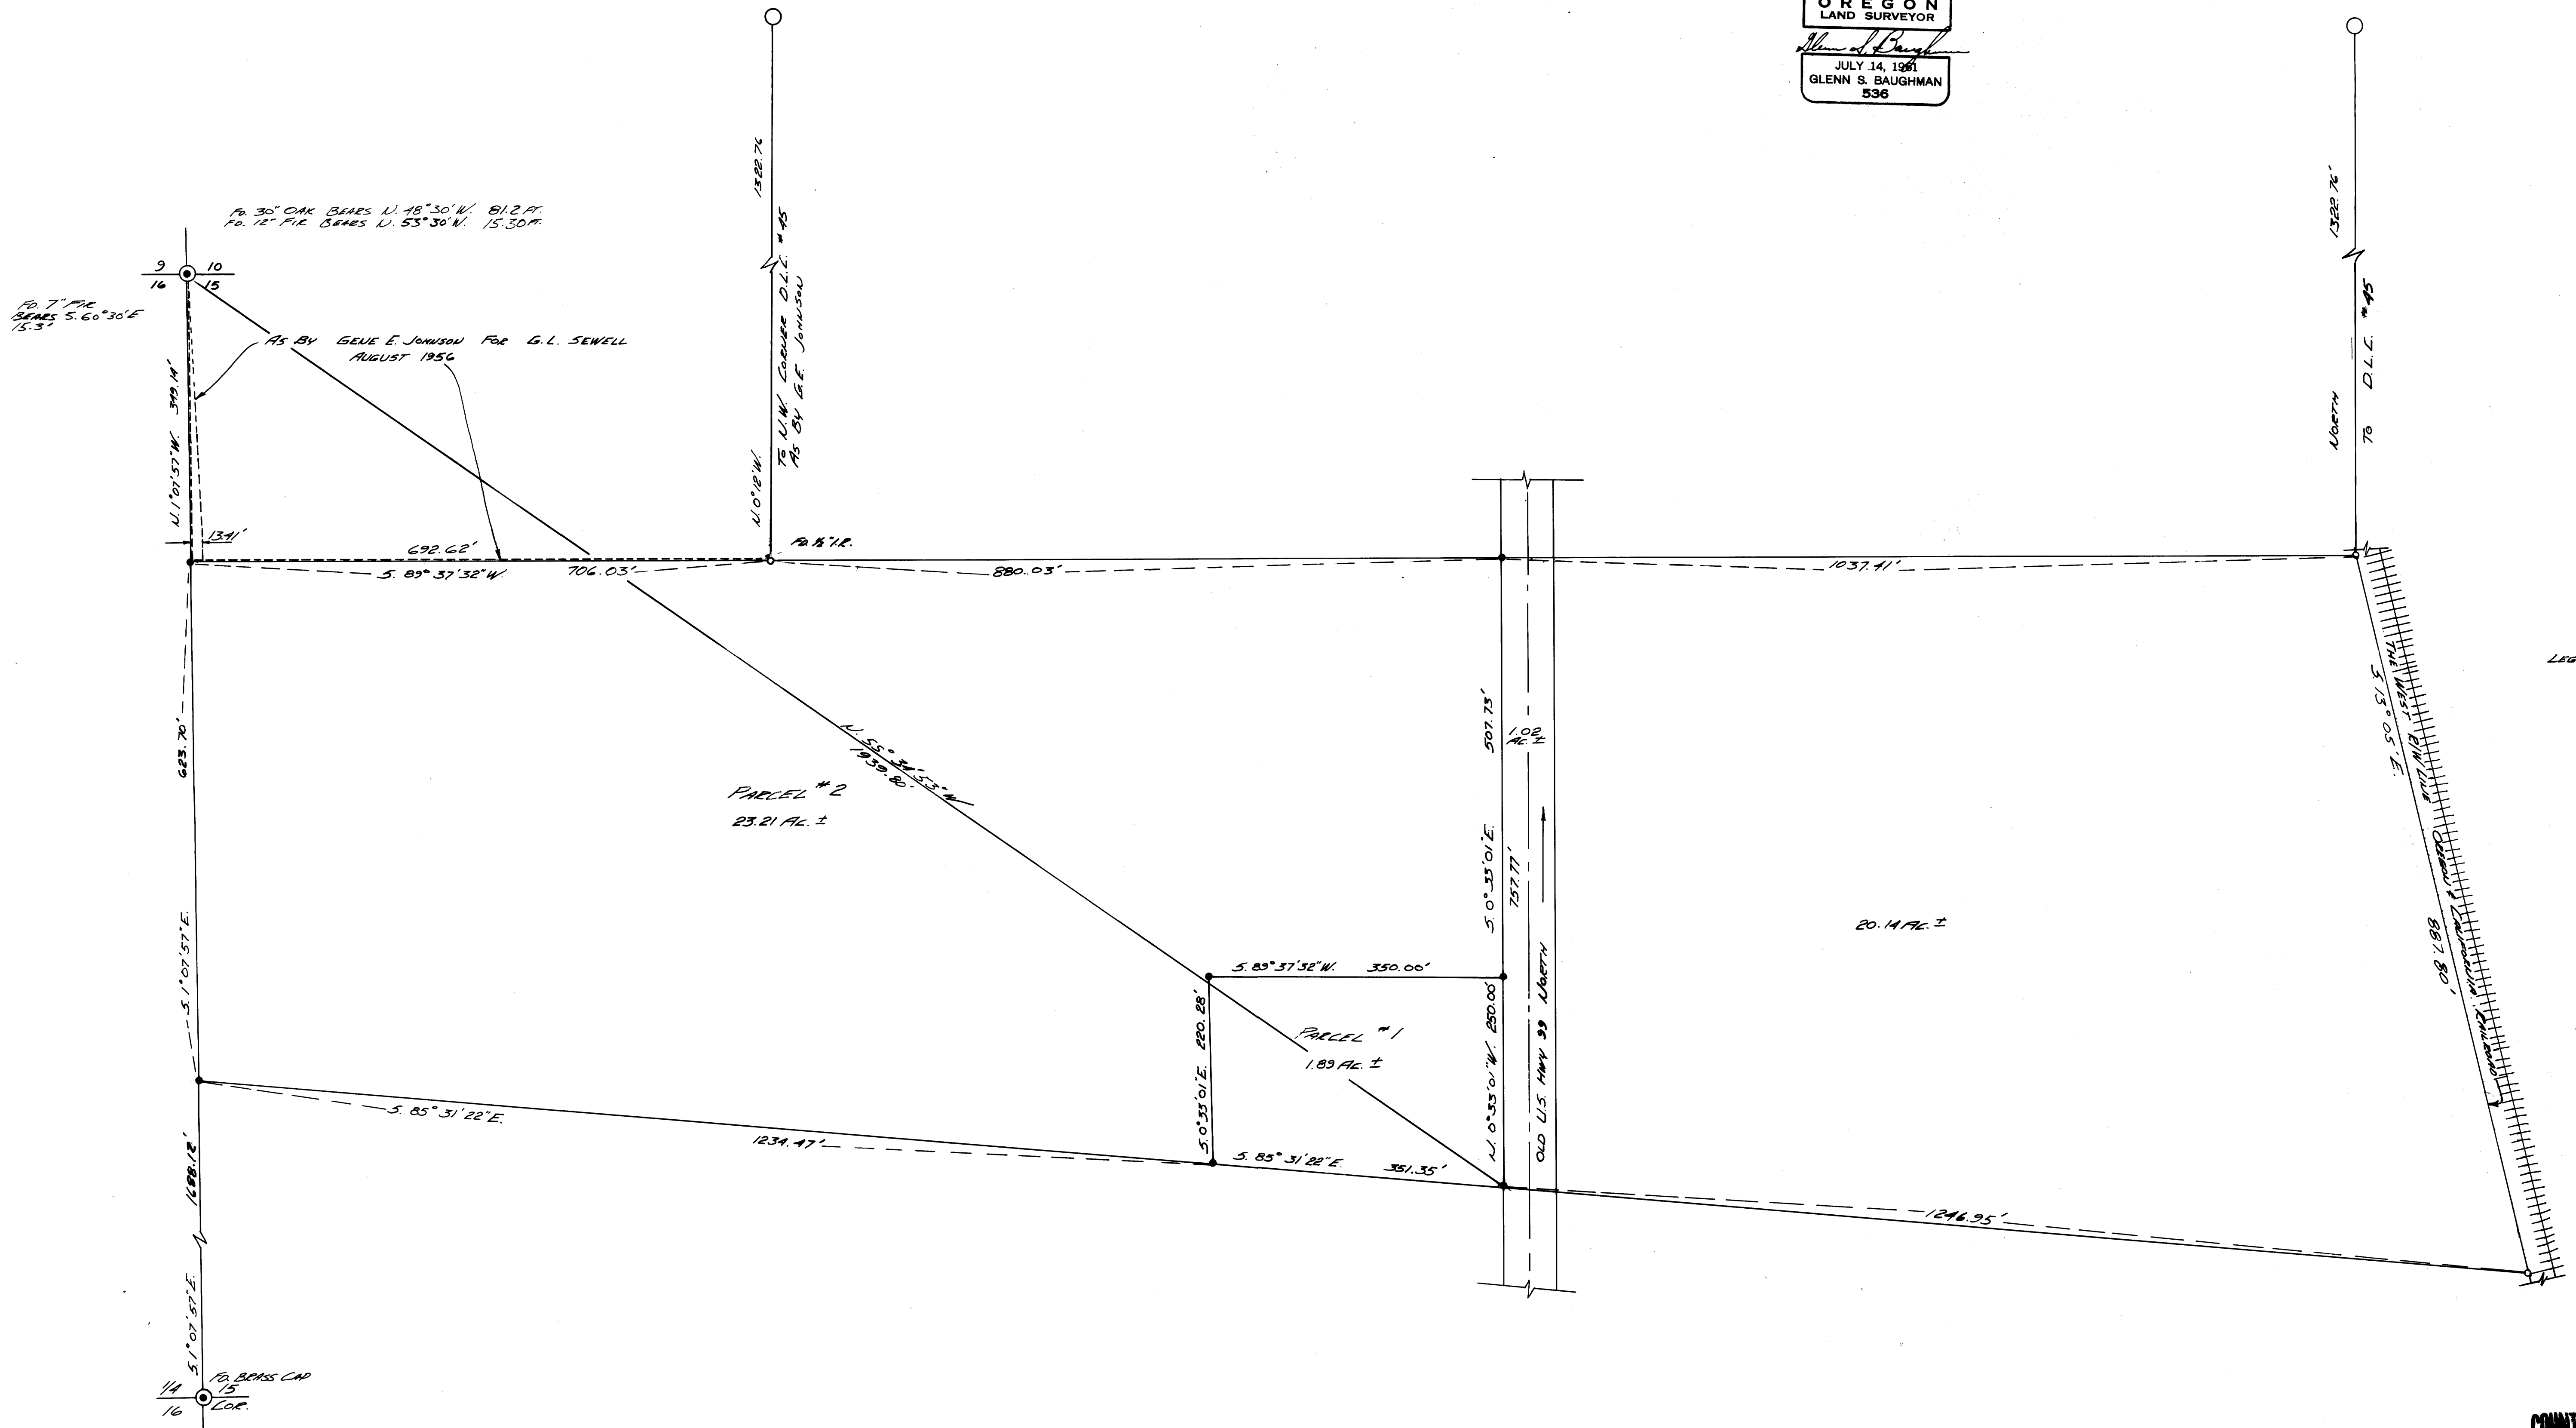

LEGEND:
● SET LINE
○ 1/4" I.R.
○ 1/2" I.R.
○ 1/2" SET COR.