


COUNTY SURVEYORS FILE DATA  
DO NOT REMOVE FROM OFFICE

SECTION 29, TOWNSHIP 31 SOUTH, RANGE 1 WEST, WILLAMETTE MERIDIAN

FILED  
RECEIVED  
OCT 3 1977  
COUNTY SURVEYOR  
DOUGLAS COUNTY, OREGON

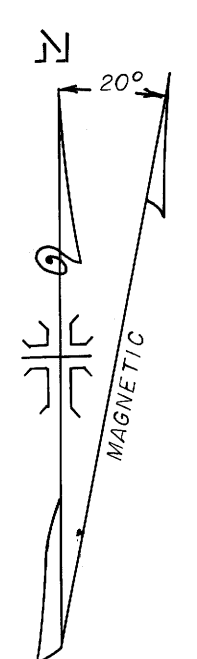


I, J. A. HOFFBUHR, A REGISTERED LAND SURVEYOR IN THE STATE OF OREGON, HEREBY CERTIFY THAT THIS PLAT AND THE NOTES HEREON, OR ATTACHED, ARE A CORRECT REPRESENTATION OF A SURVEY I PERFORMED DURING JUNE, JULY, AUGUST AND SEPTEMBER 1972, FOR THE U.S. FOREST SERVICE, IN ACCORDANCE WITH THE STATUTES OF THE STATE OF OREGON AND THE ARTICLES OF MY CONTRACT.

J. A. Hoffbuh  
J. A. HOFFBUHR  
REGISTERED LAND SURVEYOR  
OREGON LICENSE 222

REGISTERED  
PROFESSIONAL  
LAND SURVEYOR


OREGON  
NOV. 7, 1947  
J. A. HOFFBUHR  
222

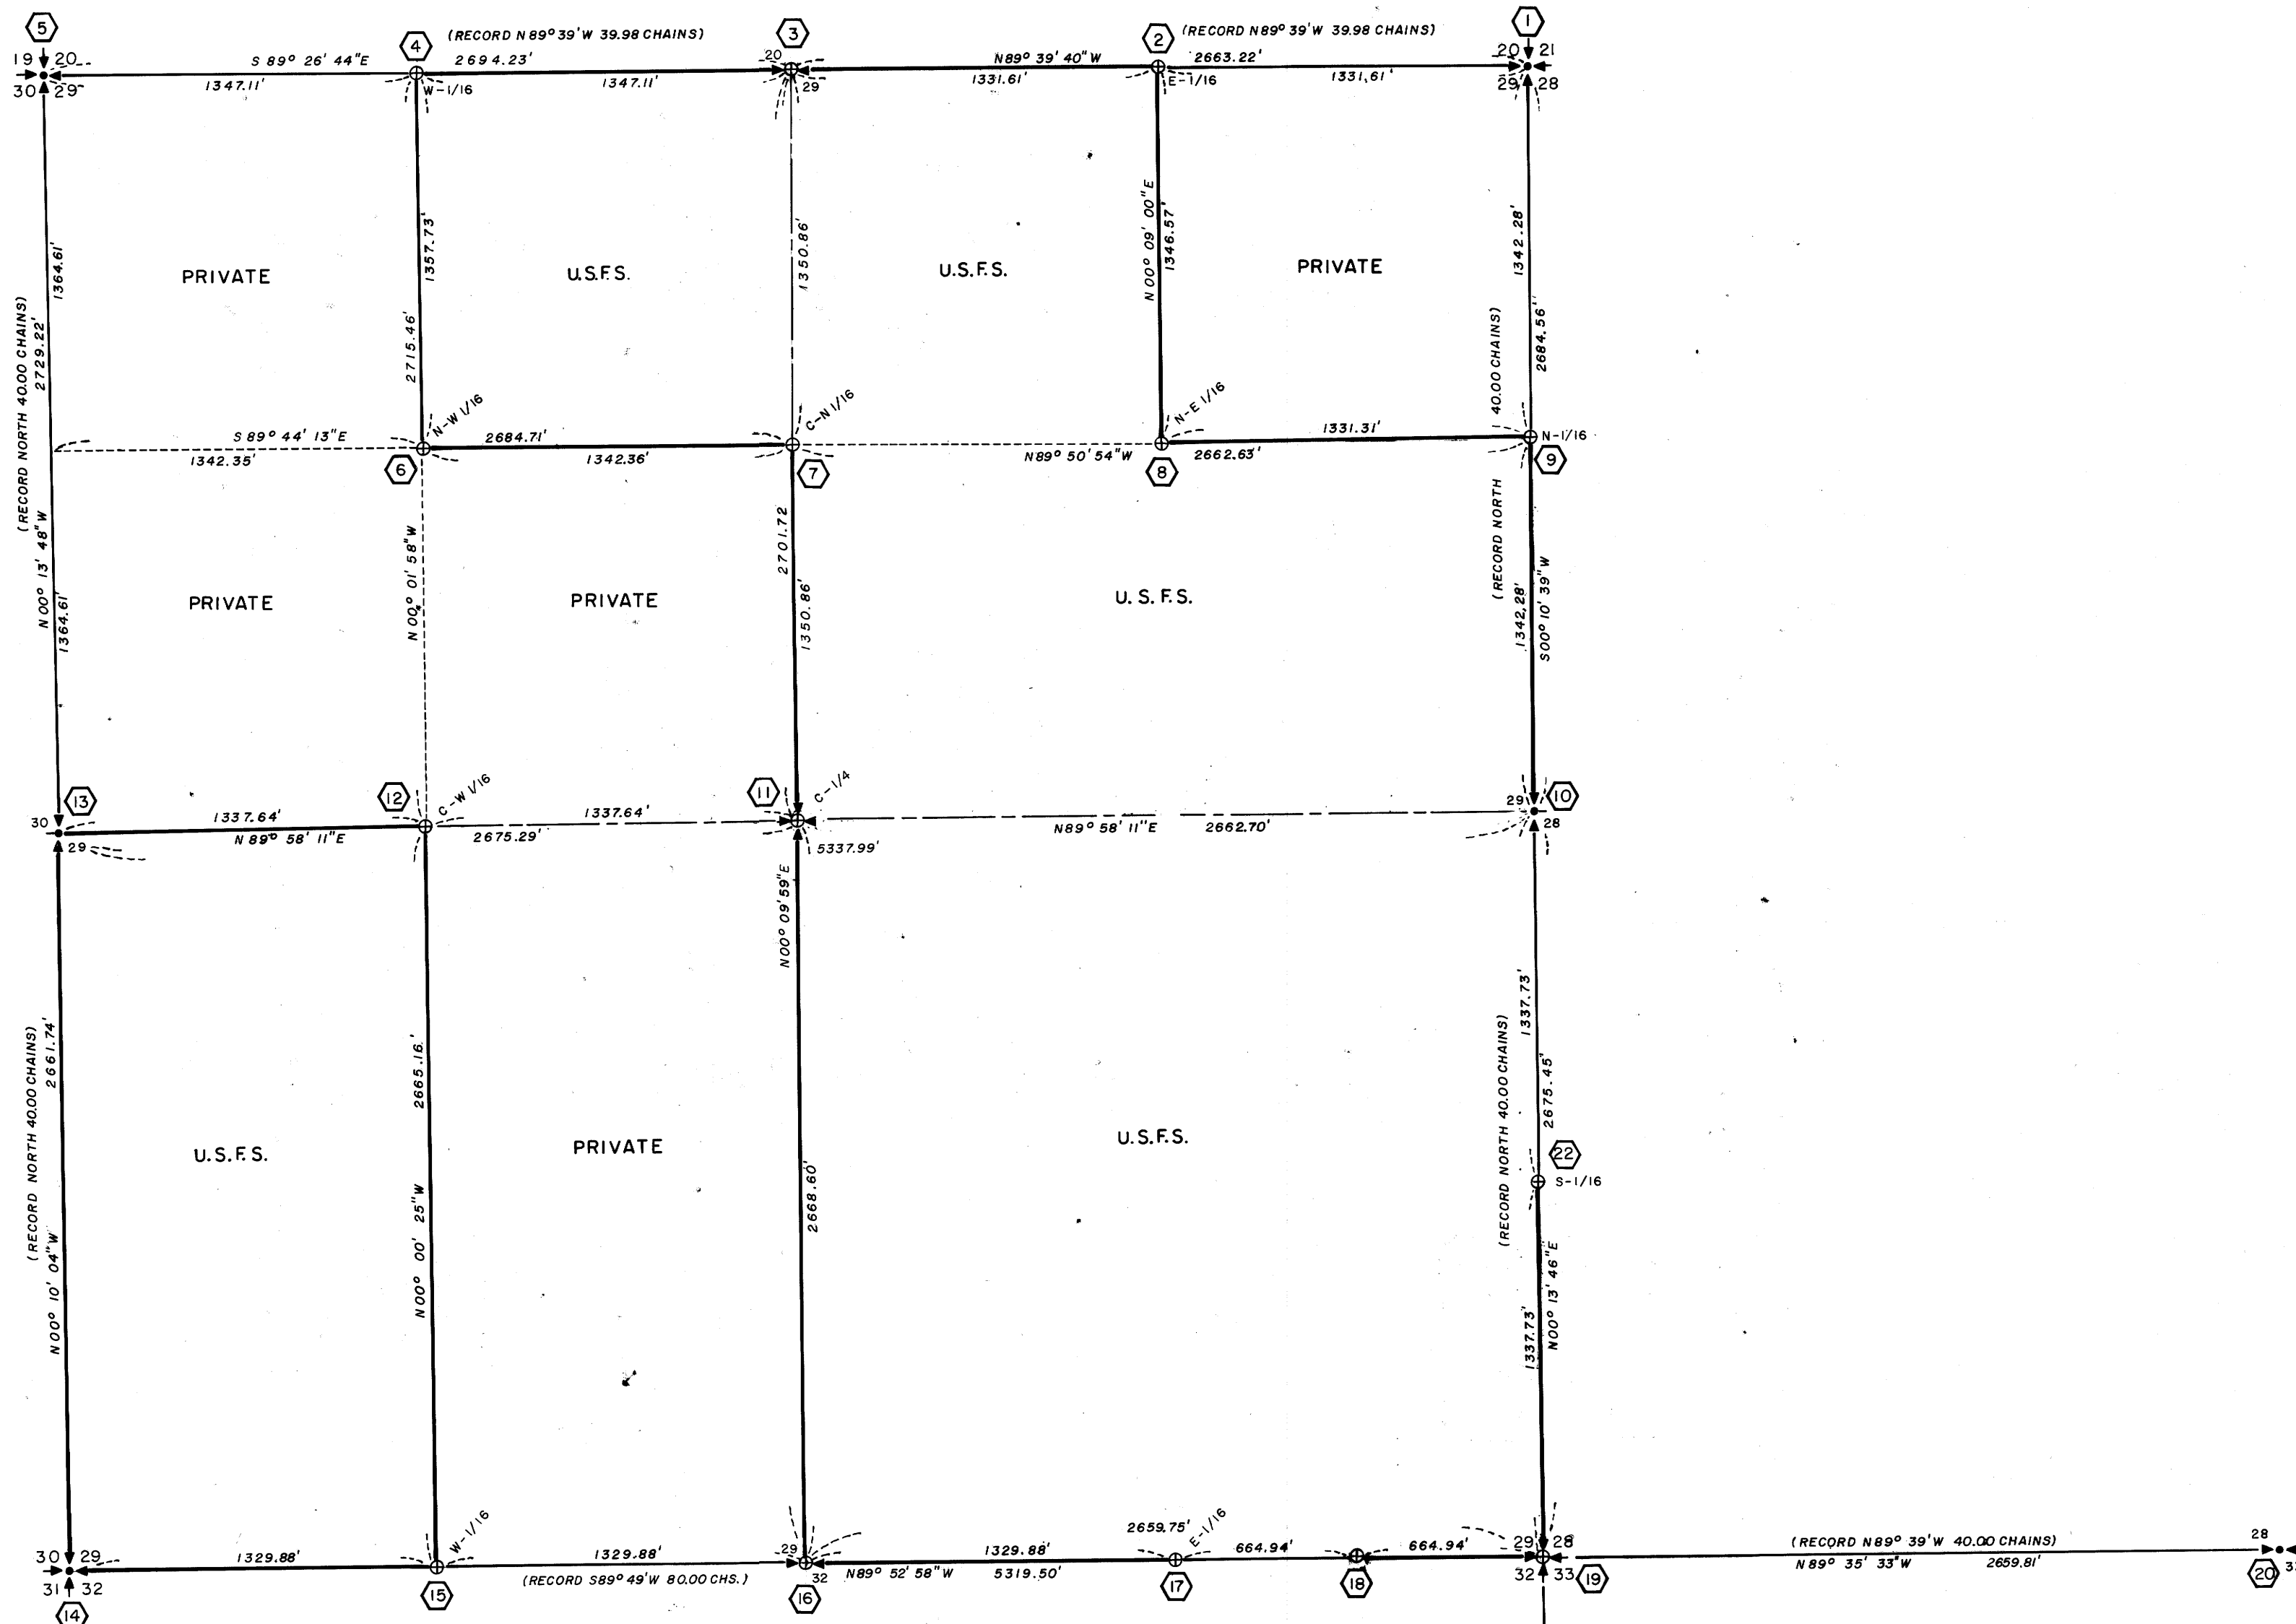


NOTE:

- ALL MONUMENTS SET ON THIS SURVEY ARE SET ON 2" X 30" GALV. IRON PIPE WITH METAL FLANGE WELDED TO BOTTOM OF PIPE.
- ALL BEARING TREE DIMENSIONS INDICATE THE DIAMETER OF THE TREE AT SCRIBED AREA.
- ALL BEARING TREE DISTANCES AND BEARINGS ARE FROM THE CENTER OF THE MONUMENT TO THE CENTER OF THE TREE.
- ALL BEARING TREES HAVE A BRASS WASHER STAMPED LS 222 NAILED IN LOWER BLAZE.
- POSTED LINE
- SECTION LINE
- CORNER SET
- FOUND CORNER


DESCRIPTION OF MONUMENTS AND ACCESSORY TIES

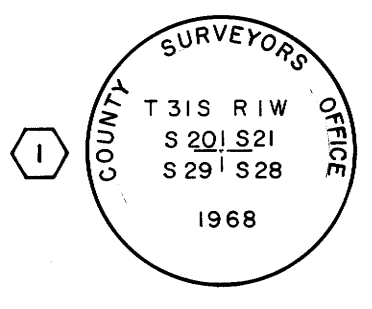


SECTION CORNER COMMON TO SECTIONS 20, 21, 29 & 28  
Found County Surveyors Brass Cap on 1" Galv. Iron pipe set in mound of stone marked as shown.  
FROM WHICH BEARS:  
16" W. Oak (Orig. B.T.) Scar showing N 34° E 55.8'  
16" W. Oak (Orig. B.T.) Orig. scribe rotted out, recent scribe visible S 43° E 31.7'  
10" B. Oak recent scribe visible S 54 1/2° W 57.0'  
14" B. Oak (Orig. B.T.) Scar showing N 17° W 37.4'

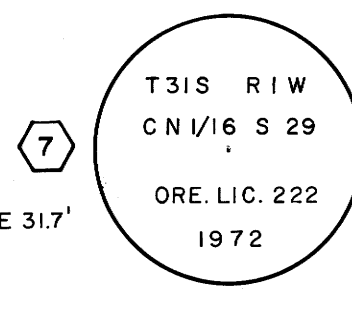


C N 1/16 SECTION CORNER, SECTION 29.  
Set 2" X 30" Galv. Iron pipe with 3" Brass Cap stamped as shown.  
FROM WHICH BEARS:  
10" D. Fir bears S 71/4° E 24.4' Scribd C N 1/16 S 29 RS 222 B.T.  
11" D. Fir bears S 86 1/2° W 36.1' Scribd C N 1/16 S 29 RS 222 B.T.

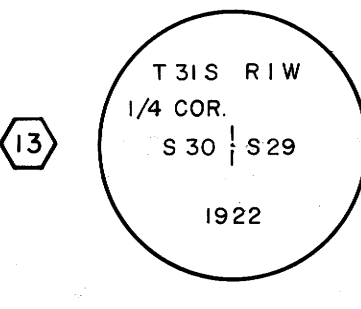


1/4 SECTION CORNER BETWEEN SECTIONS 29 & 30.  
Found G.L.O. Brass Cap stamped as shown.  
FROM WHICH BEARS:  
A 24" Cedar B.T. bears N 13 1/2° E 43.0' scribe visible.  
A 32" D. Fir B.T. bears S 80° E 2.0' shows scar.  
A 10" Cedar (Recent B.T.) bears S 45 1/2° W 15.0' scribe visible.  
A 30" D. Fir stump bears S 53 1/2° W 18.5' shows scar.  
A 28" Cedar B.T. bears N 4° W 14.1' scribe visible.

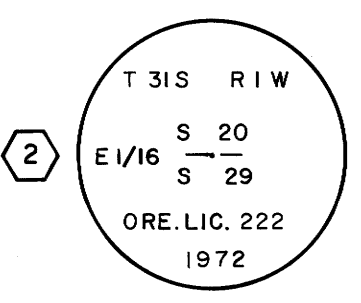


E 1/16 SECTION CORNER BETWEEN SECTIONS 20 & 29  
Set 2" X 30" Galv. Iron pipe with 3" Brass Cap stamped as shown.  
FROM WHICH BEARS:  
16" W. Oak B.T. bears N 16 1/4° W 15.1' Scribd E 1/16 S 20 RS 222 B.T.  
16" P. Pine B.T. bears S 1 1/2° E 8.6' Scribd E 1/16 S 29 RS 222 B.T.

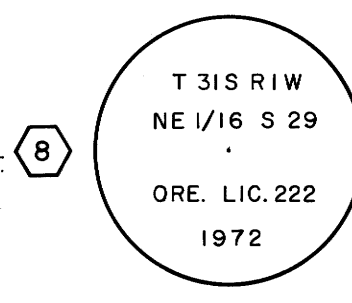


NE 1/16 SECTION CORNER, SECTION 29.  
Set 2" X 18" Galv. Iron pipe with 3" Brass Cap in concrete & stamped as shown.  
FROM WHICH BEARS:  
18" D. Fir bears N 40 1/4° W 26.5' Scribd NE 1/16 S 29 RS 222 B.T.  
14" D. Fir bears S 52 3/4° W 48.1' Scribd NE 1/16 S 29 RS 222 B.T.

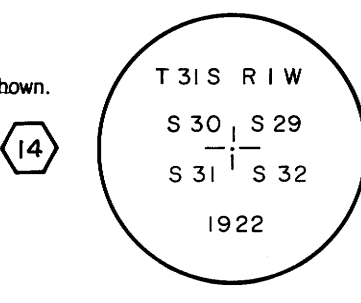


SECTION CORNER COMMON TO SECTIONS 29, 30, 31 & 32.  
Found 2" Iron pipe with 2 1/2" Dia. G.L.O. Brass Cap stamped as shown.  
FROM WHICH BEARS:  
A 24" Cedar B.T. bears N 13 1/2° E 43.0' scribe visible.  
A 32" D. Fir B.T. bears S 80° E 2.0' shows scar.  
A 10" Cedar (Recent B.T.) bears S 45 1/2° W 15.0' scribe visible.  
A 30" D. Fir stump bears S 53 1/2° W 18.5' shows scar.  
A 28" Cedar B.T. bears N 4° W 14.1' scribe visible.

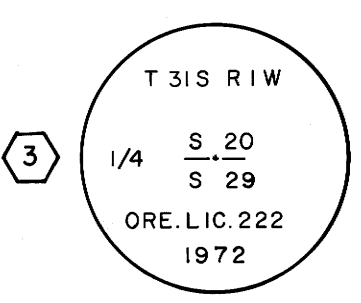


1/4 SECTION CORNER BETWEEN SECTIONS 20 & 29  
Found stone mound  
FROM WHICH BEARS:  
Found stump hole with Oak sucker shoots N 52° W 14.5'  
Found stump hole with Oak sucker shoots S 73° W 11.9'  
16" P. Pine B.T. bears N 17 1/4° W 40.0' Scribd 1/4 S 20 RS 222 B.T.  
12" D. Fir B.T. bears S 6 1/2° E 24.8' Scribd 1/4 S 29 RS 222 B.T.

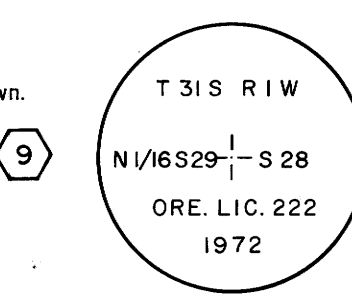


N 1/16 SECTION CORNER, SECTIONS 28 & 29.  
Set 2" X 30" Galv. Iron pipe with 3" Brass Cap stamped as shown.  
FROM WHICH BEARS:  
12" Oak bears N 3 1/2° E 34.0' Scribd N 1/16 S 28 RS 222 B.T.  
8" Oak bears S 75 1/2° W 35.5' Scribd N 1/16 S 29 RS 222 B.T.

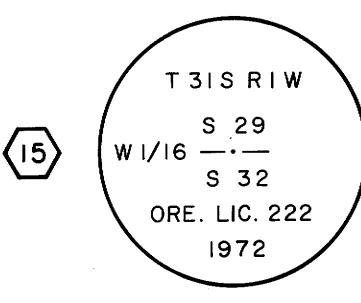


W 1/16 SECTION CORNER BETWEEN SECTIONS 29 & 32.  
Set 2" X 30" Galv. Iron pipe with 3" Brass Cap stamped as shown.  
FROM WHICH BEARS:  
12" D. Fir bears N 26 1/4° E 34.9' Scribd W 1/16 S 29 RS 222 B.T.  
8" D. Fir bears S 16 3/4° E 9.1' Scribd W 1/16 S 32 RS 222 B.T.

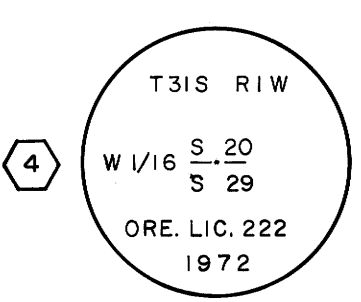


W 1/16 SECTION CORNER BETWEEN SECTIONS 20 & 29  
Set 2" X 18" Galv. Iron pipe with 3" Brass Cap set in concrete and stamped as shown  
FROM WHICH BEARS:  
14" D. Fir B.T. bears N 11 1/2° E 53.2' Scribd W 1/16 S 20 RS 222 B.T.  
10" Cedar B.T. bears S 26 1/2° W 42.1' Scribd W 1/16 S 29 RS 222 B.T.

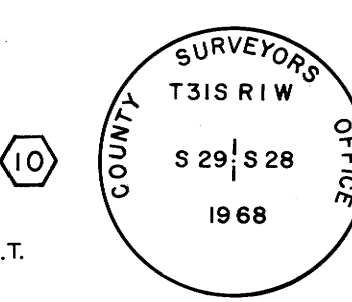


1/4 SECTION CORNER BETWEEN SECTIONS 28 & 29  
Found 2 1/2" Brass Cap on a 1" Galv. Iron pipe in rock mound and stamped as shown  
FROM WHICH BEARS:  
A 24" Ponderosa Pine bears S 88 1/2° E 20.2' scribe shows.  
A 18" Oak (Orig. B.T.) bears S 56° W 47.4' scribe rotted out.  
A 16" Fir bears S 69 1/2° W 43.8' scribe shows.

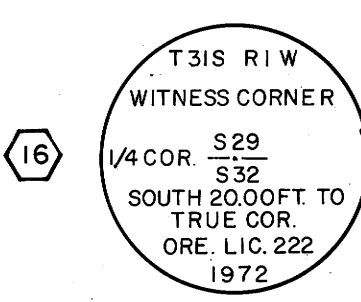


1/4 SECTION CORNER BETWEEN SECTIONS 29 & 32  
Set 2" X 30" Galv. Iron pipe with 3" Brass Cap Witness Corner stamped as shown.  
FROM WHICH BEARS:  
12" W. Fir bears S 24 3/4° W 180.5' Scribd W.C. 1/4 S 32 T 31 S R 1 W RS 222 B.T.  
10" D. Fir bears N 36 1/2° E 81.4' Scribd W.C. 1/4 S 29 T 31 S R 1 W RS 222 B.T.

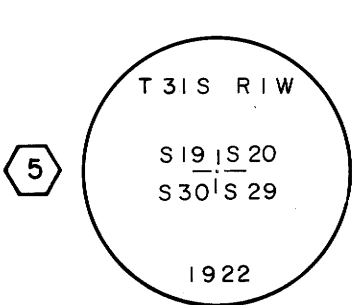


SECTION CORNER COMMON TO SECTIONS 19, 20, 29 & 30.  
Found G.L.O. Brass Cap properly stamped.  
FROM WHICH BEARS:  
(Orig. B.T.) D. Fir now stump bears S 4° E 47.5' shows scar.  
(Orig. B.T.) D. Fir now stump bears S 2 1/2° W 50.2' shows scar.  
(Orig. B.T.) D. Fir now stump bears N 15° E 23.8' shows scar.  
Recent B.T.'s:  
A 14" D. Fir bears S 60° W 15.2' shows scribe.  
A 10" D. Fir bears N 75° W 13.3' shows scribe.  
A 22" D. Fir bears S 31° E 15.2' shows scribe.  
A 8" Maple bears N 64° E 37.6' shows scribe.

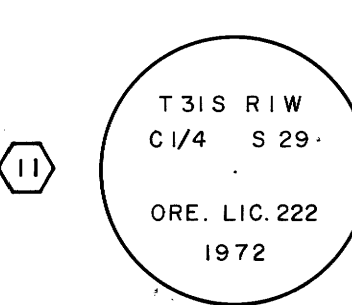


C 1/4 SECTION CORNER, SECTION 29.  
Set 2" X 30" Galv. Iron pipe with 3" Brass Cap stamped as shown.  
FROM WHICH BEARS:  
12" D. Fir bears S 75 1/4° W 6.9' Scribd C 1/4 S 29 RS 222 B.T.  
12" D. Fir bears N 57° E 20.5' Scribd C 1/4 S 29 RS 222 B.T.

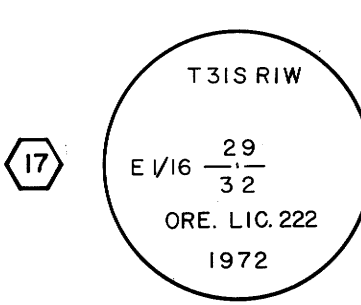


E 1/16 SECTION CORNER BETWEEN SECTIONS 29 & 32.  
Set 2" X 30" Galv. Iron pipe with 3" Brass Cap stamped as shown.  
FROM WHICH BEARS:  
7" D. Fir bears S 10° E 29.3' Scribd E 1/16 S 32 RS 222 B.T.  
14" D. Fir bears N 26° W 36.1' Scribd E 1/16 S 29 RS 222 B.T.

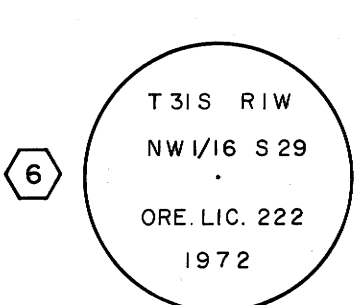


NW 1/16 SECTION CORNER, SECTION 29.  
Set 2" X 30" Galv. Iron pipe with 3" Brass Cap stamped as shown.  
FROM WHICH BEARS:  
24" D. Fir bears N 57° W 45.1' Scribd NW 1/16 S 29 RS 222 B.T.  
14" D. Fir bears N 46 1/4° E 45.5' Scribd NW 1/16 S 29 RS 222 B.T.

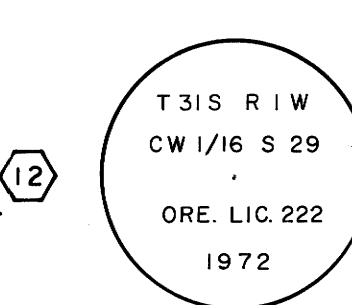


CW 1/16 SECTION CORNER, SECTION 29.  
Set 2" X 30" Galv. Iron pipe with 3" Brass Cap stamped as shown.  
FROM WHICH BEARS:  
14" D. Fir bears S 10° W 51.6' Scribd CW 1/16 S 29 RS 222 B.T.  
8" D. Fir bears N 51 1/2° W 66.3' Scribd CW 1/16 S 29 RS 222 B.T.

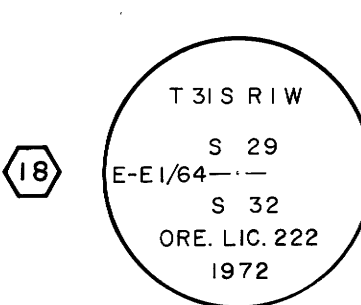


E-E 1/64 SECTION CORNER BETWEEN SECTIONS 29 & 32.  
Set 2" X 30" Galv. Iron pipe with 3" Brass Cap stamped as shown.  
FROM WHICH BEARS:  
8" D. Fir bears N 31 1/4° E 49.1' Scribd E-E 1/64 S 29 RS 222 B.T.  
12" W. Fir bears S 17° W 80.2' Scribd E-E 1/64 S 32 RS 222 B.T.

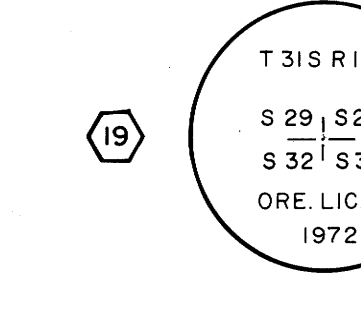


SECTION CORNER COMMON TO SECTIONS 28, 29, 32 & 33.  
Set 2" X 30" Galv. Iron pipe with 3" Brass Cap stamped as shown.  
FROM WHICH BEARS:  
15" W. Fir bears N 41 1/4° E 27.9' Scribd T 31 S R 1 W S 28 RS 222 B.T.  
8" P. Pine bears S 50° E 79.4' Scribd T 31 S R 1 W S 33 RS 222 B.T.  
12" P. Pine bears S 16 1/2° W 45.5' Scribd T 31 S R 1 W S 32 RS 222 B.T.  
8" D. Fir bears N 55 1/4° W 28.3' Scribd T 31 S R 1 W S 29 RS 222 B.T.

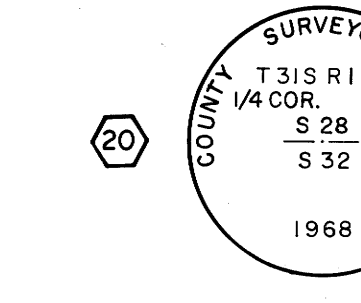

1/4 SECTION CORNER BETWEEN SECTIONS 28 & 33 (NOTE THIS MON. STAMPED WRONG - S 32 SHOULD BE S 33)  
Found 1" Galv. Iron pipe with 2 1/2" dia. Brass Disk stamped as shown.  
FROM WHICH BEARS:  
19" D. Fir B.T. (Orig.) bears N 59° W 12.0' shows scar.  
24" D. Fir B.T. (Orig.) bears S 30° W 6.9' was operated by County Surveyor for B.T. scribe.

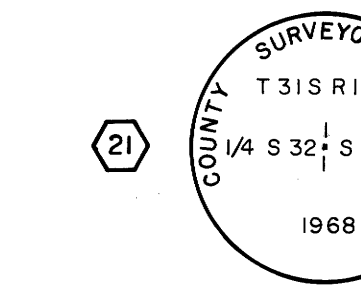

1/4 SECTION CORNER BETWEEN SECTIONS 32 & 33.  
Found 1" Galv. Iron pipe with 2 1/2" dia. Brass Disk stamped as shown.  
FROM WHICH BEARS:  
22" D. Fir (Orig. 10" B.T.) bears N 37° W 25.7'  
Fir stump (Orig. 10" B.T.) bears S 10° E 7.3' shows scar.  
12" D. Fir B.T. bears S 17° E 15.9' scribe visible.

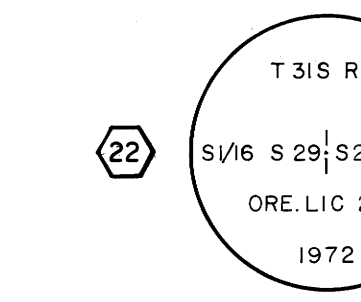

S 1/16 SECTION CORNER BETWEEN SECTIONS 28 & 29.  
Set 2" X 30" Galv. Iron pipe with 3" Brass Cap stamped as shown.  
FROM WHICH BEARS:  
11" D. Fir bears S 31 3/4° E 18.2' Scribd S 1/16 S 28 RS 222 B.T.  
9" D. Fir bears N 81 1/2° W 7.4' Scribd S 1/16 S 29 RS 222 B.T.

PLAT OF SURVEY  
LOCATED IN  
SECTION 29, T 31 S., R 1 W., W.M.  
DOUGLAS COUNTY, OREGON  
FOR  
THE UNITED STATES DEPARTMENT OF AGRICULTURE  
UMPQUA NATIONAL FOREST  
CONTRACT NO. 003588N  
J.A. HOFFBUHR, REG. L.S., MEDFORD, OREGON  
SCALE: 1" = 500' AUG. 28, 1972  
BASIS OF BEARING BY SOLAR OBSERVATION  
TILLER LAND SURVEY NO. 9  
NOTES RECORDED IN FIELD BOOKS 1 THRU 10

COUNTY SURVEYORS FILE DATA  
DO NOT REMOVE FROM OFFICE