



FILED  
RECEIVED  
JUL 22 1971  
COUNTY SURVEYOR  
DOUGLAS COUNTY, ORE.

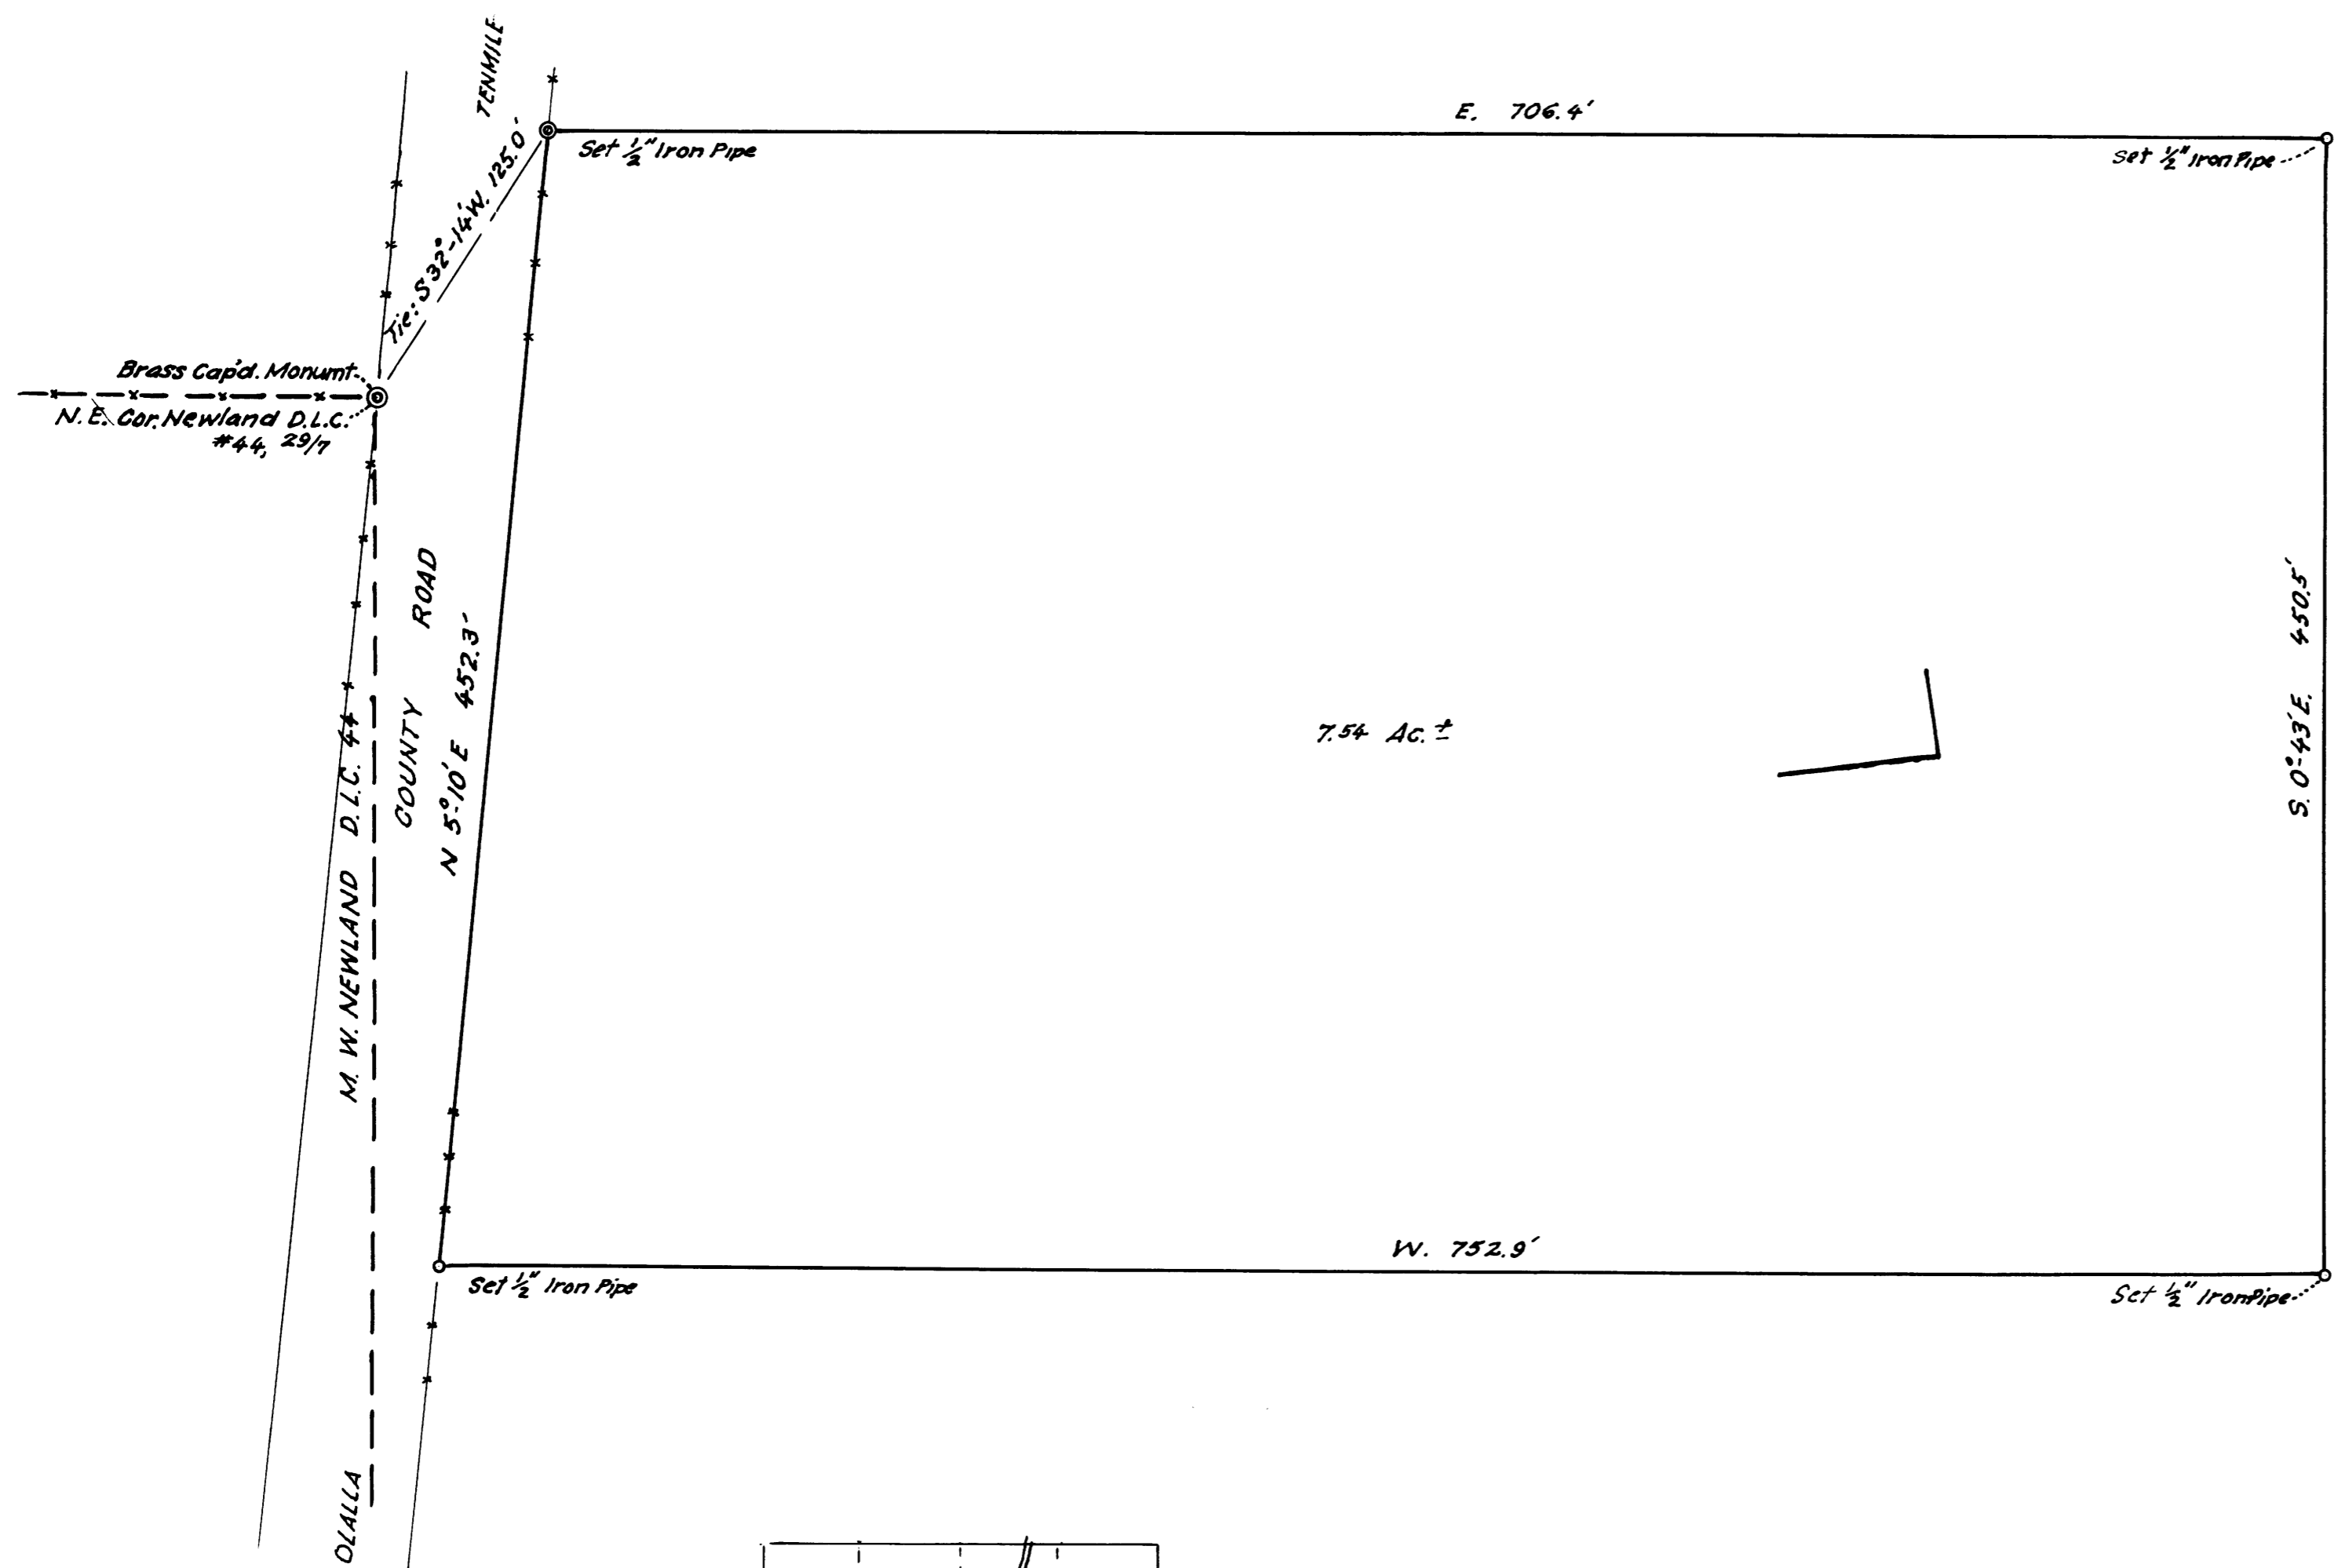

7.54 Ac. ±

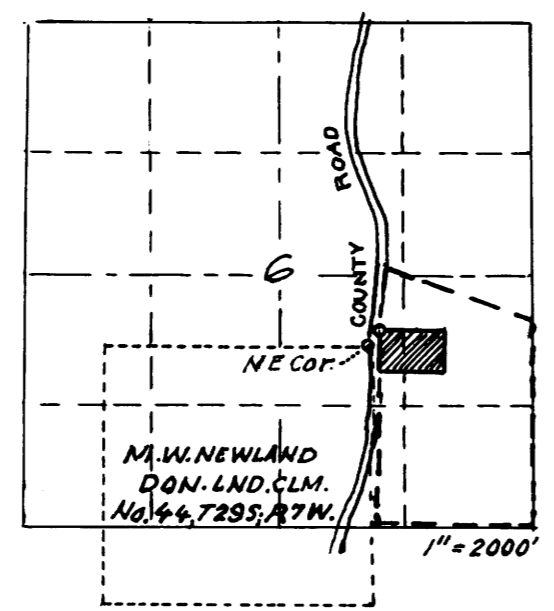

Mr & Mrs T. M. BENEDICT,  
TEN MILE, ORE  
SITE OF PROPOSED RESIDENCE IN SEC. 6,  
T. 29S; R. 7W, WIL. MER.  
DOUGLAS COUNTY, OREGON  
JULY, 1971 AB. 1" = 60 ft.

COUNTY SURVEYORS FILE DATA  
DO NOT REMOVE FROM OFFICE