



43-14

PROPERTY SURVEY FOR
JOHN BARRON
LOT 5, BLOCK 13 ROSEBURG HOME ORCHARD TRACTS
PLAT A, DOUGLAS COUNTY, OREGON
SEC'S. 20 & 29, T. 26 S., R. 6 W. W.M.

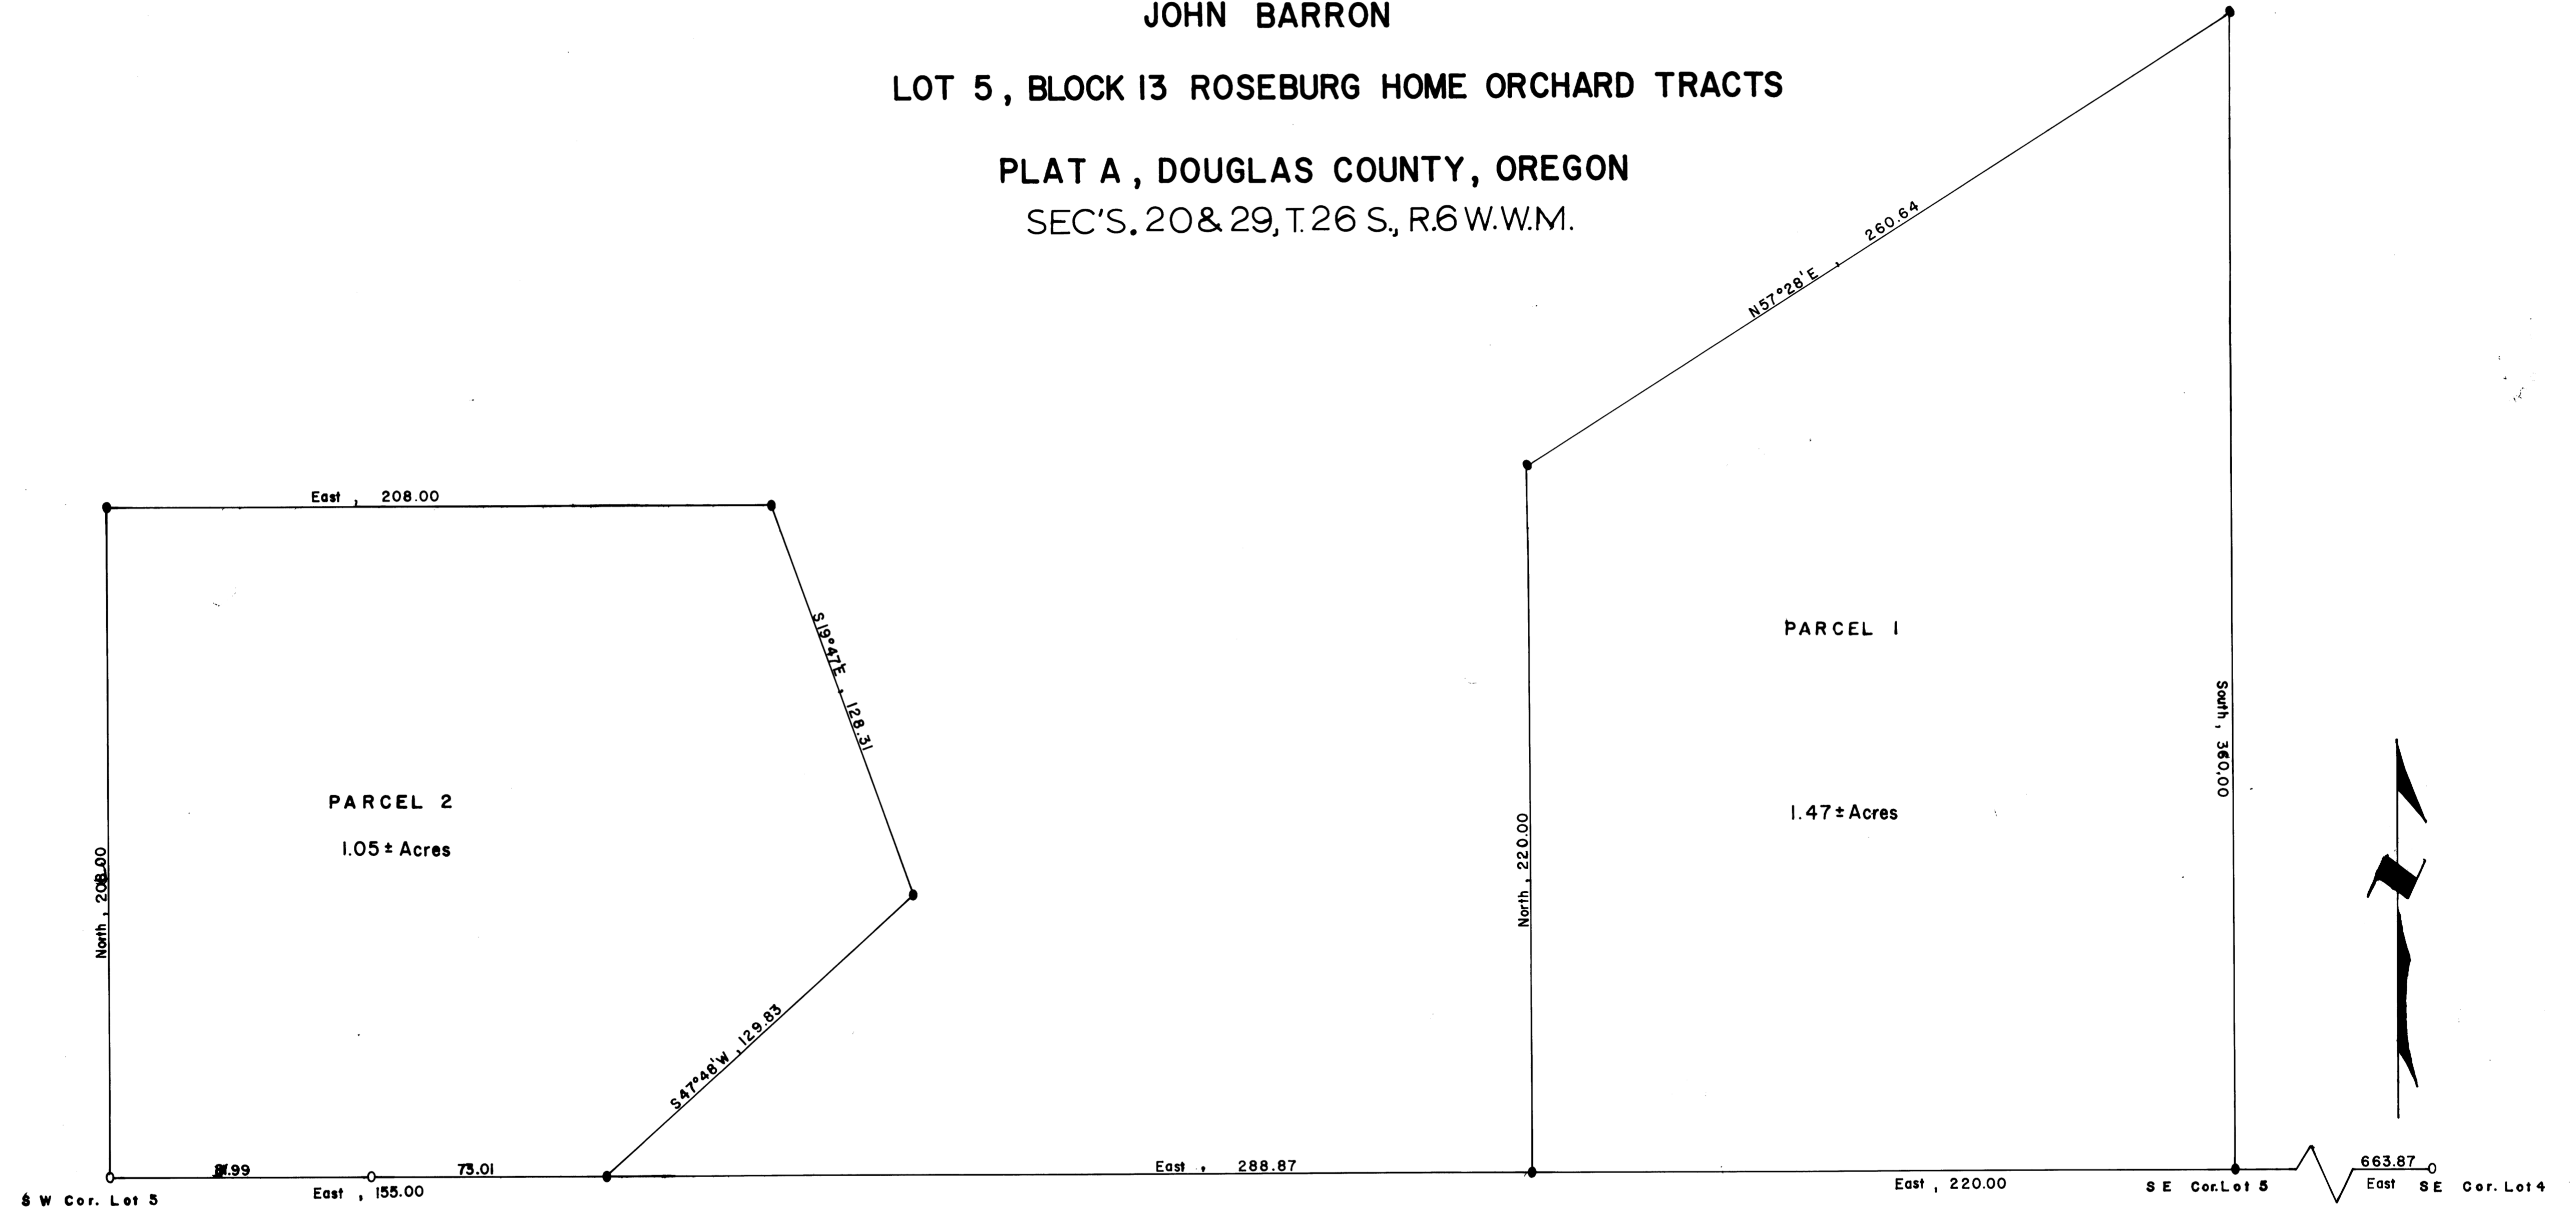

PARCEL 2
1.05 ± Acres

PARCEL 1
1.47 ± Acres

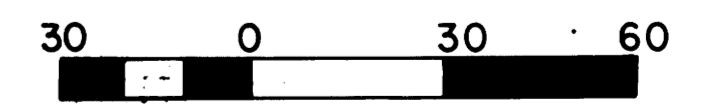

Scale: 1" = 30'

- Corner Set, 5/8" Iron Rod
- Corner Found, 5/8" Iron Rod

Surveyed by Dick Grant

July 9, 1971

