


SURVEY TO SUBDIVIDE SEC. SEC. 30, T.28S., R.G.3W.W.M.

FOR SUN STUDS

BY BAUGHMAN SURVEYING SERVICE

SCALE 1" = 400'

JULY 1971

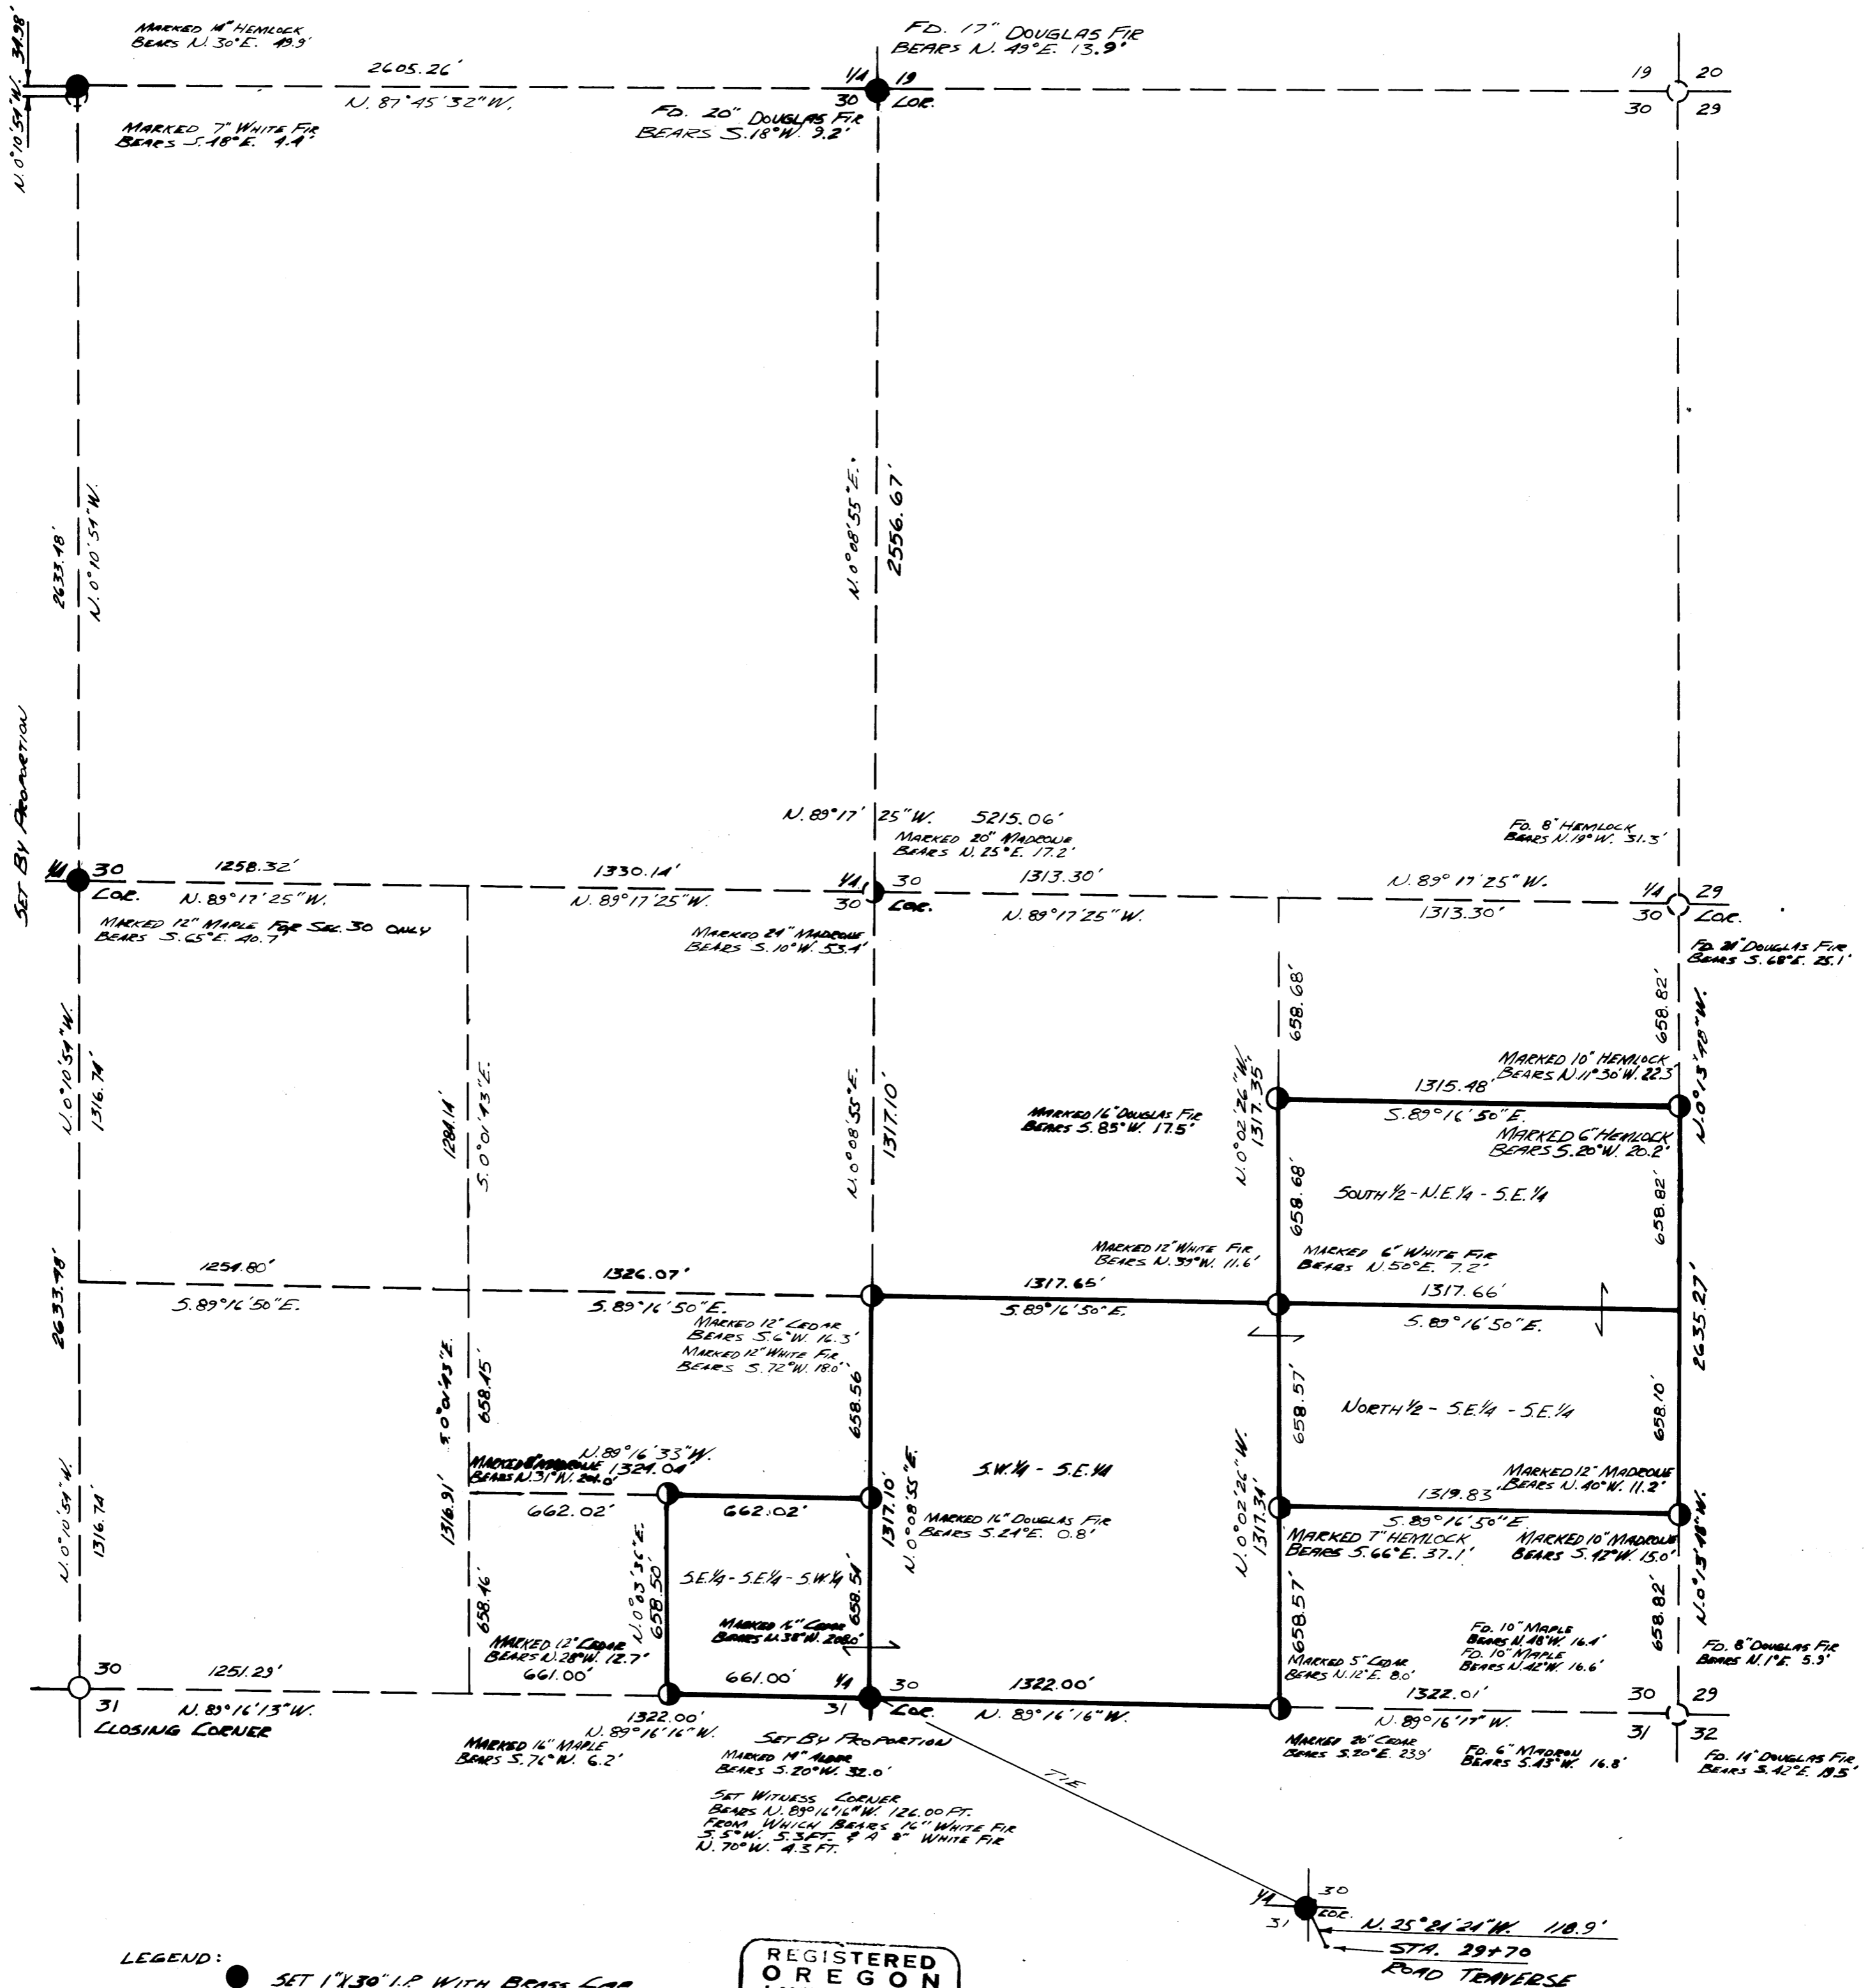

- LEGEND:
- SET 1" X 30" I.P. WITH BRASS CAP
 - FOUND I.P. WITH BRASS CAP
 - SET 3/8" I.P.

REGISTERED
OREGON
LAND SURVEYOR

Glenn S. Baughman
JULY 14, 1961
GLENN S. BAUGHMAN
536