
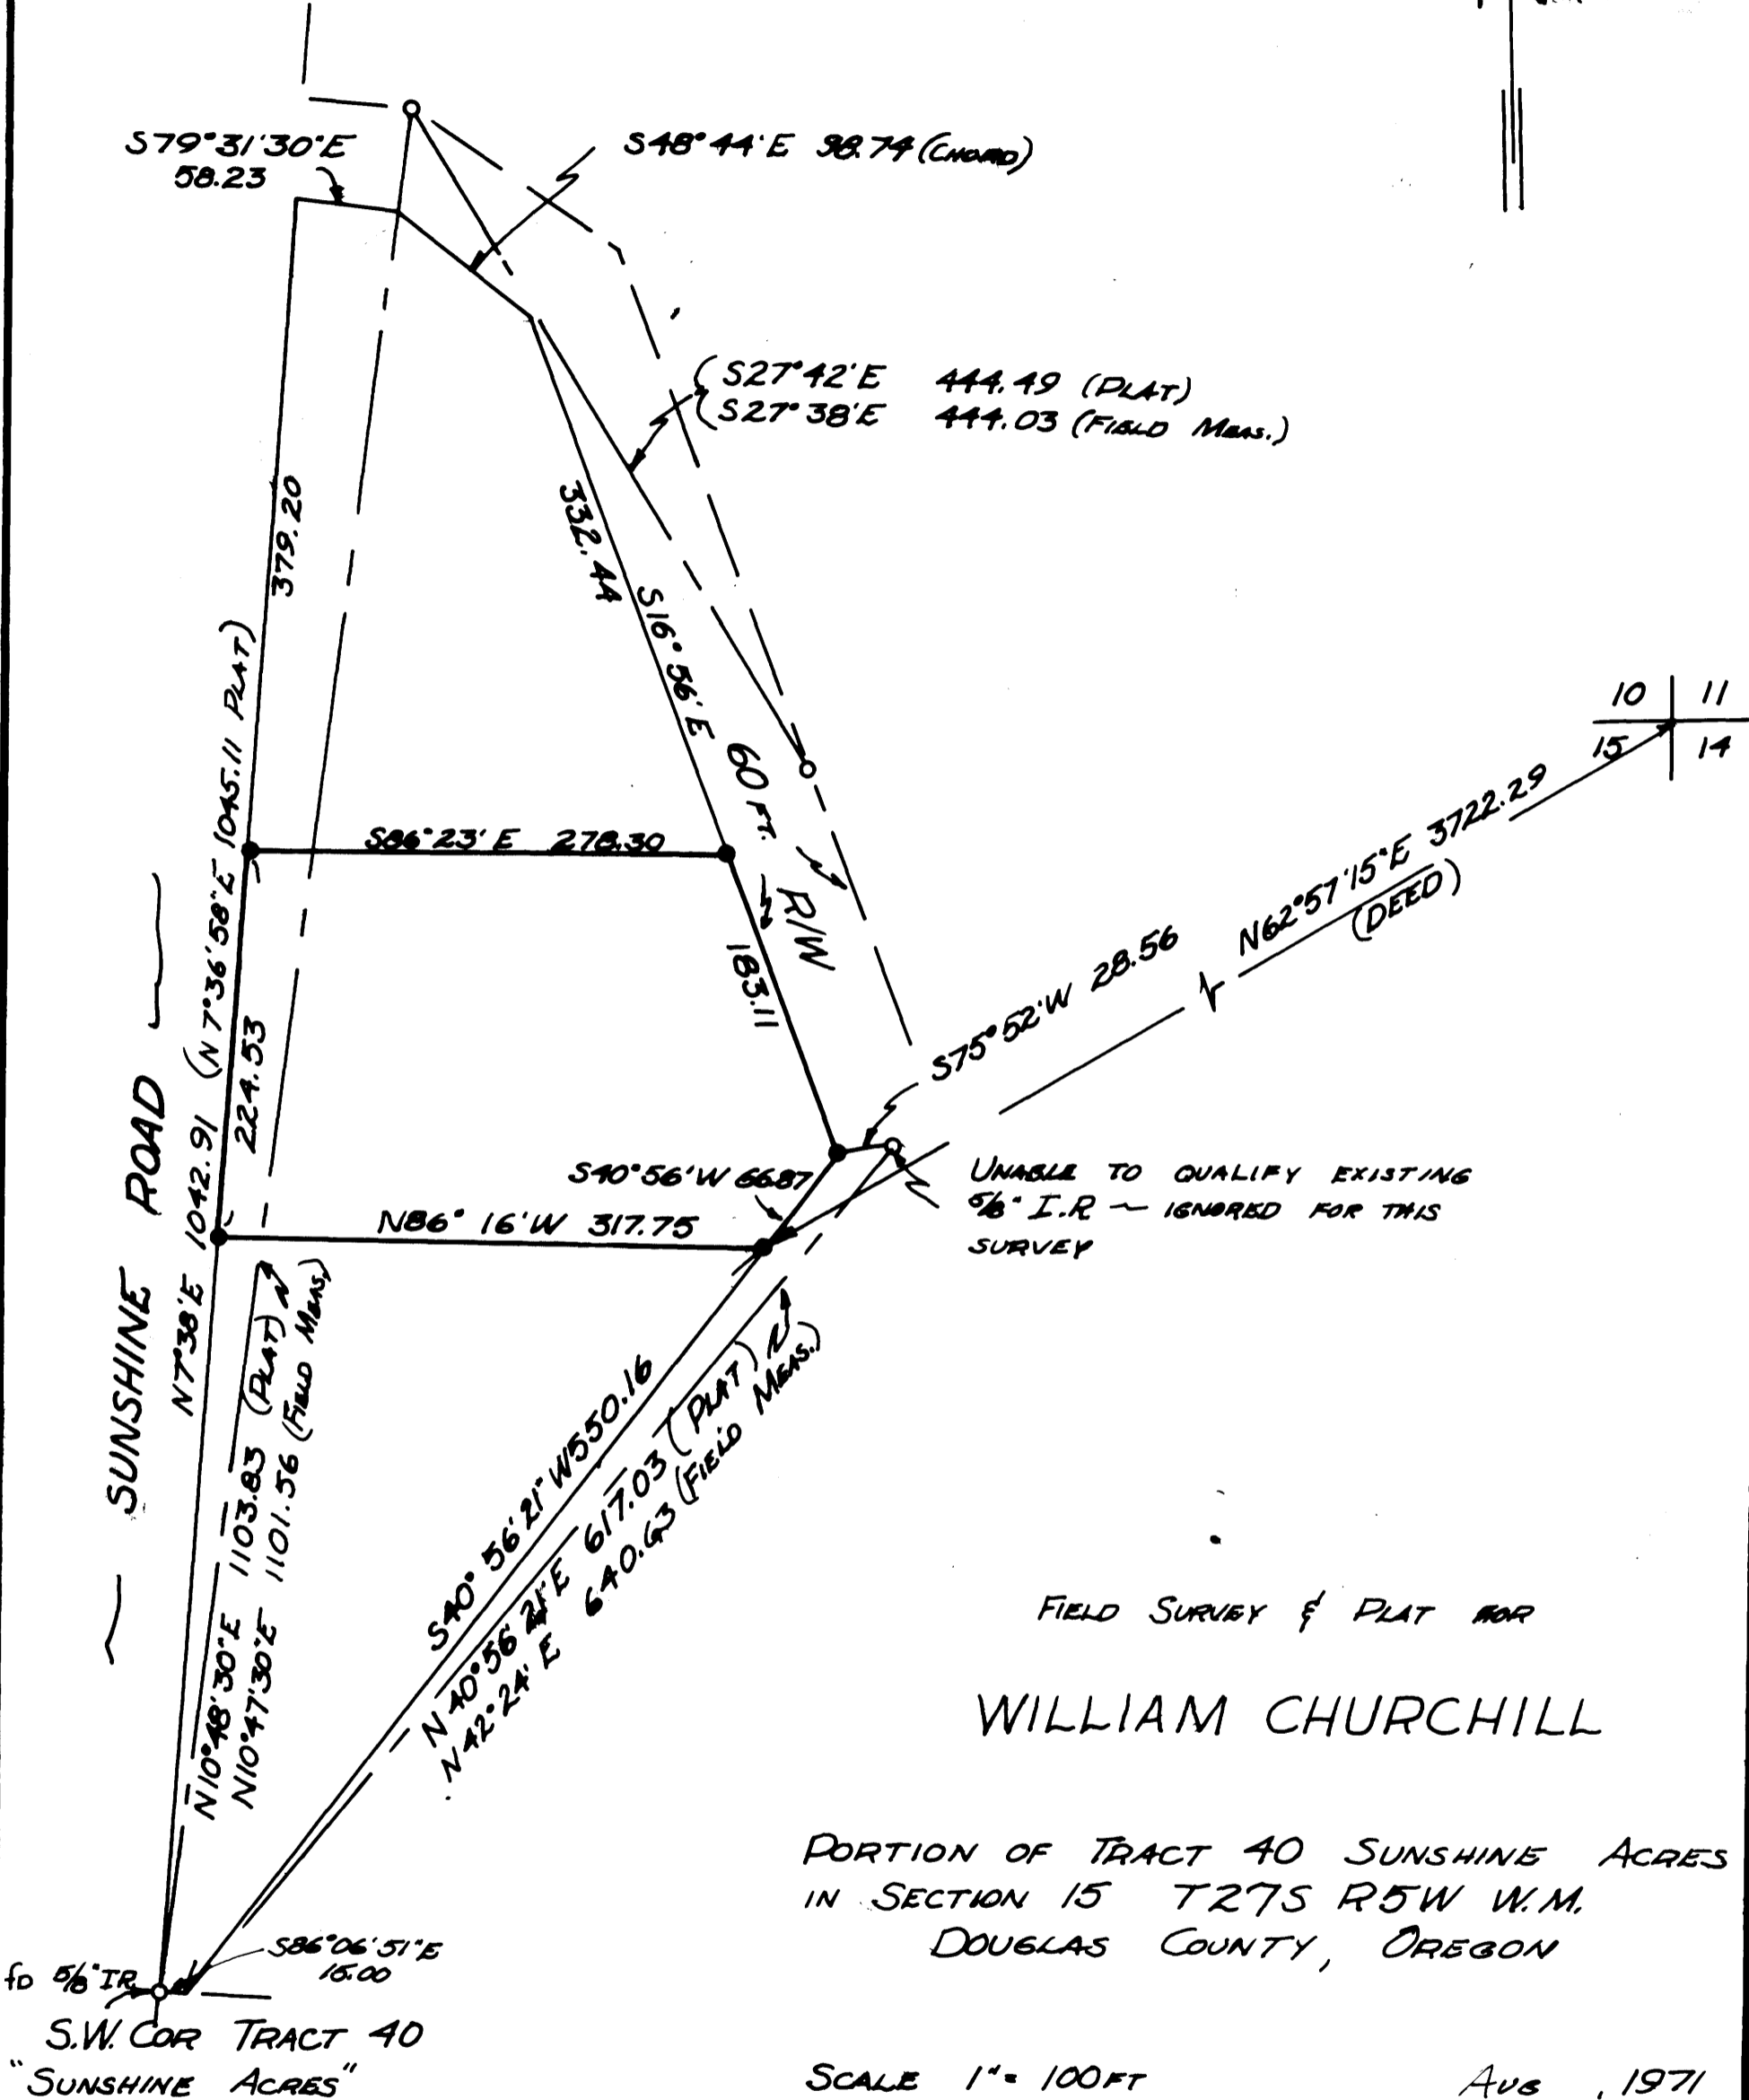


COUNTY SURVEYORS FILE DATA  
DO NOT REMOVE FROM OFFICE

FILED  
REC.

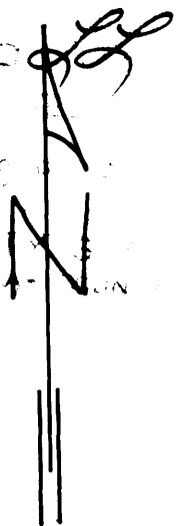

UNABLE TO QUALIFY EXISTING  
5/8" I.R. - IGNORED FOR THIS  
SURVEY

FIELD SURVEY & PLAT FOR

WILLIAM CHURCHILL

PORTION OF TRACT 40 SUNSHINE ACRES  
IN SECTION 15 T27S R5W W.M.  
DOUGLAS COUNTY, OREGON

SCALE 1" = 100 FT

AUG , 1971

DONALD A. BENTZ

REGISTERED  
OREGON  
LAND SURVEYOR

JULY 12, 1967  
DONALD A. BENTZ  
839

- o fd 5/8" I.R.
  - SET 5/8" I.R.
- BASE BEARING ~ EAST SIDES TRACT 40