

COUNTY SURVEYORS FILE DATA
DO NOT REMOVE FROM OFFICE

SURVEY OF PARCEL IN SECTION 29 # PETER SAAR
DLC # 55, T.28S, R.7W, W.M., DOUGLAS COUNTY, OREGON
FROM H.L. ST. CLAIR
FOR MIKE ST. CLAIR


SCALE 1" = 40'

MAY, 1972

FILED
RECEIVED

MAY 12 1972

COUNTY SURVEYOR
DOUGLAS COUNTY, ORE.

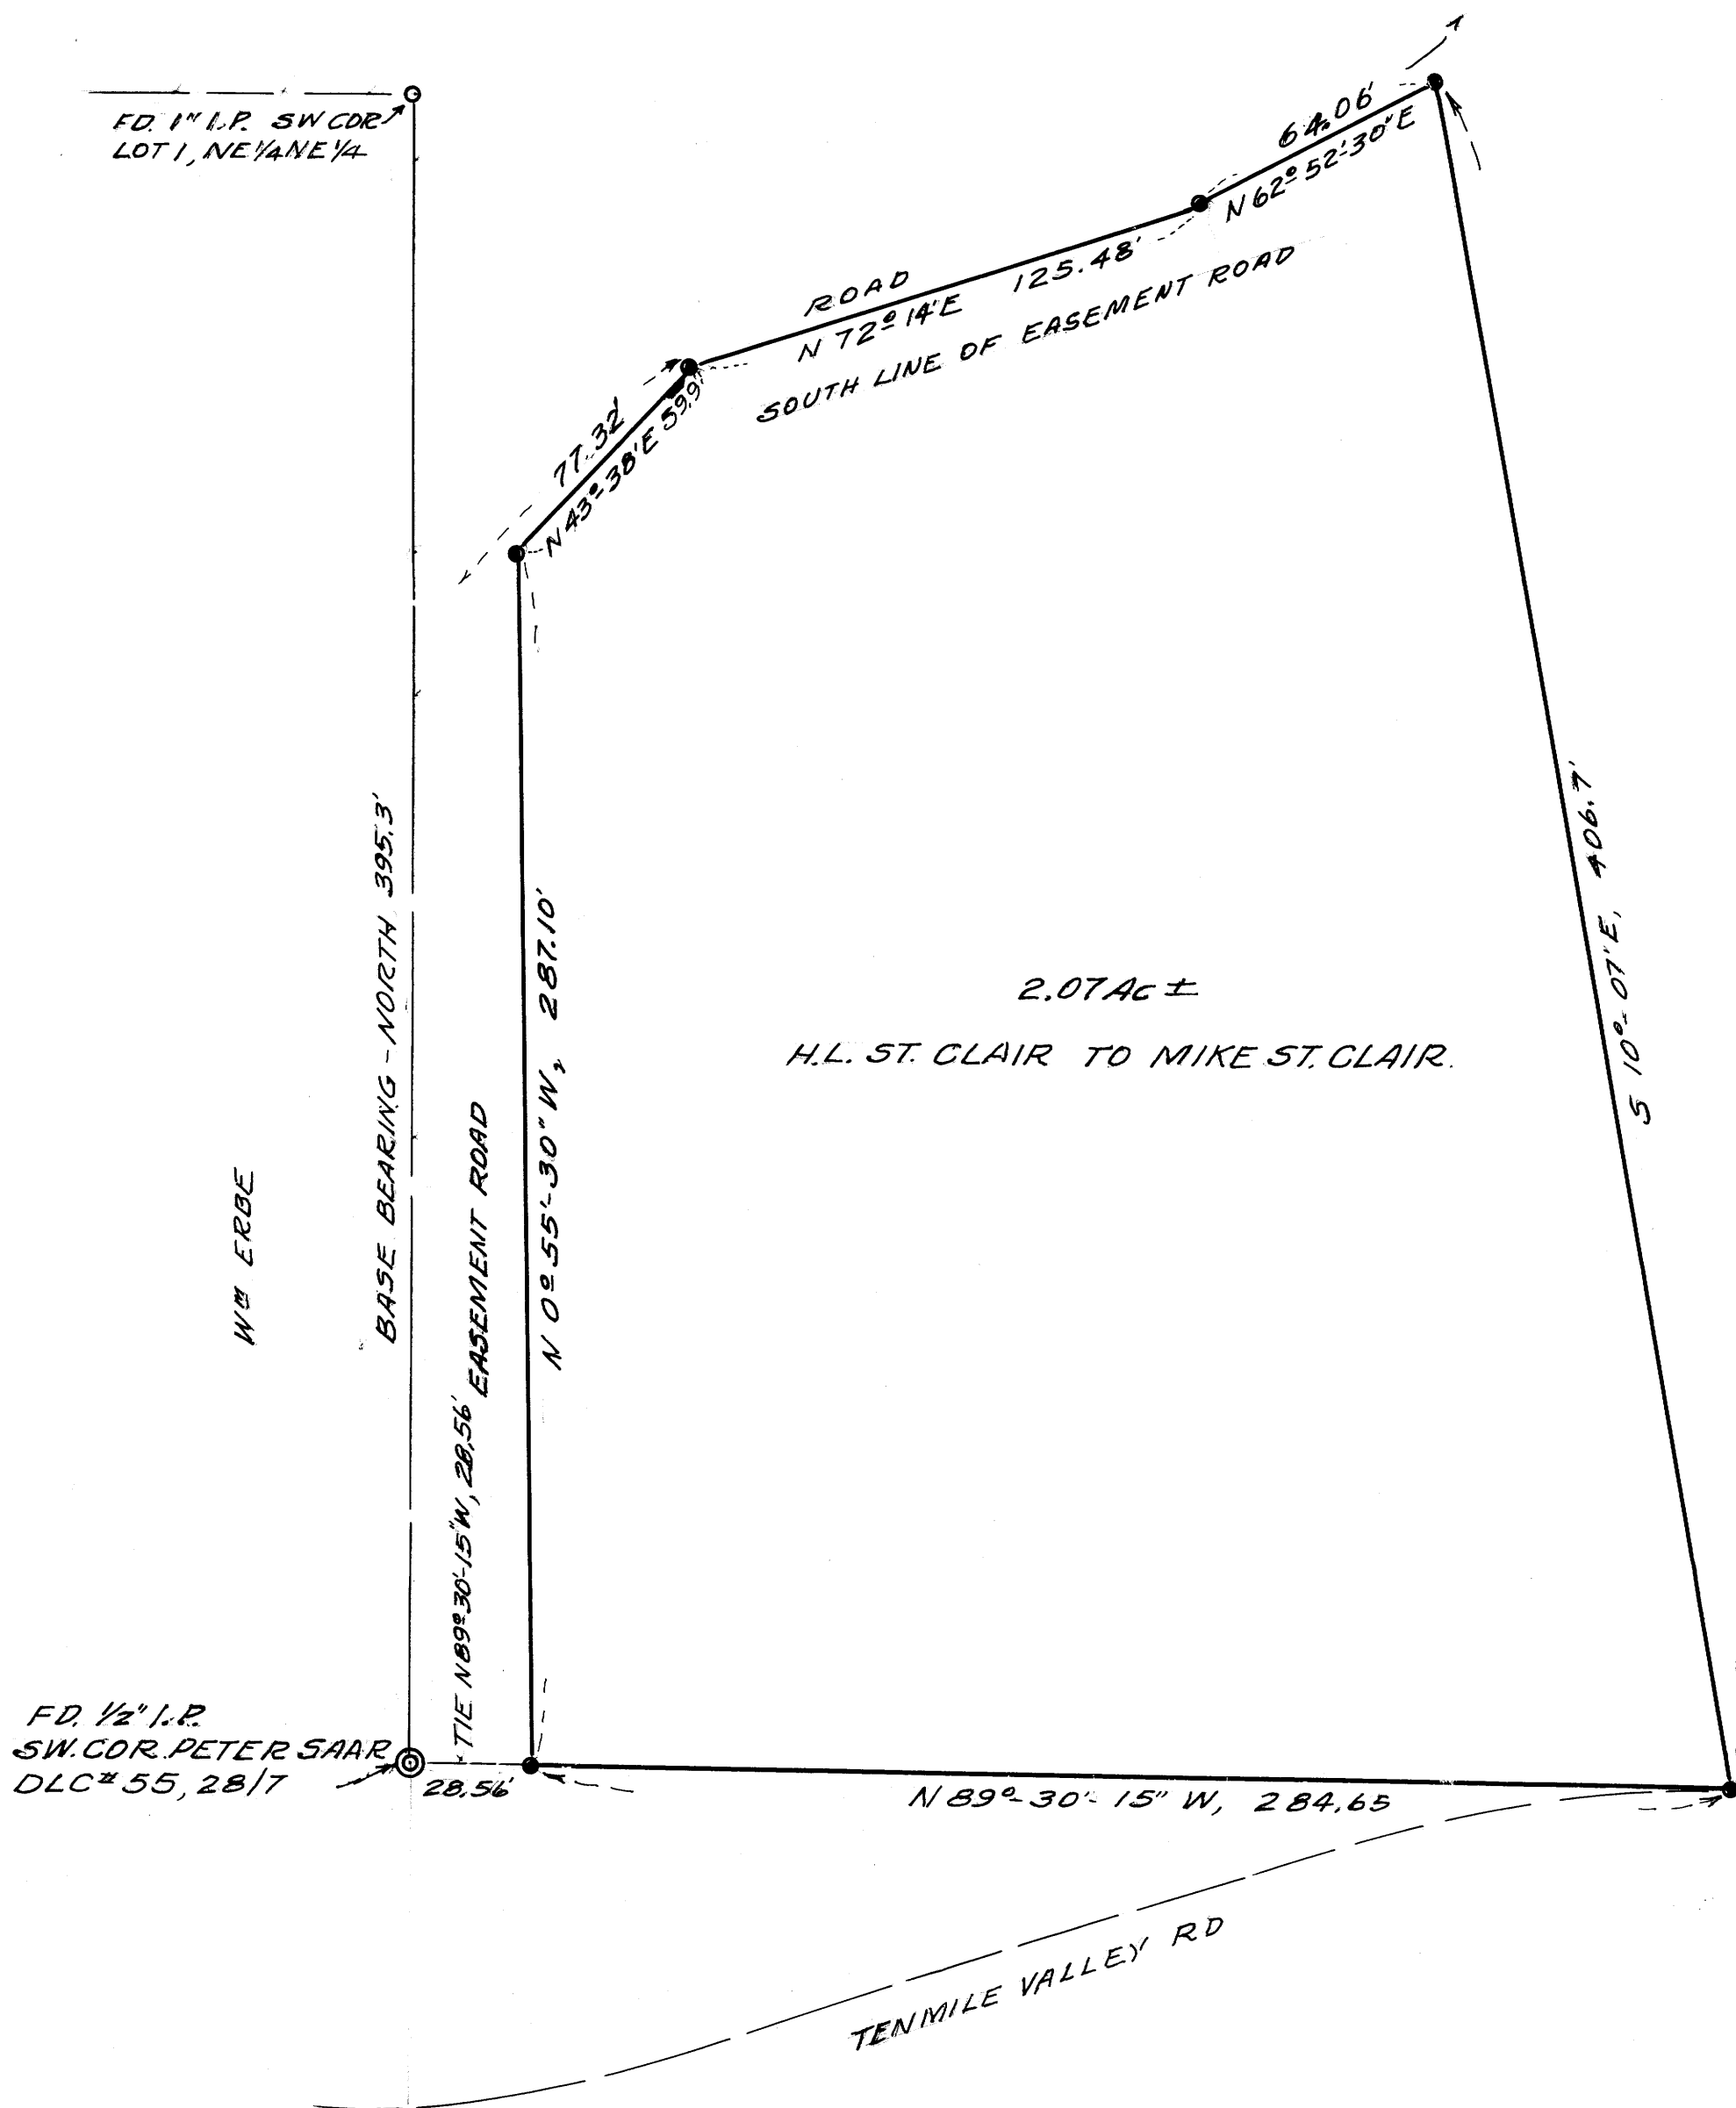

BASE BRG. NORTH
STEWART SURVEY
BOYER 3/1970 M 39-44
● SET 5/8x30 RIENT. ROD.

REGISTERED
PROFESSIONAL
LAND SURVEYOR

Herbert R. Northcraft

OREGON
JULY 8, 1966
HERBERT L. NORTHCRAFT
750