

LR

M 46 - 20

SURVEY FOR DEED DESCRIPTION


SECTION 22, T. 27 S., R. 6 W. W.M.

FOR CHARLES O'NEAL

BY MILO GODFREY

JULY 30, 1972

SCALE 1" = 100'

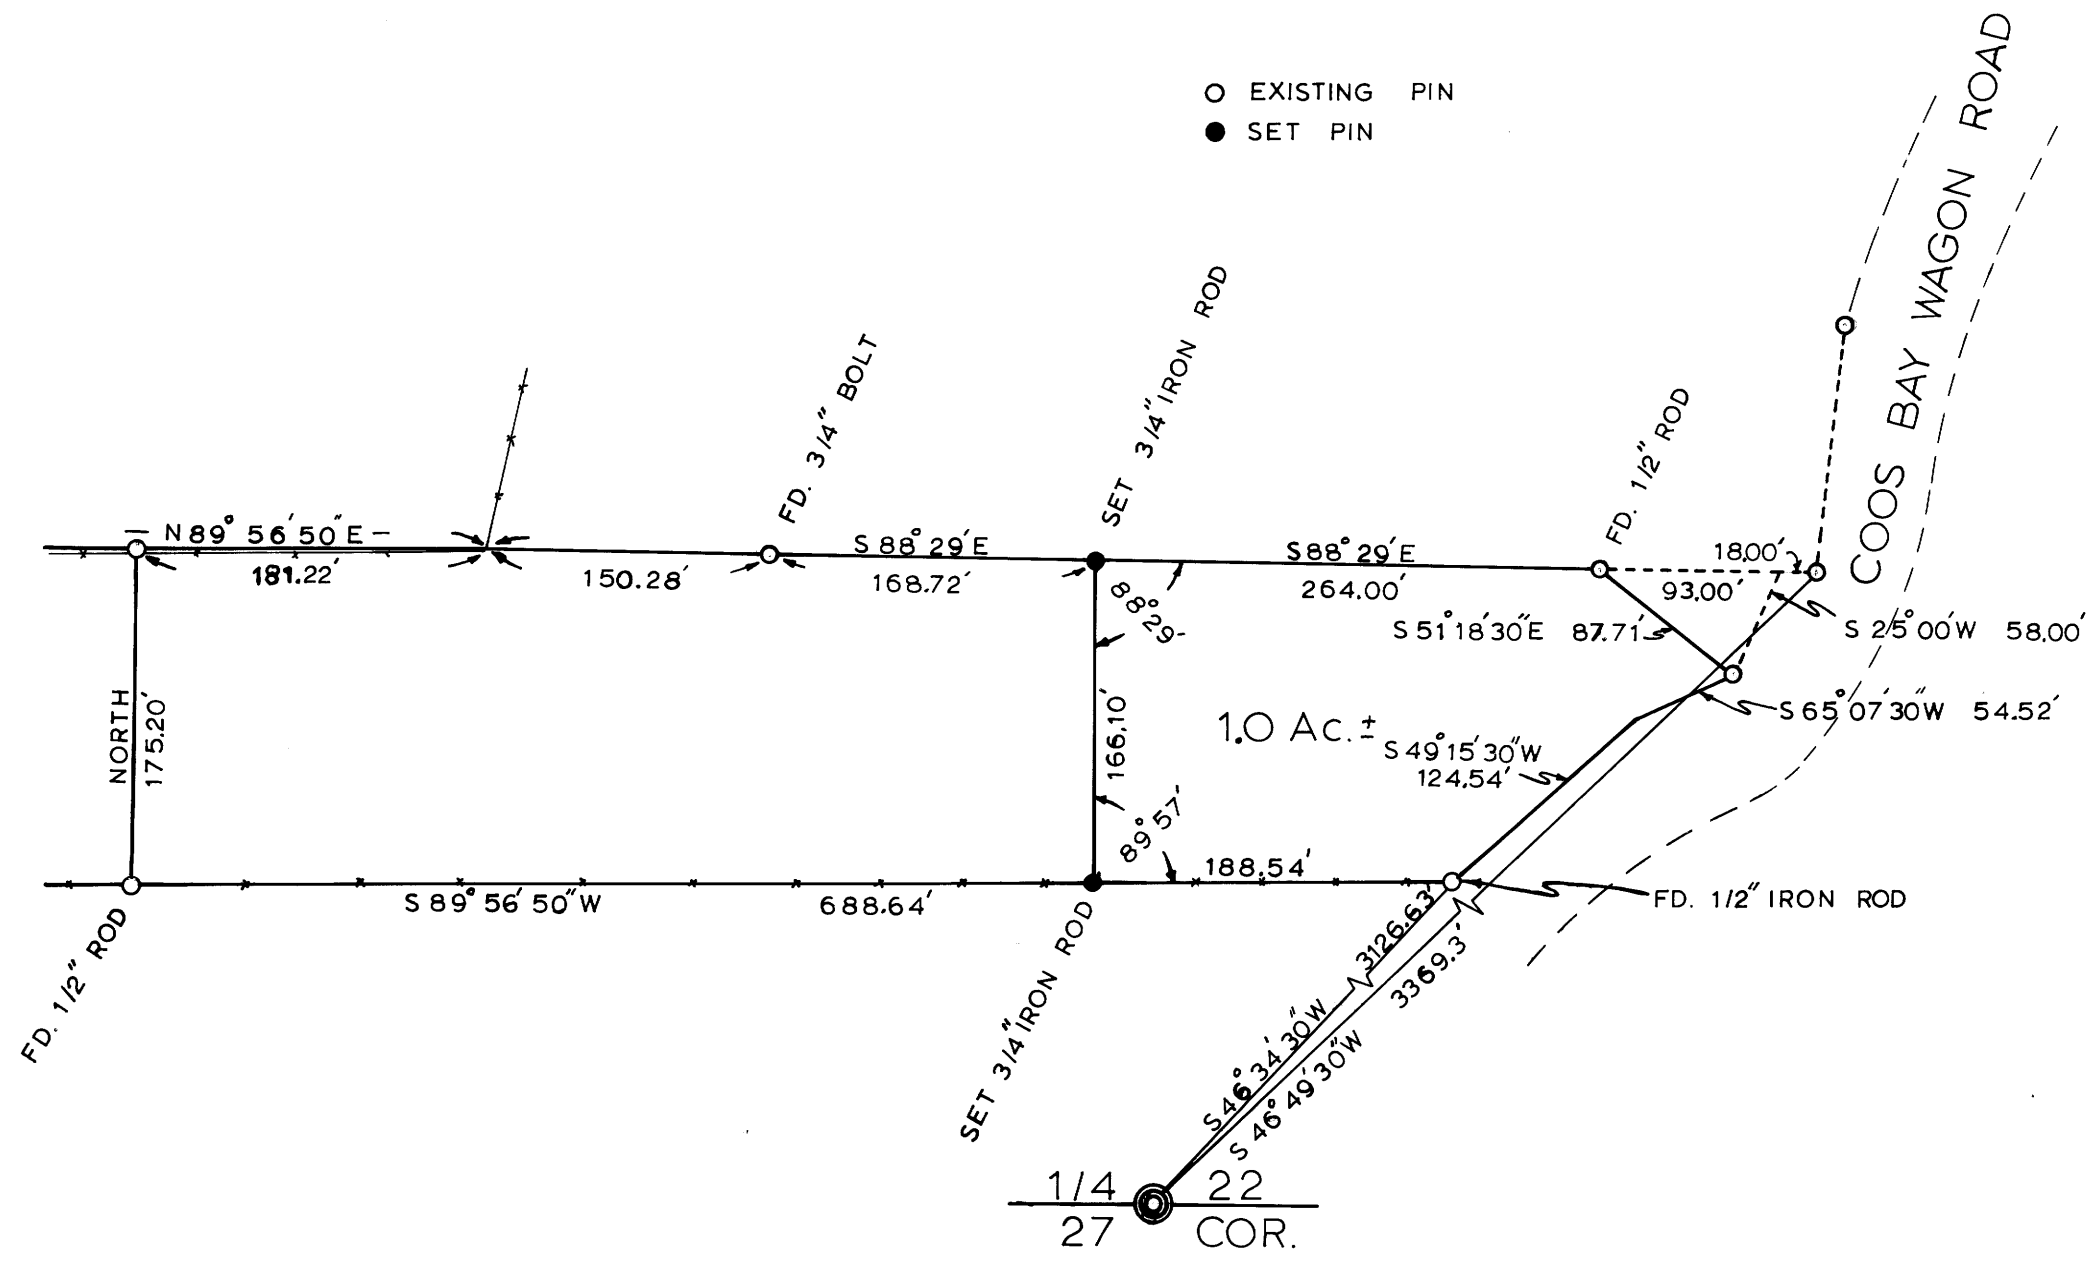

Milo E. Godfrey

BASED ON BAUGHMAN'S SURVEY
M 31-17

M 46 - 20