
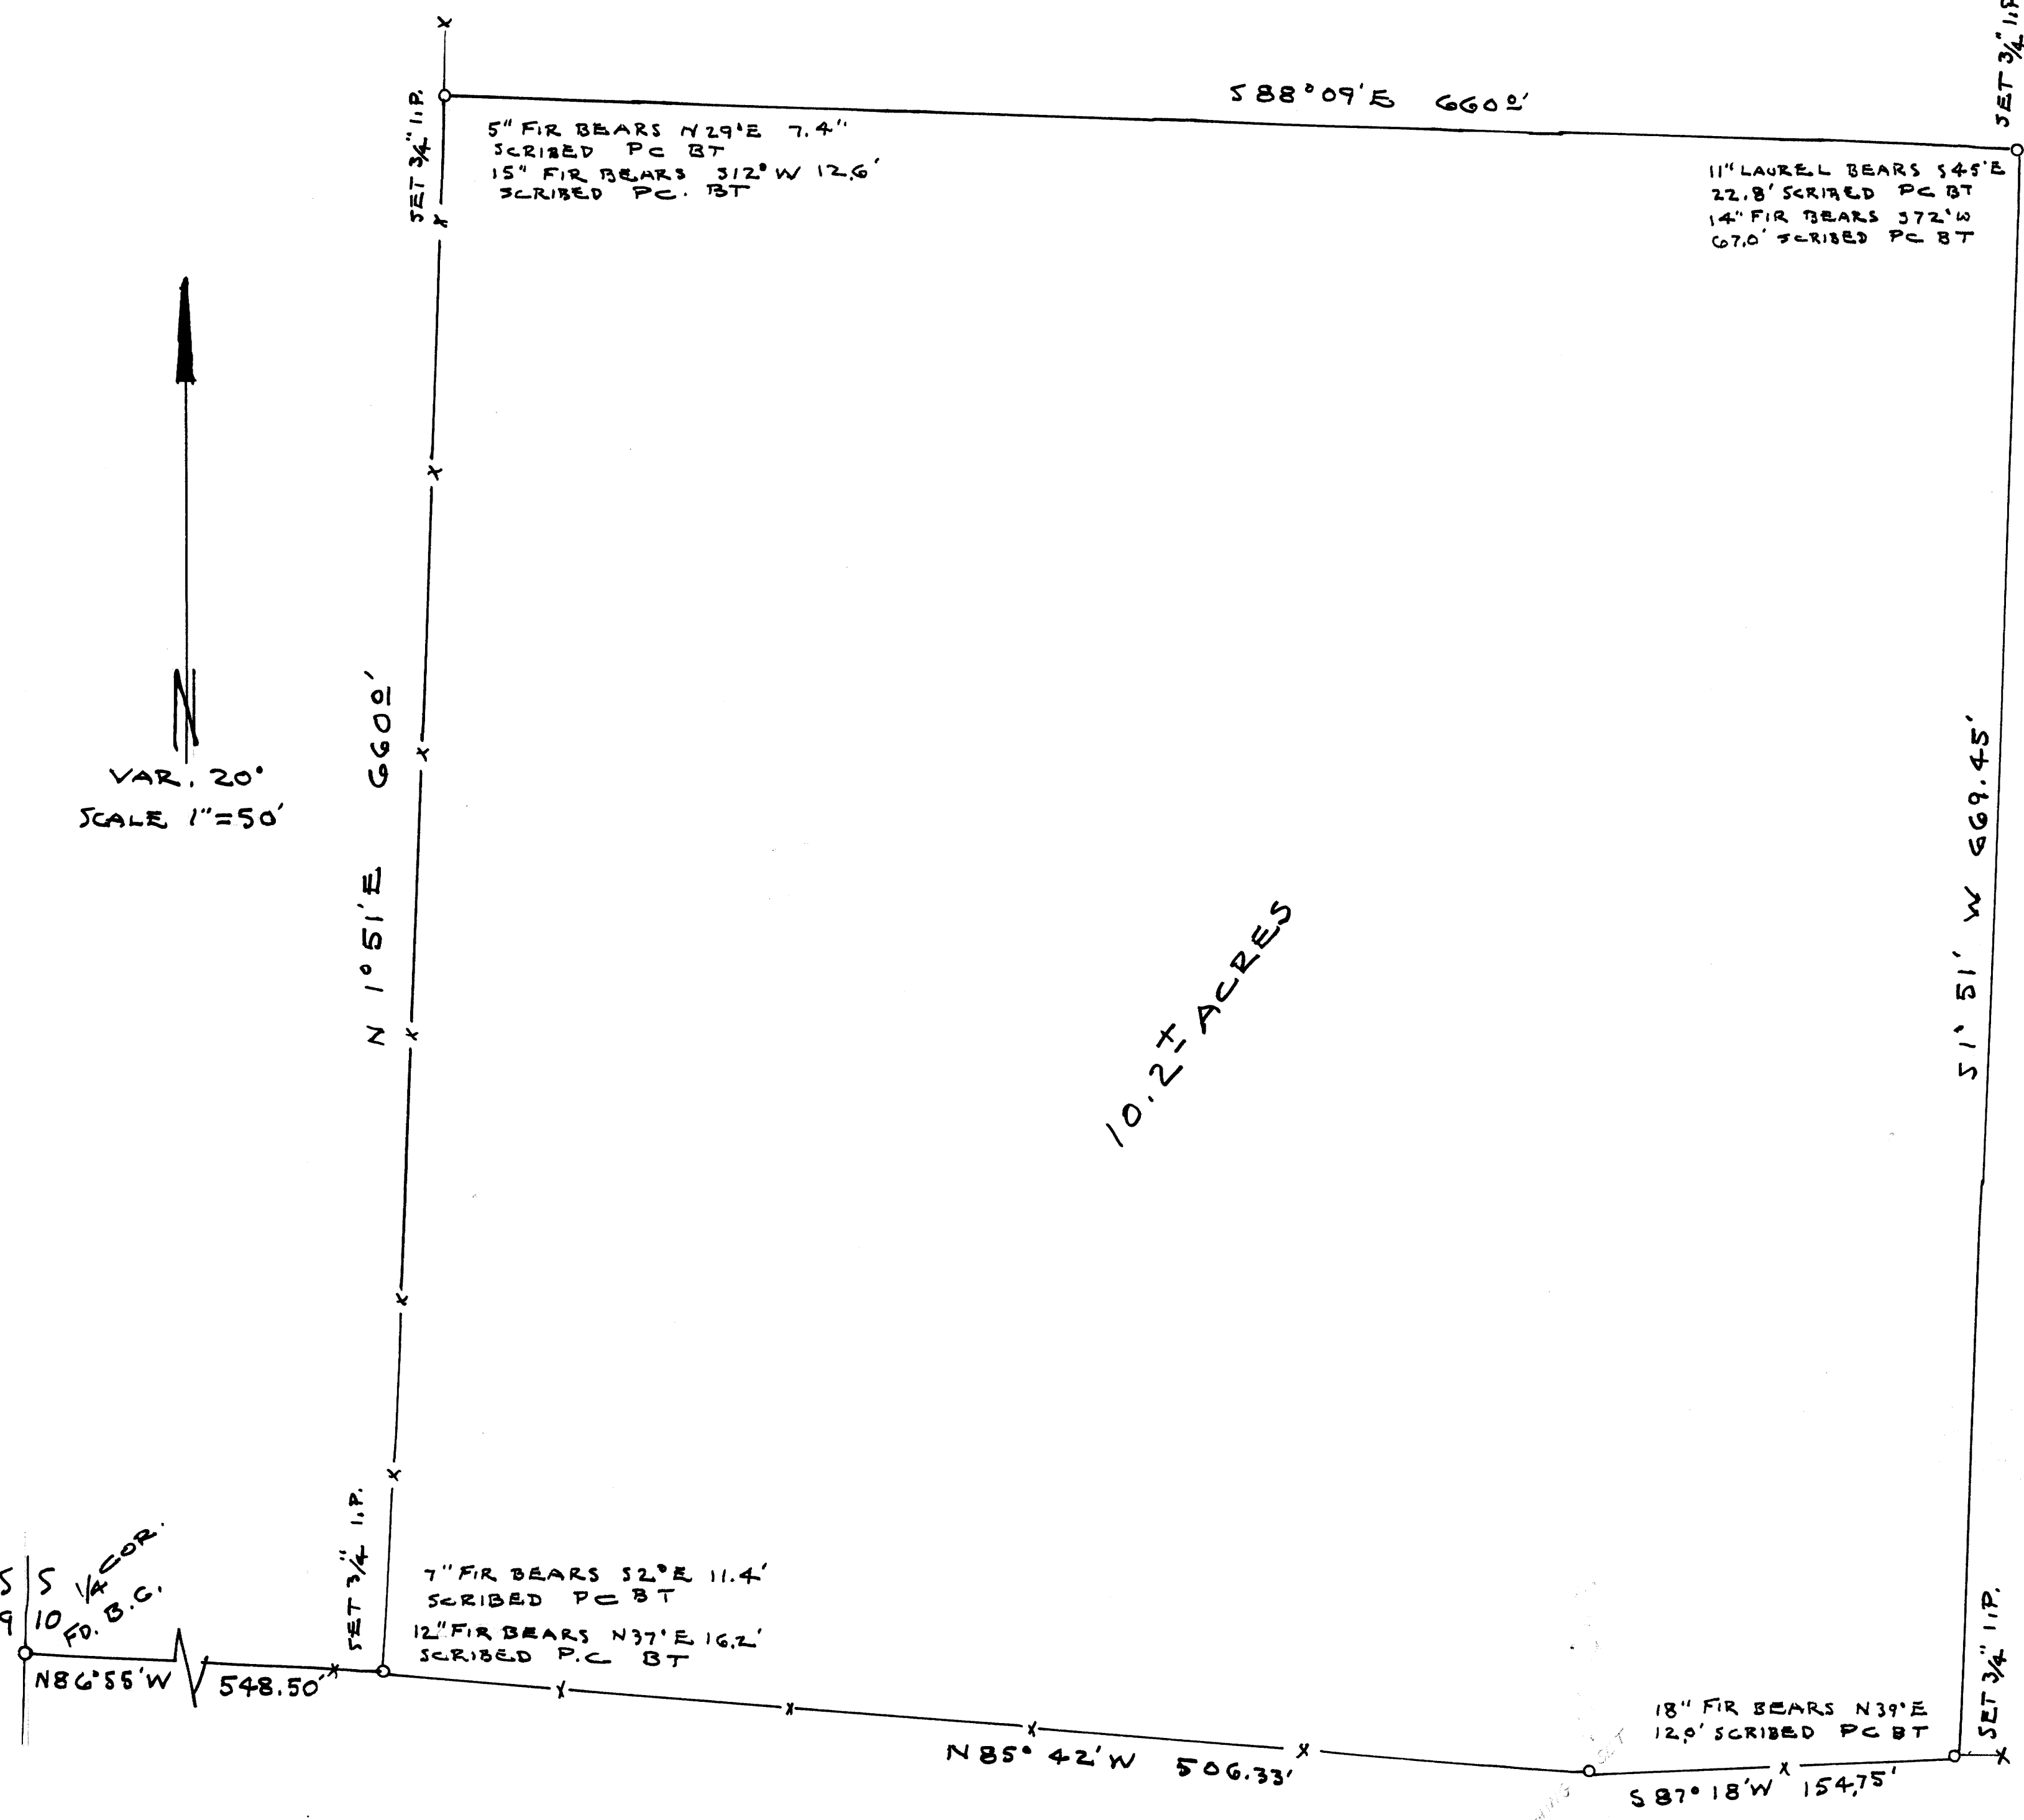


FILED
RECEIVED

SEP 6 1972

COUNTY SURVEYOR
DOUGLAS COUNTY, ORE.

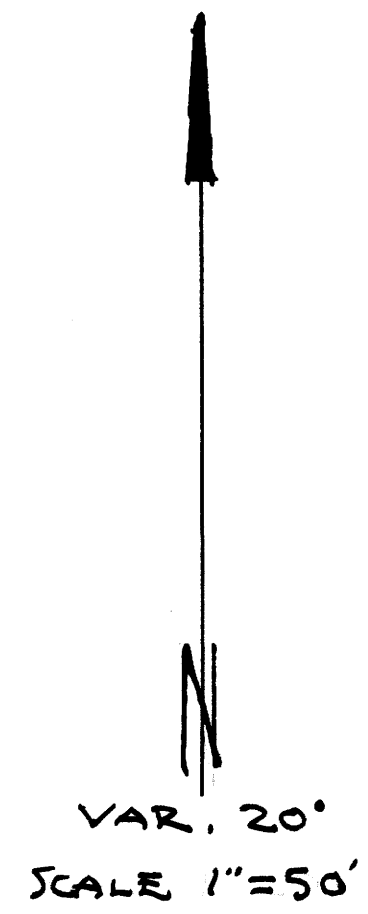

SURVEY IN N.W. 1/4 SEC. 10 T 28 S R 7 W
SURVEYED FOR - WALTER OSBORNE
SURVEYOR - JAMES W. BYRON
AUG. 1972

REGISTERED
PROFESSIONAL
LAND SURVEYOR

James W. Byron
OREGON
NOVEMBER 8, 1963
JAMES W. BYRON
303

COUNTY SURVEYORS FILE DATA
DO NOT REMOVE FROM OFFICE