

SURVEY IN SEC. 31, T26S, R5W & SEC. 36, T26S, R6W, W.M., DOUGLAS CO., ORE.
 Surveyed for Theron W. Jones by Victor M. McLind
 September 1972

COUNTY SURVEYORS FILE DATA
 DO NOT REMOVE FROM OFFICE


FILED
 RECEIVED

OCT 4 1972

COUNTY SURVEYOR
 DOUGLAS COUNTY, ORE.

Scale : 1" = 100'

o ~ Indicates Set $\frac{5}{8}$ " Iron Rod

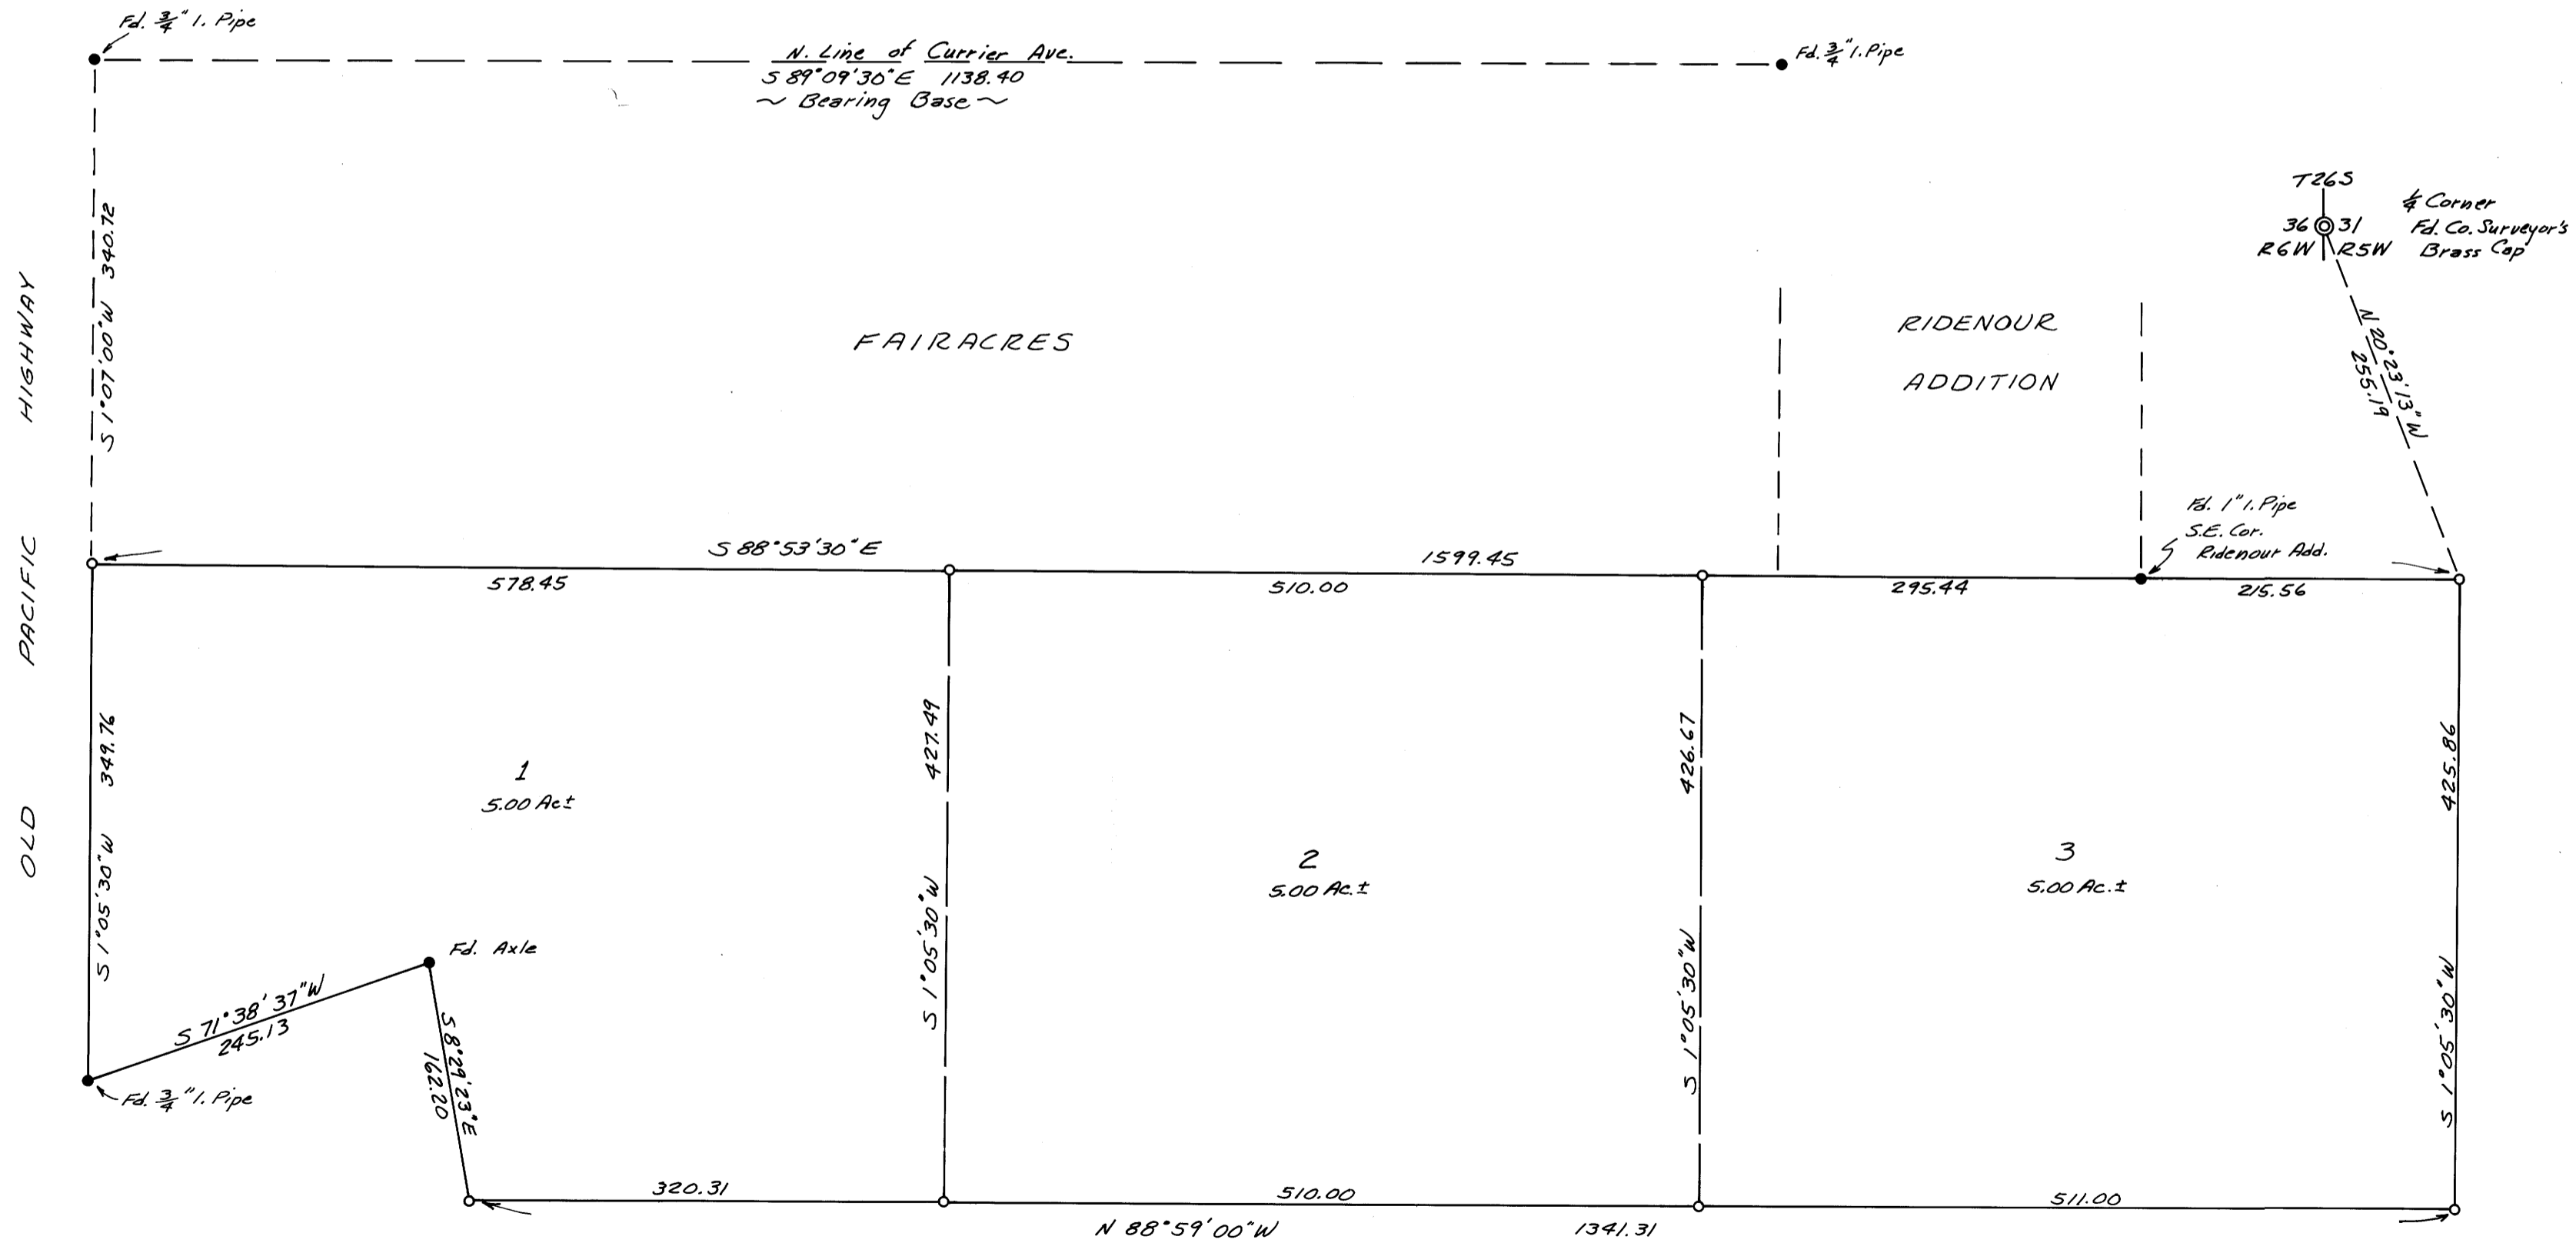

REGISTERED
 PROFESSIONAL
 LAND SURVEYOR

Victor M. McLind

OREGON
 JULY 17, 1970
 VICTOR M. MCLIND
 134

P. OF FILE M 46 - 62

M 46 - 62