


FILED
RECEIVED
OCT 31 1972
COUNTY SURVEYOR
DEWEE'S COUNTY, ORE

SEC. 32 T. 28 S. R. 7 W. W.M.

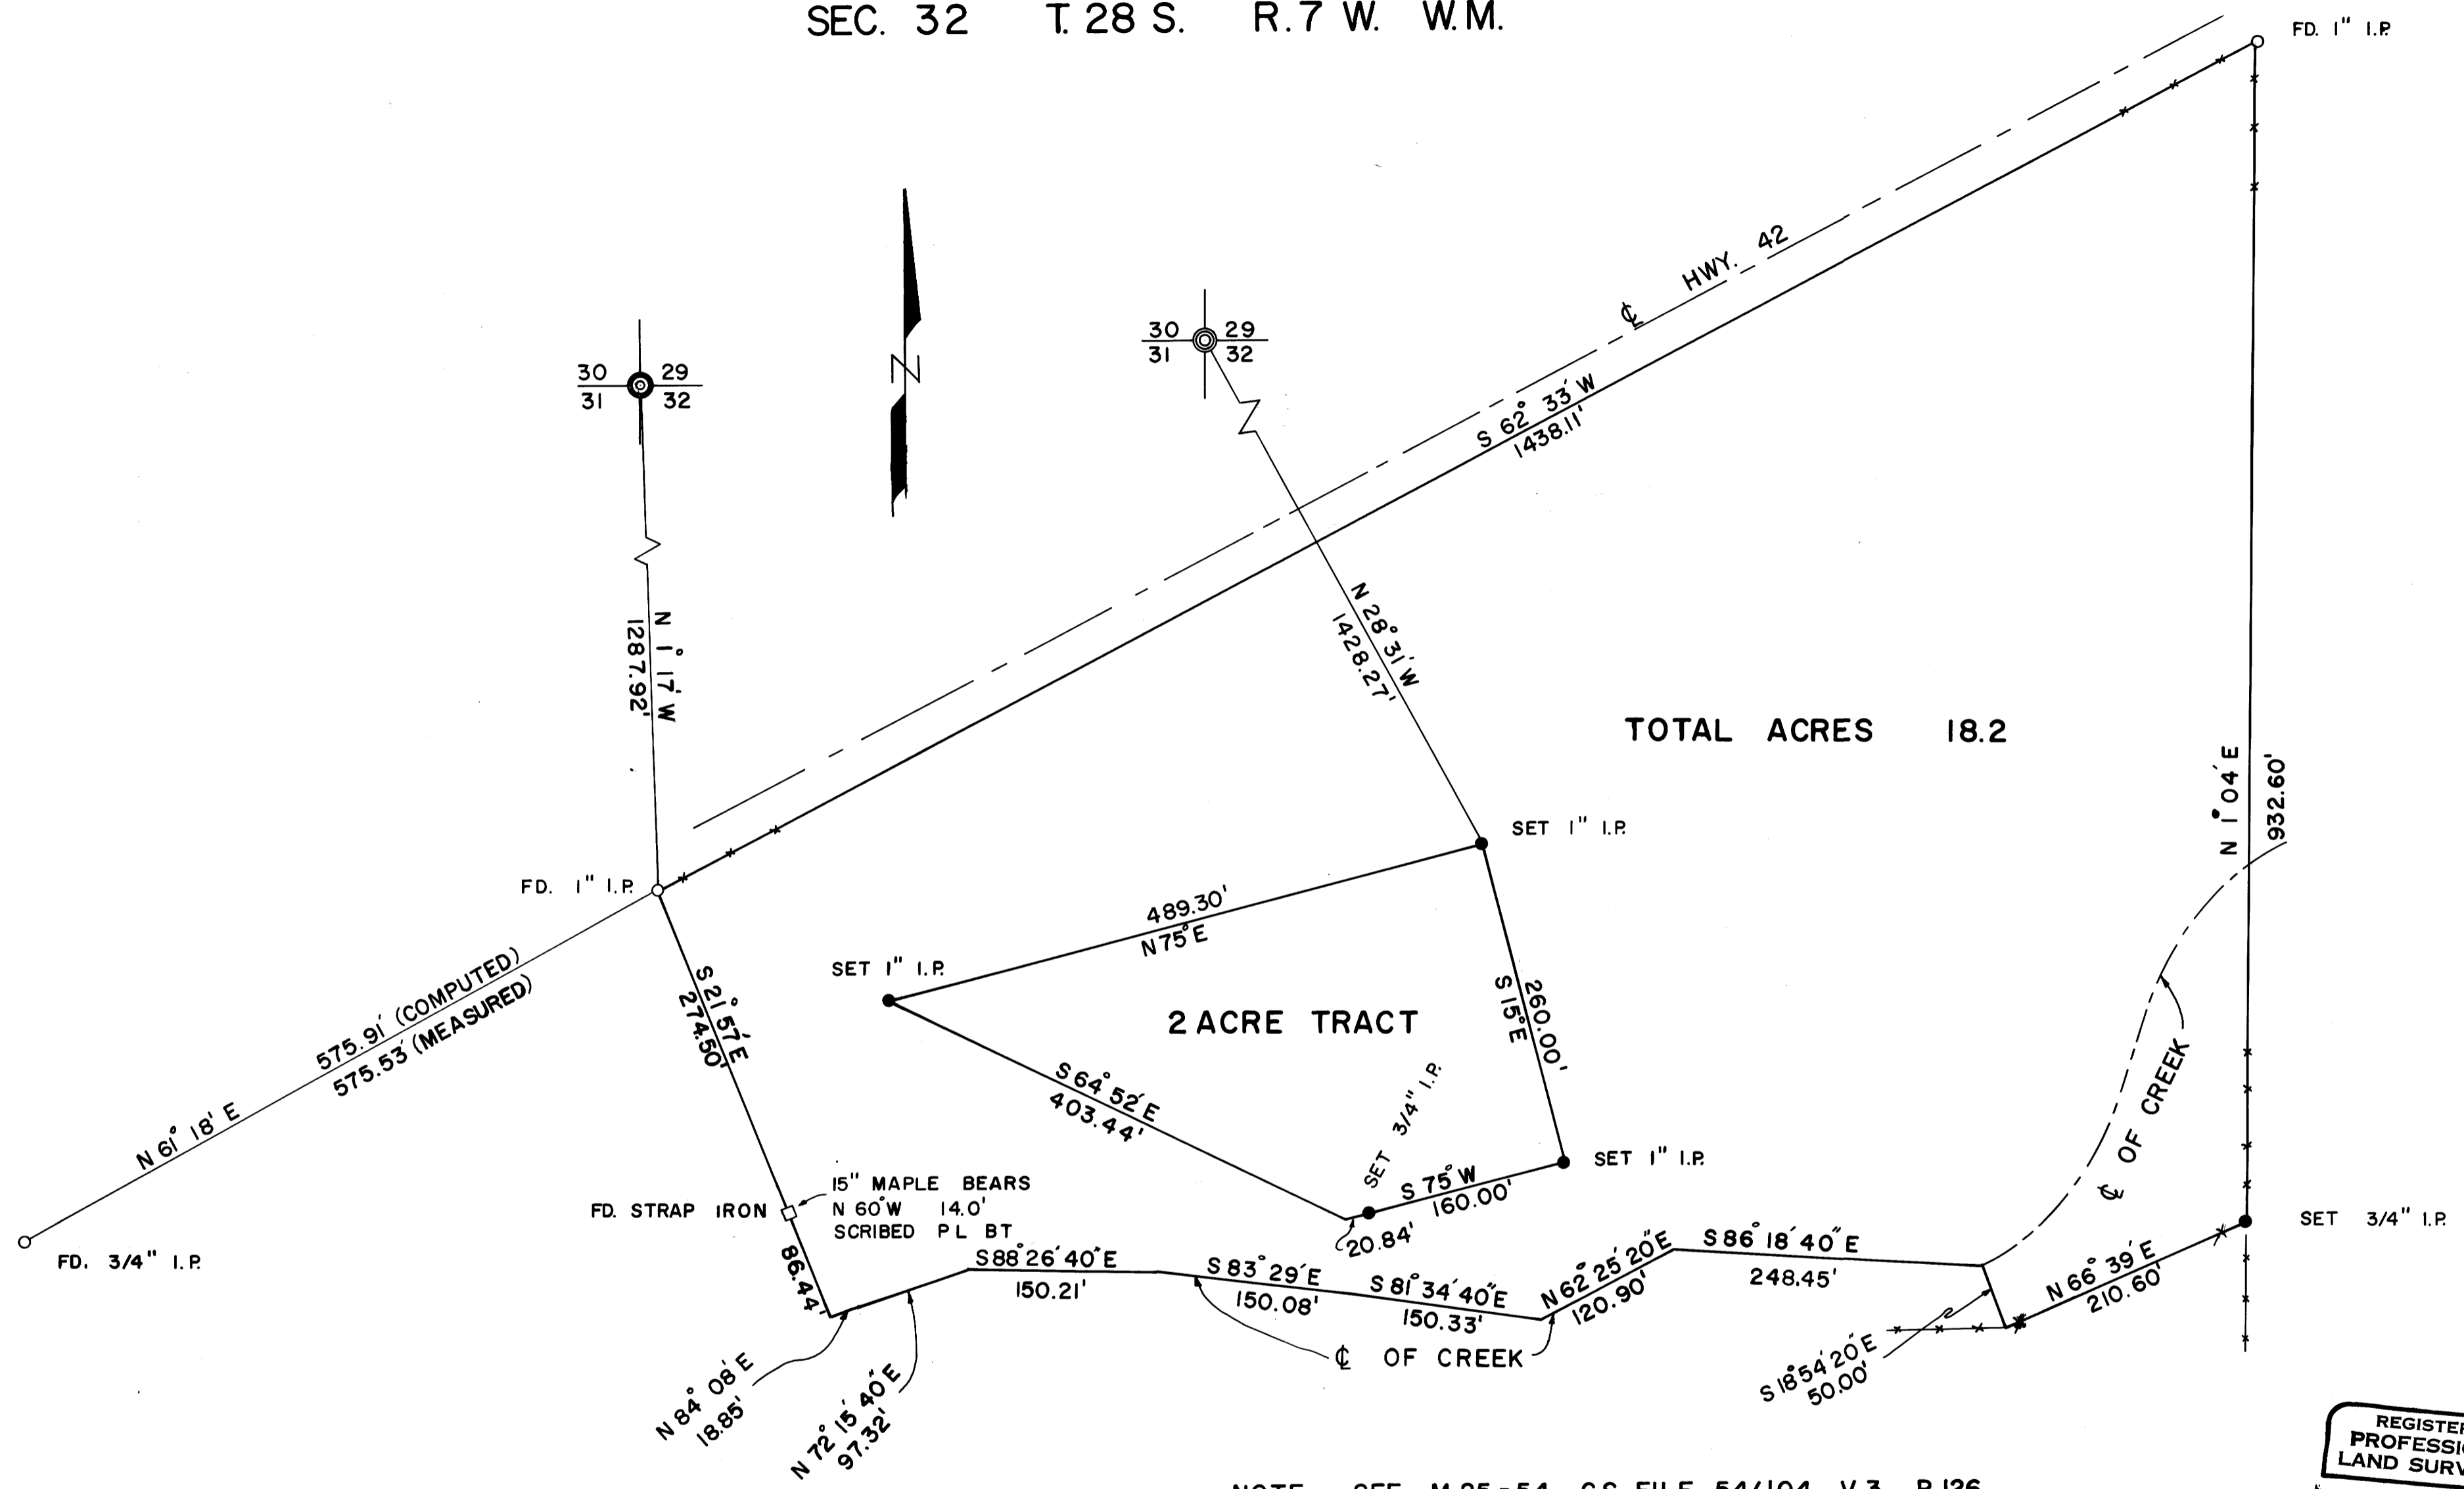

TOTAL ACRES 18.2

2 ACRE TRACT

NOTE SEE M 25-54, C.S. FILE 54/104, V.3 P.126
BEARINGS BASED ON C.S. FILE 54/104

OWNERS WAYNE BREITENBUCHER &
NICK LOZANO

SURVEYED BY JAMES W. BYRON OCTOBER 1972

SCALE 1" = 100'

COUNTY SURVEYORS FILE DATA
DO NOT REMOVE FROM OFFICE

REGISTERED
PROFESSIONAL
LAND SURVEYOR

James W. Byron

OREGON
NOVEMBER 9, 1953
JAMES W. BYRON
303