


**SURVEY TO SET PROPERTY CORNERS**  
 SITUATE IN SECTION 21, T.26S., R.4W.W.M.

**FOR: KENT BAYLISS**  
**BY: BAUGHMAN SURVEYING SERVICE**  
 SEPTEMBER 1972


SCALE 1" = 50'

COUNTY SURVEYORS FILE DATA  
 NOT REMOVE FROM OFFICE

Found 3/4" I.P. 30' 30'  
 FILED RECEIVED  
 OCT 31 1972  
 COUNTY SURVEYOR  
 DOUGLAS COUNTY, ORE.

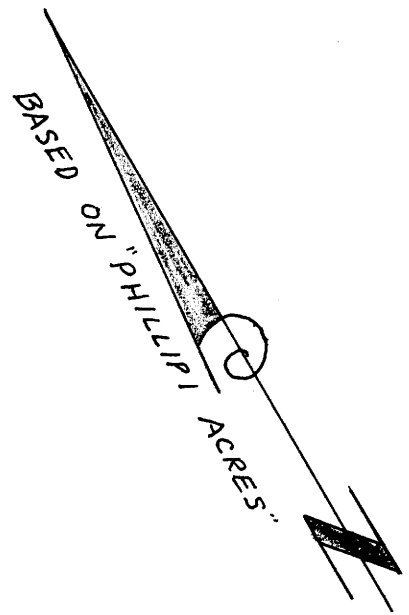

o--- DENOTES 3/8" IRON ROD SET

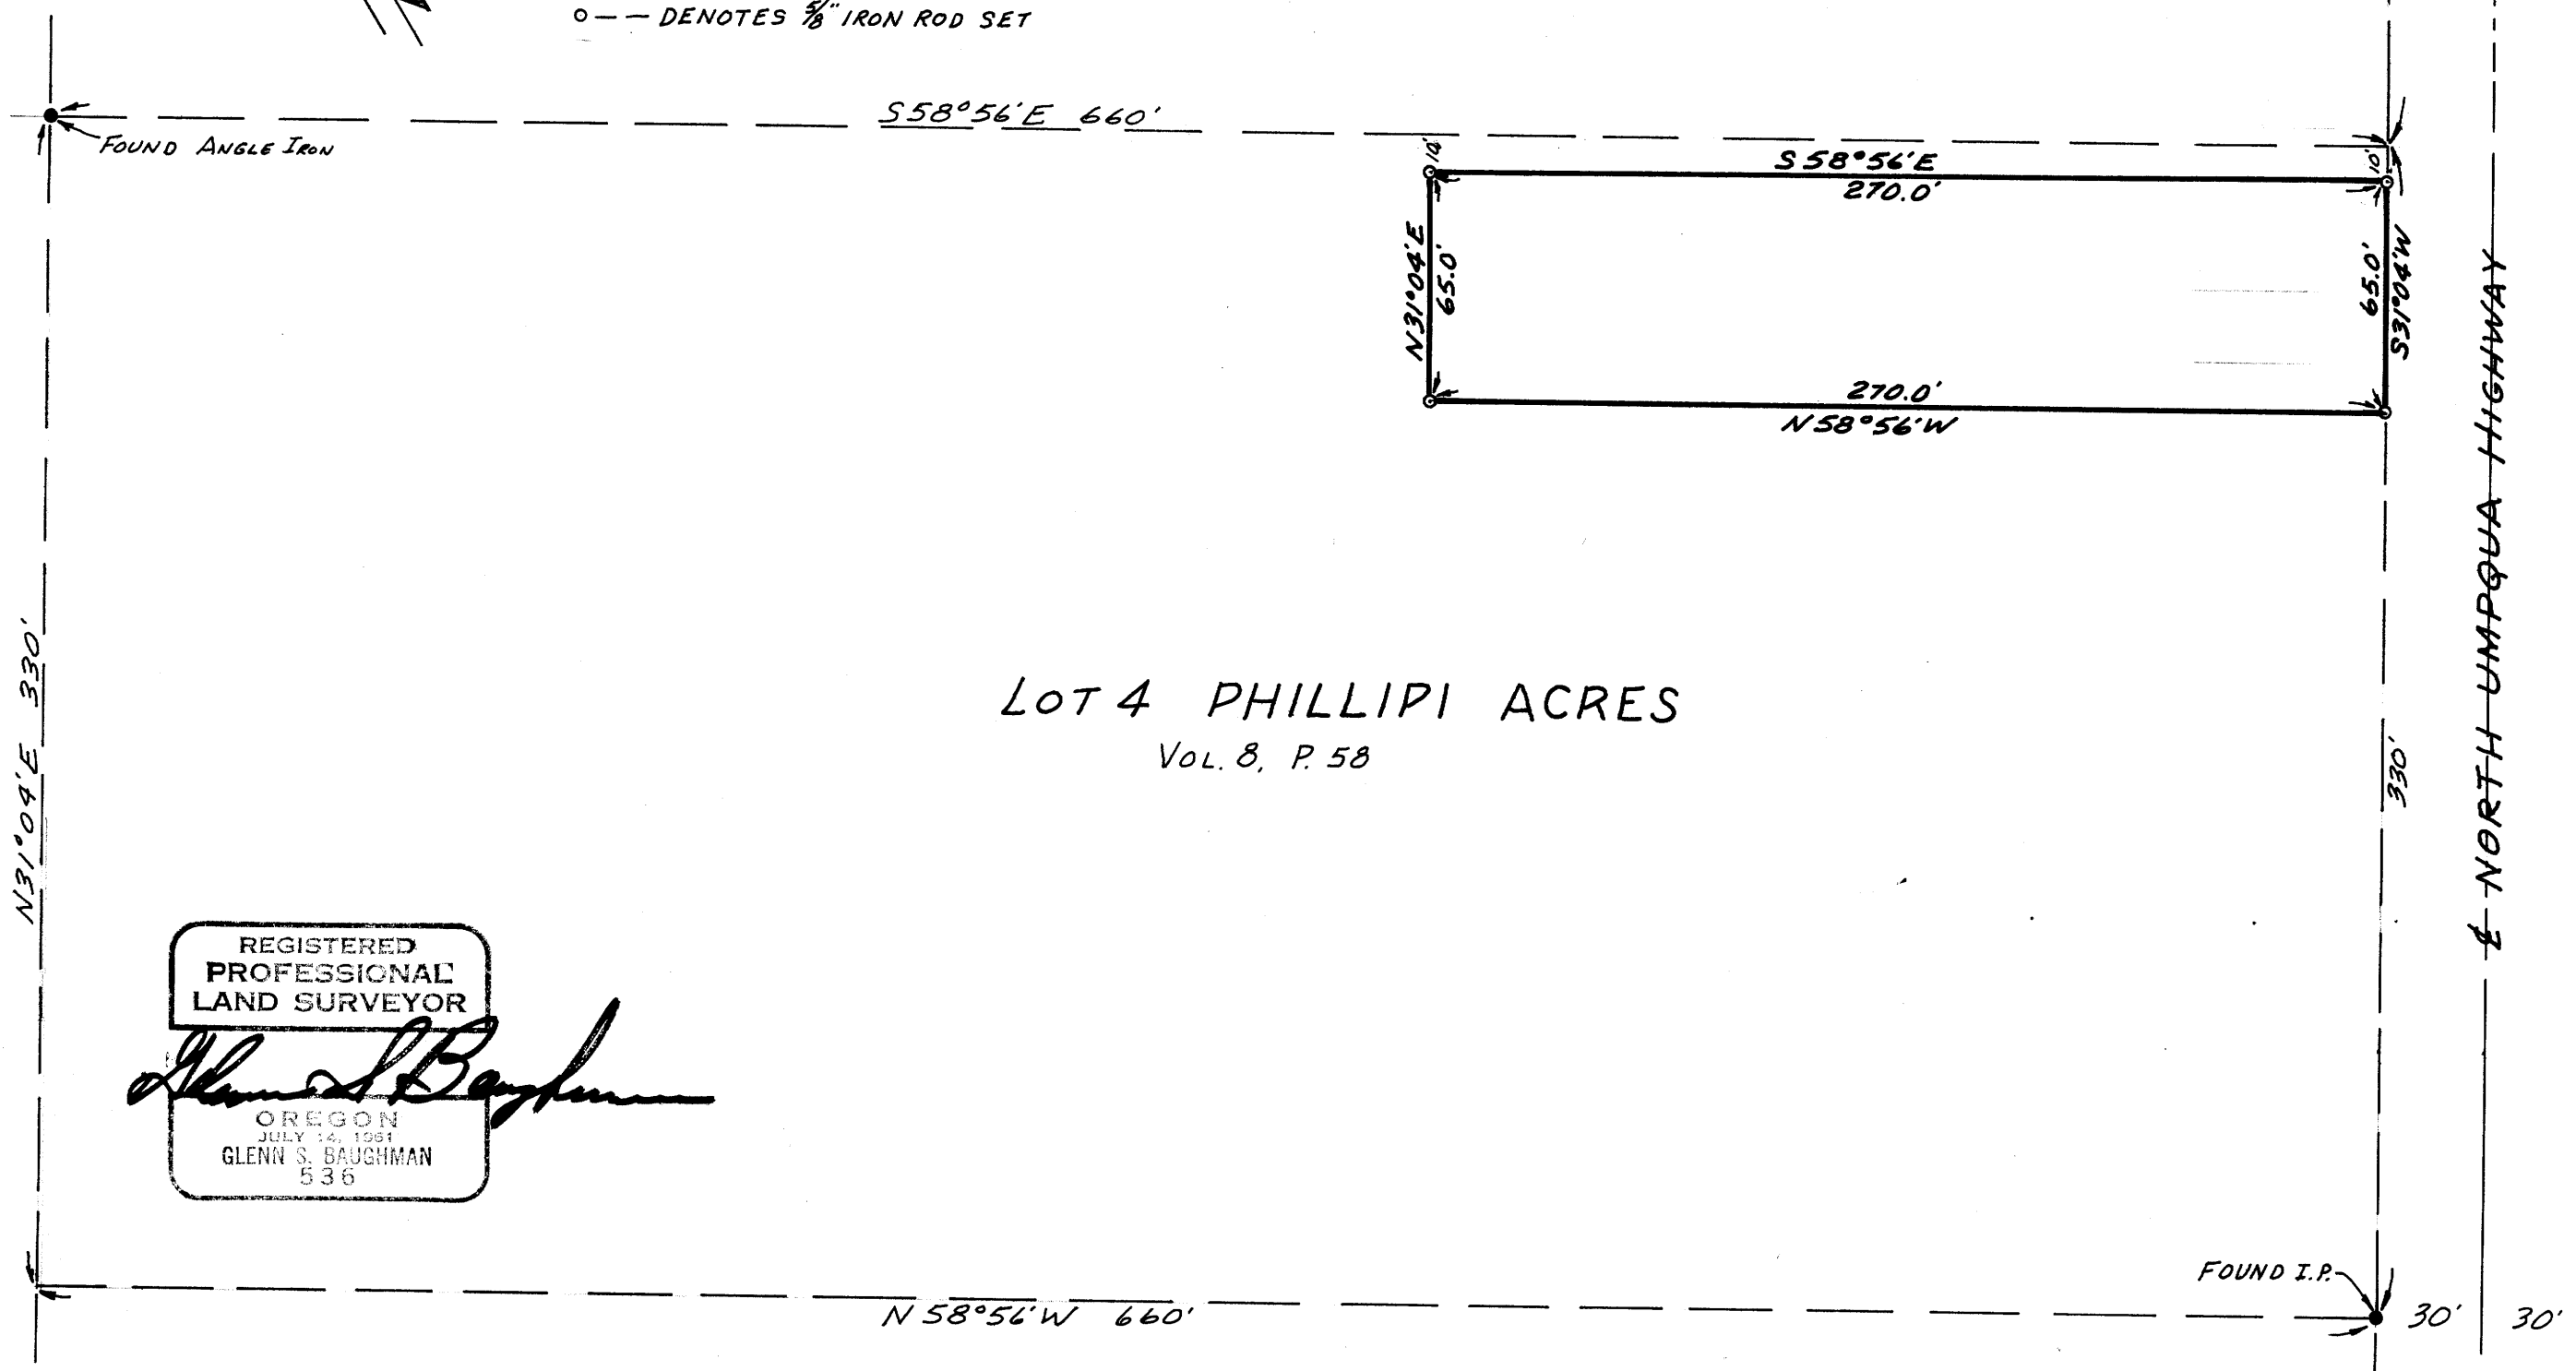

LOT 4 PHILLIPI ACRES  
 Vol. 8, P. 58

REGISTERED  
 PROFESSIONAL  
 LAND SURVEYOR  
*Glenn S. Baughman*  
 OREGON  
 JULY 14, 1961  
 GLENN S. BAUGHMAN  
 536

NORTH UMPQUA HIGHWAY

SEE M 47-21  
 NEW ROAD R/W. 12/72

EAB

MAP FILE M-46 - 76