

FILED *LR*
RECEIVED *2/3*

FEB 26 1973


COUNTY SURVEYOR
DOUGLAS COUNTY, ORE

SURVEY TO SET PROPERTY CORNERS
IN D.L.C. #50, T. 29S., R. 5W.W.M.
& LOT 1, SEC 25, T29S, R5W.W.M.
FOR BOB JENKINS
BY BRUCE ROGERS
FEB., 1973
1" = 200'

REGISTERED
OREGON
LAND SURVEYOR

Bruce R Rogers

JULY 13 1964
BRUCE R. ROGERS
660

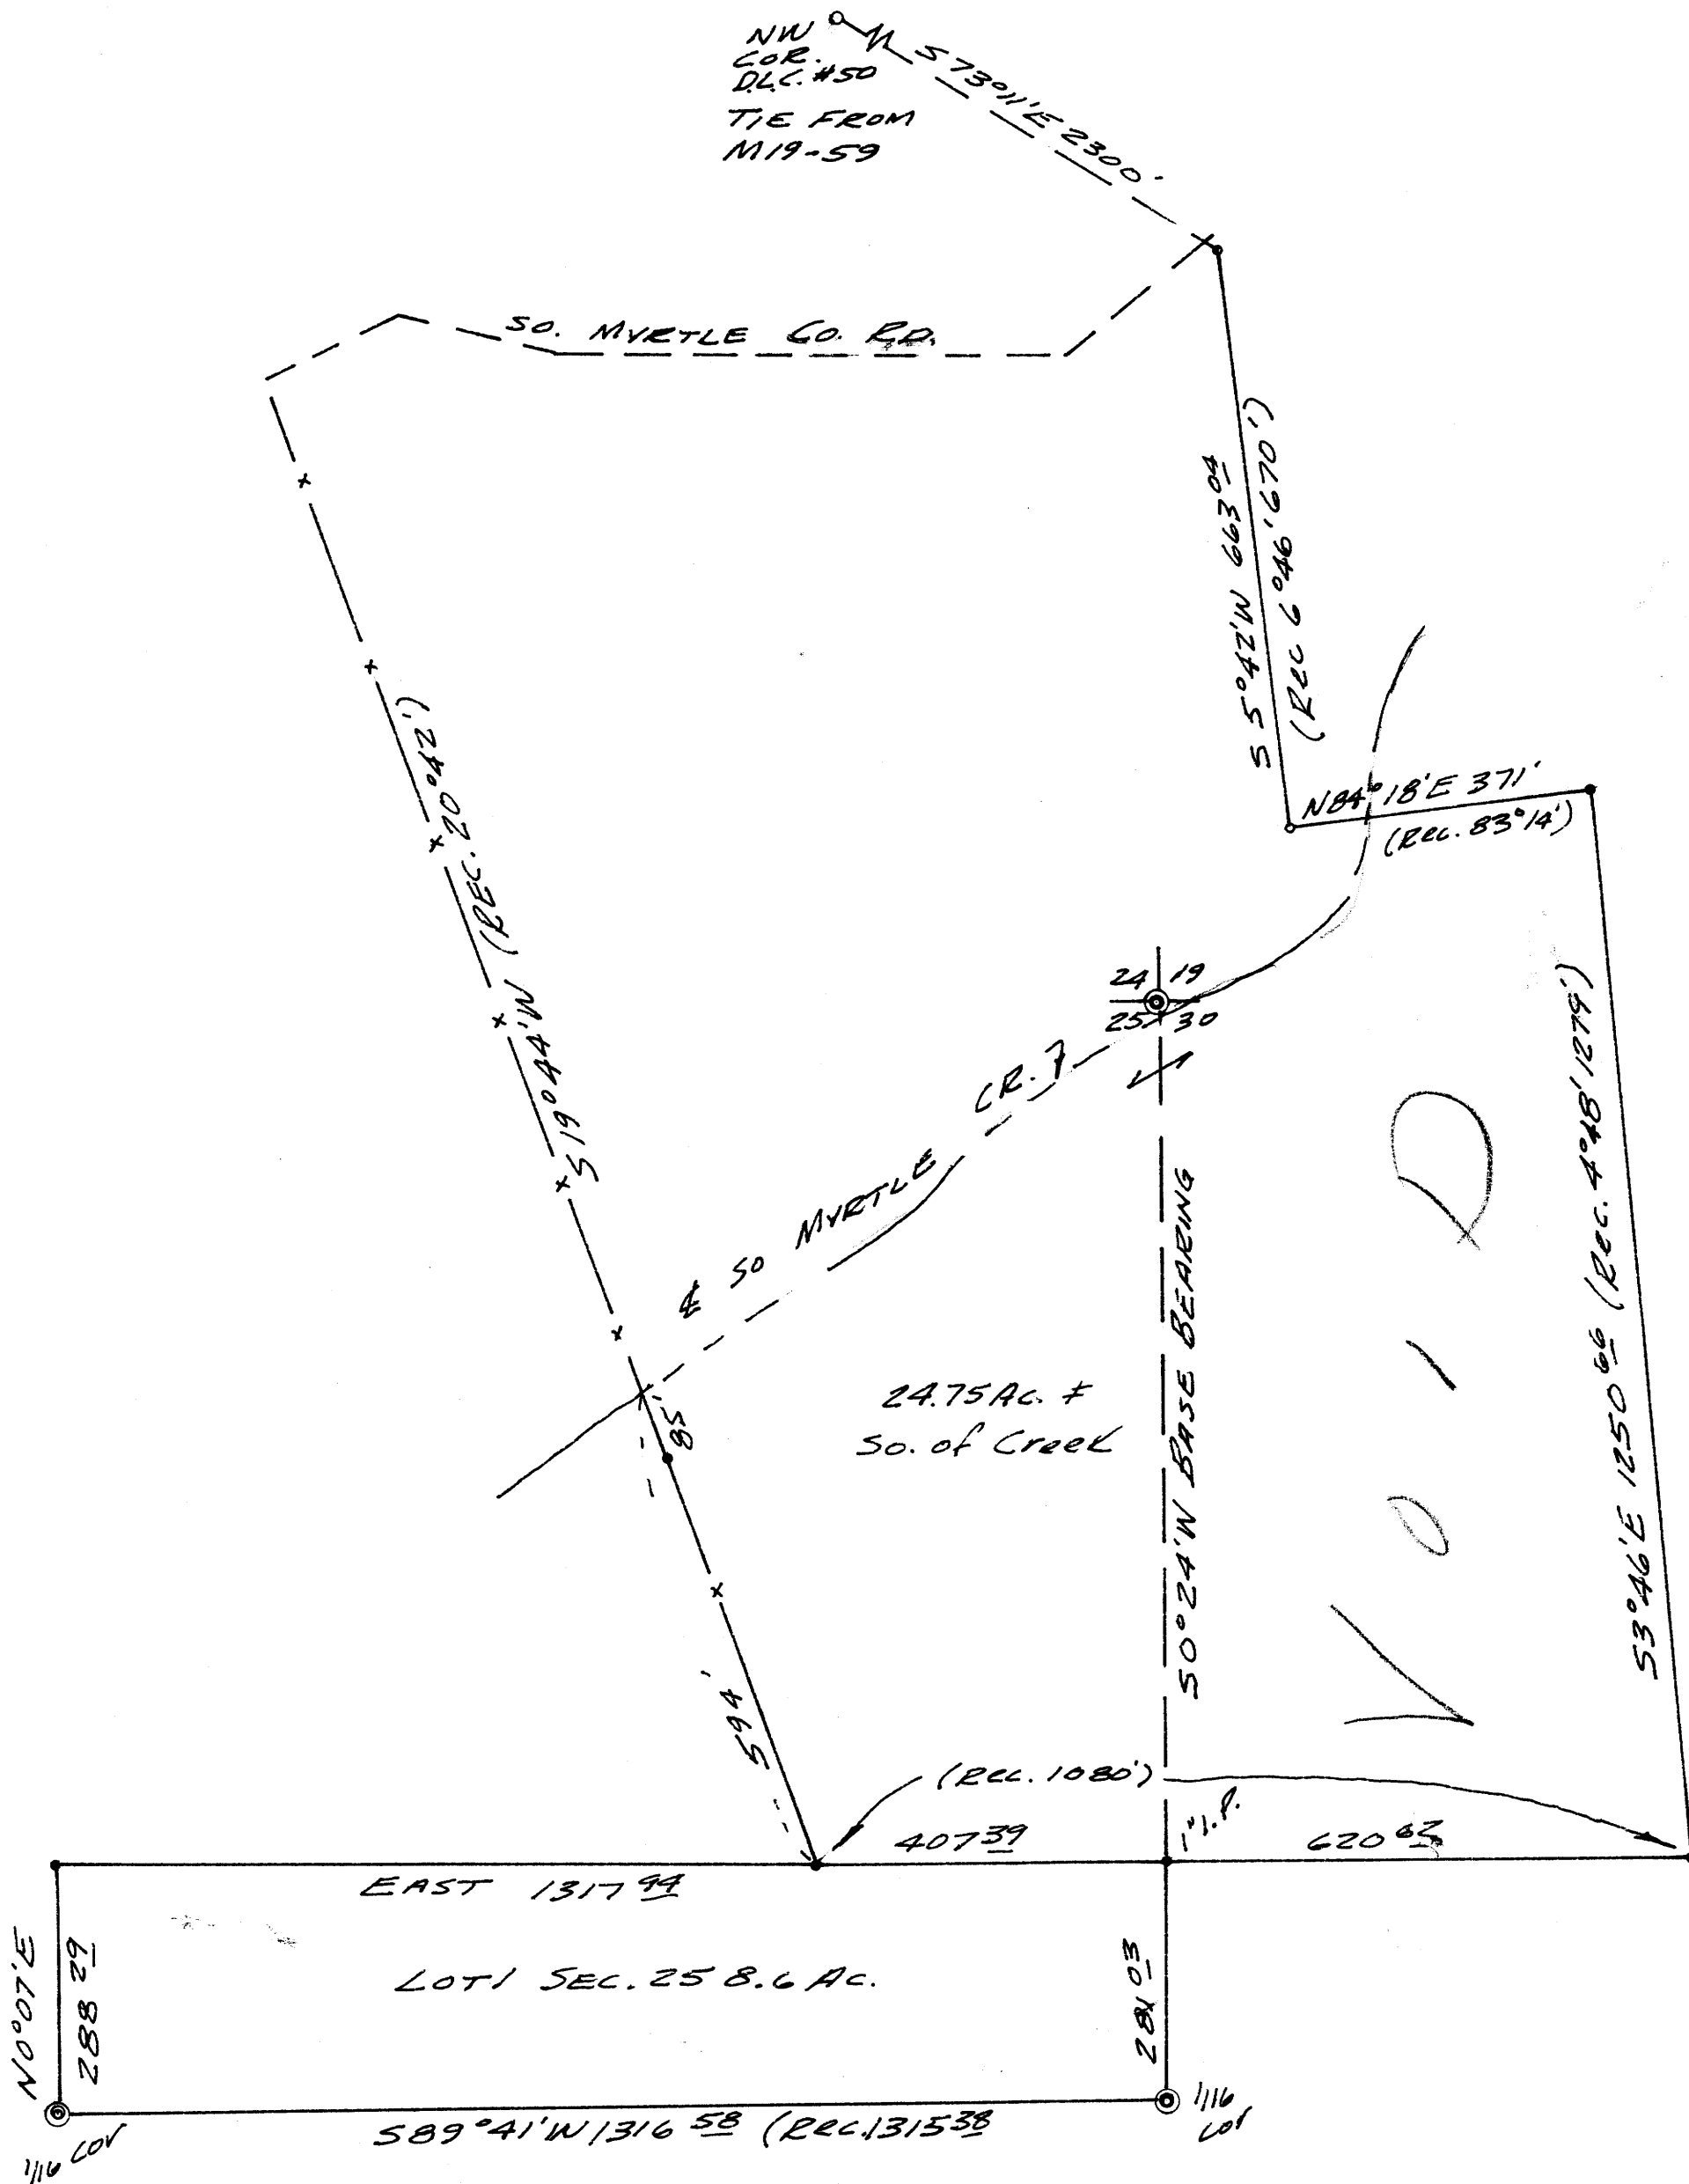

- o - Fd. I.P.
- ⊙ - Fd. GOVT. BRASS CAP
- - Set 5/8" Iron rod or 1" pipe

SEE M 48-37