

**SURVEY TO SET PROPERTY CORNERS  
 LOCATED IN SEC. 32, T.27S., R. 6 W., W.M.  
 FOR: MR. STANFORD BUELL  
 BY: BAUGHMAN SURVEYING SERVICE**

MARCH 1973

**COUNTY SURVEYORS FILE DATA SCALE 1" = 100'  
 DO NOT REMOVE FROM OFFICE**

FILED *LL*  
 RECEIVED


APR 3 1973

COUNTY SURVEYOR  
 DOUGLAS COUNTY, ORE.

LEGEND:  
 • SET  $\frac{5}{8}$ " I.P.

BASED ON M-44-17

P MAP FILE M 48-13

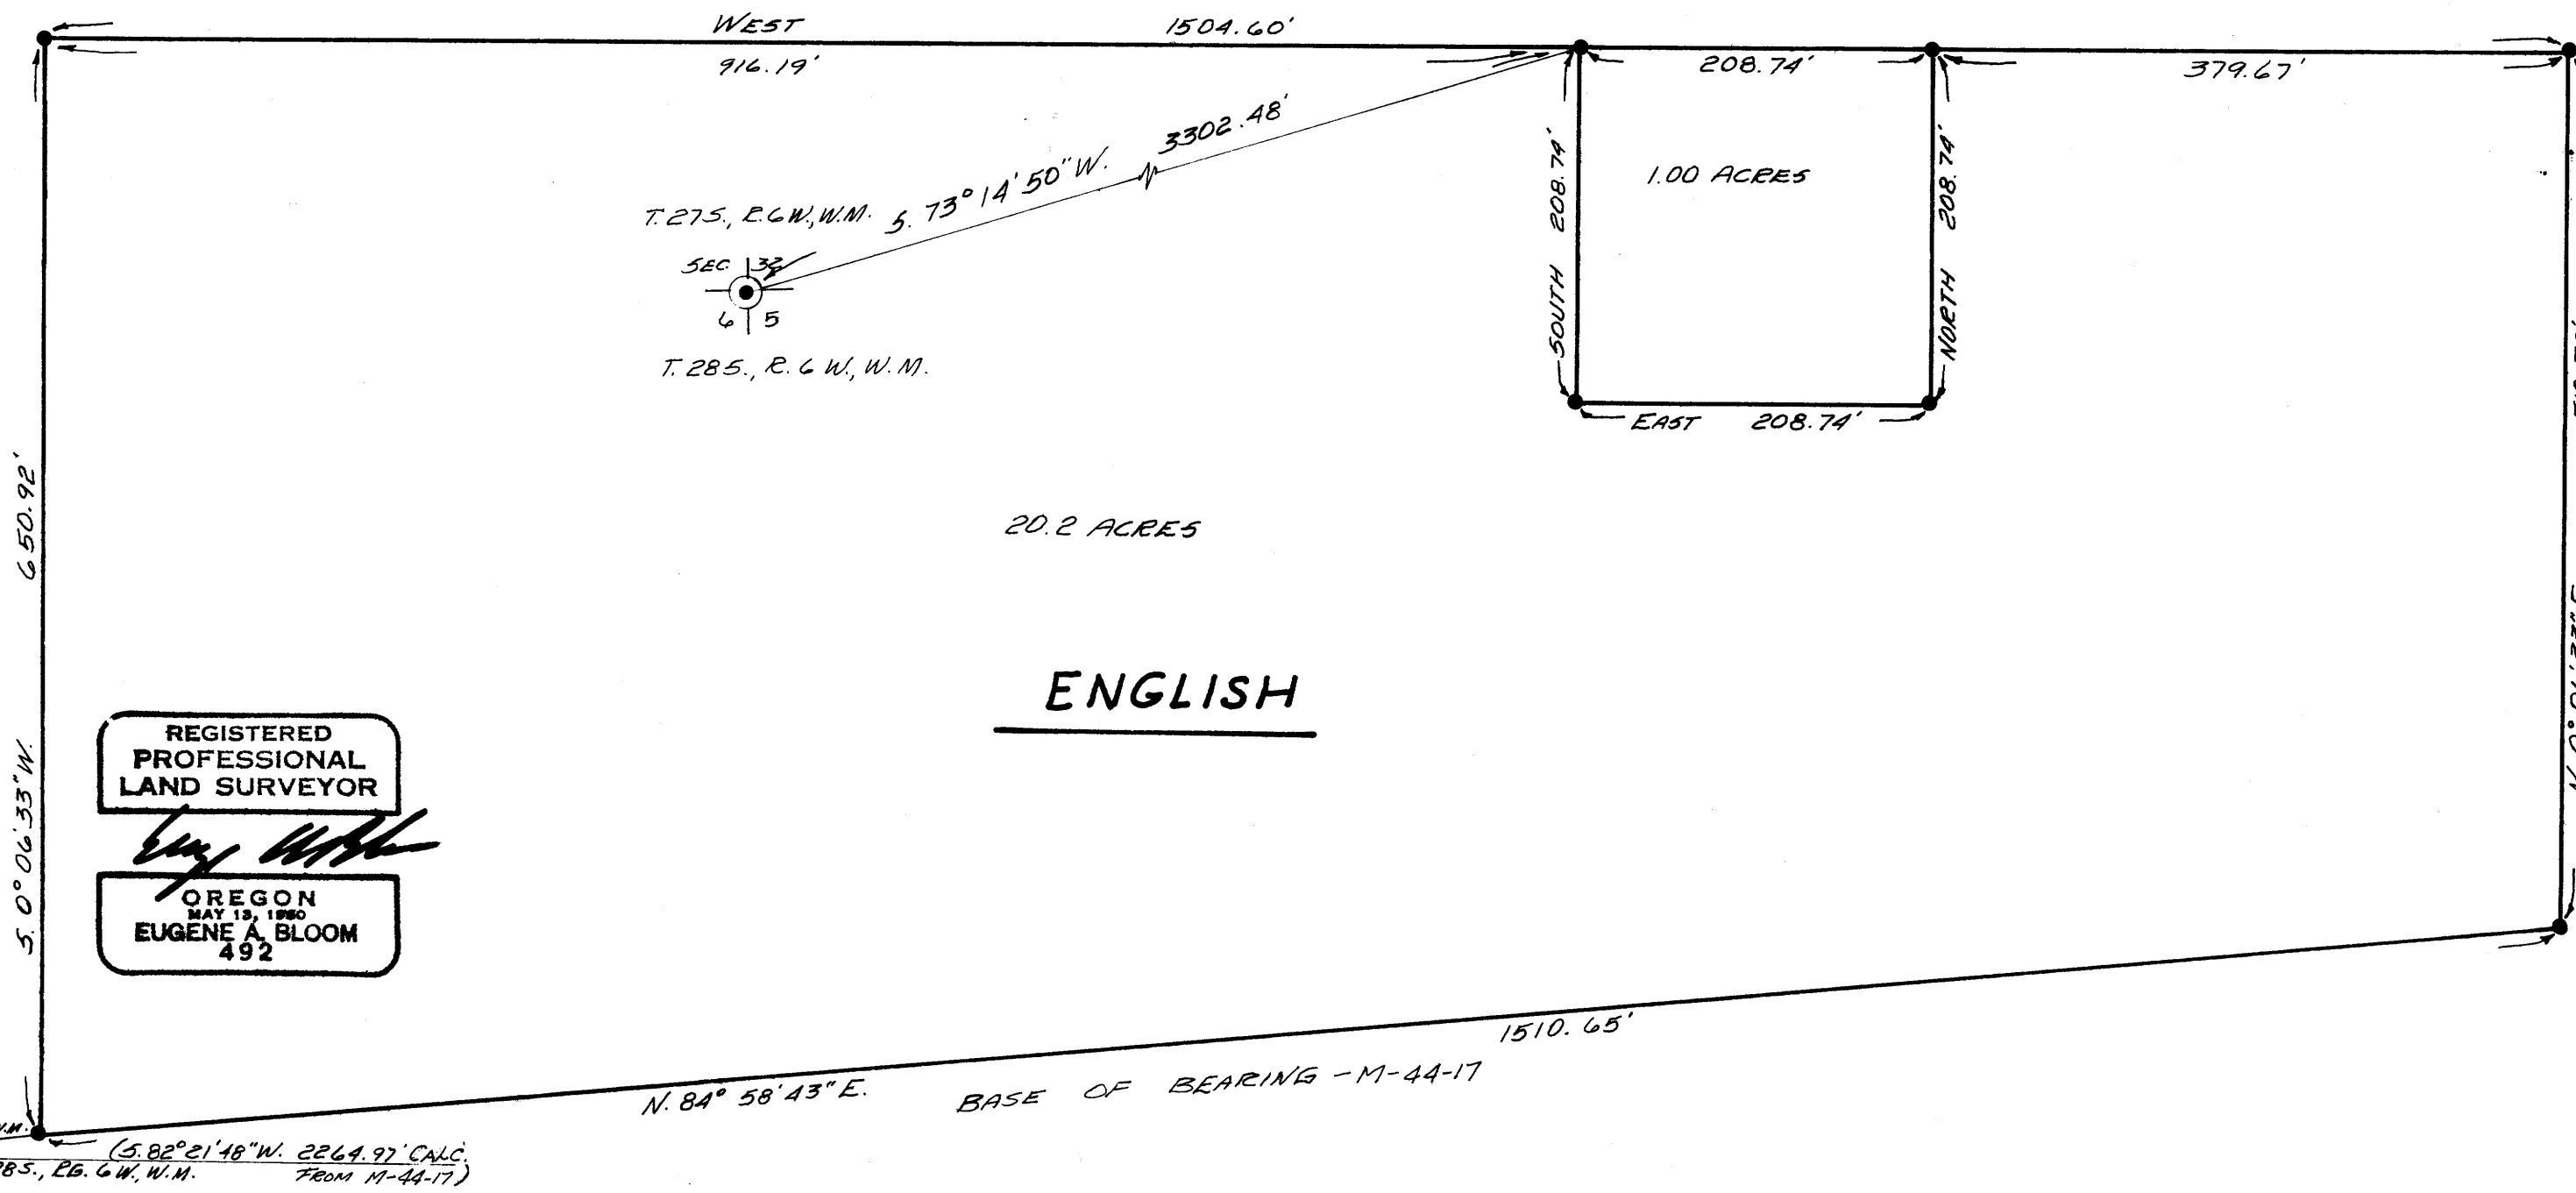

M 48-13