

COUNTY SURVEYORS FILE DATA
DO NOT REMOVE FROM OFFICE

FILED
RECEIVED *de*

APR 26 1973

COUNTY SURVEYOR
DOUGLAS COUNTY, ORE.

Fd. brass cap mkd.
County Surveyor's Office
T 30S, T 31S
S 33, S 5, S 4 1966,
along side a 3/4" iron pipe,
along side a 8" x 8" x 12" rock
with 2 notches on North face
and 3 notches on South face.
From which a:

33
5 4
13" original laurel BT
rescribed by County Surveyor
bears S 23° W, 13.7 ft.
(record 12.0 ft.)
16" original Douglas fir BT
portions of scribes vis.
bears N 11° W, 24.4 ft.
20" Douglas fir BT
scribes vis.
bears North, 31.8 ft.

Lot 1

Lot 4

N 1° 13' E, 1357.15
(Record N 0° 03' W, 1412.40)

Lot 8

Lot 5

N 1° 13' E, 1268.36
(Record N 0° 03' W, 1320.00)

Set a 2" square Douglas fir stake
from which a:

24" Douglas fir, 1 scribed
"N 1/16 S 5 BT"
bears N 15° W, 2.8 ft. to center
24" Douglas fir, 1 scribed
"N 1/16 S 4 BT"
bears N 46° E, 6.9 ft. to center

Lot 9

Lot 12

N 1° 13' E, 1268.36
(Record N 0° 03' W, 1320.00)

Fd. brass cap
set by County Surveyor
from which a:

11" x 11" x 5" stone, no marks,
lays along side (probable original corner)

16" original Douglas fir BT
good scar
bears S 15° W, 10.6 ft.
(record S 15° E)

12" original madrone BT
bark scribed
bears S 72° E, 19.8 ft.
(record S 72° W)


38" Douglas fir BT
bark scribed
bears N 68° W, 25.7 ft.

5" chinquapin BT
bears N 61° W, 12.2 ft.

6" madrone BT
bears N 6° W, 5.5 ft.

PROPERTY LINE SURVEY IN
SECTION 4, T. 31 S., R. 3 W., W. M.
For: Green Valley Lumber Co.
Myrtle Creek, Oregon

By: Shaner Engineering, Roseburg, Oregon
April 23, 1973

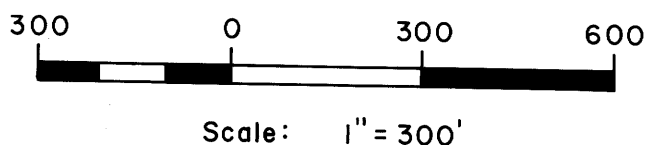

Bearings based on
Mag. Decl. 20° 30' E.

LEGEND

- Corner found
- Corner set
- Corner computed, not set
- True line, marked with blazes, red paint and red flagging
- Random line only, no true line marked

