

FILED *AD*
RECEIVED *24*
MAY 7 1973

COUNTY SURVEYOR
DOUGLAS COUNTY, ORE

SURVEY TO SET PROPERTY CORNERS

IN D.L.C. #50, T. 29S., R. 5W.W.M.



& LOT 1, SEC. 25, T. 29S., R. 5W.W.M. & SECS. 19 & 30 T. 29S., R. 4 W.W.M.

FOR BOB JENKINS
BY BRUCE ROGERS

(REVISION OF M 47-70)
U.R.

FEB, 1973

1" = 200'

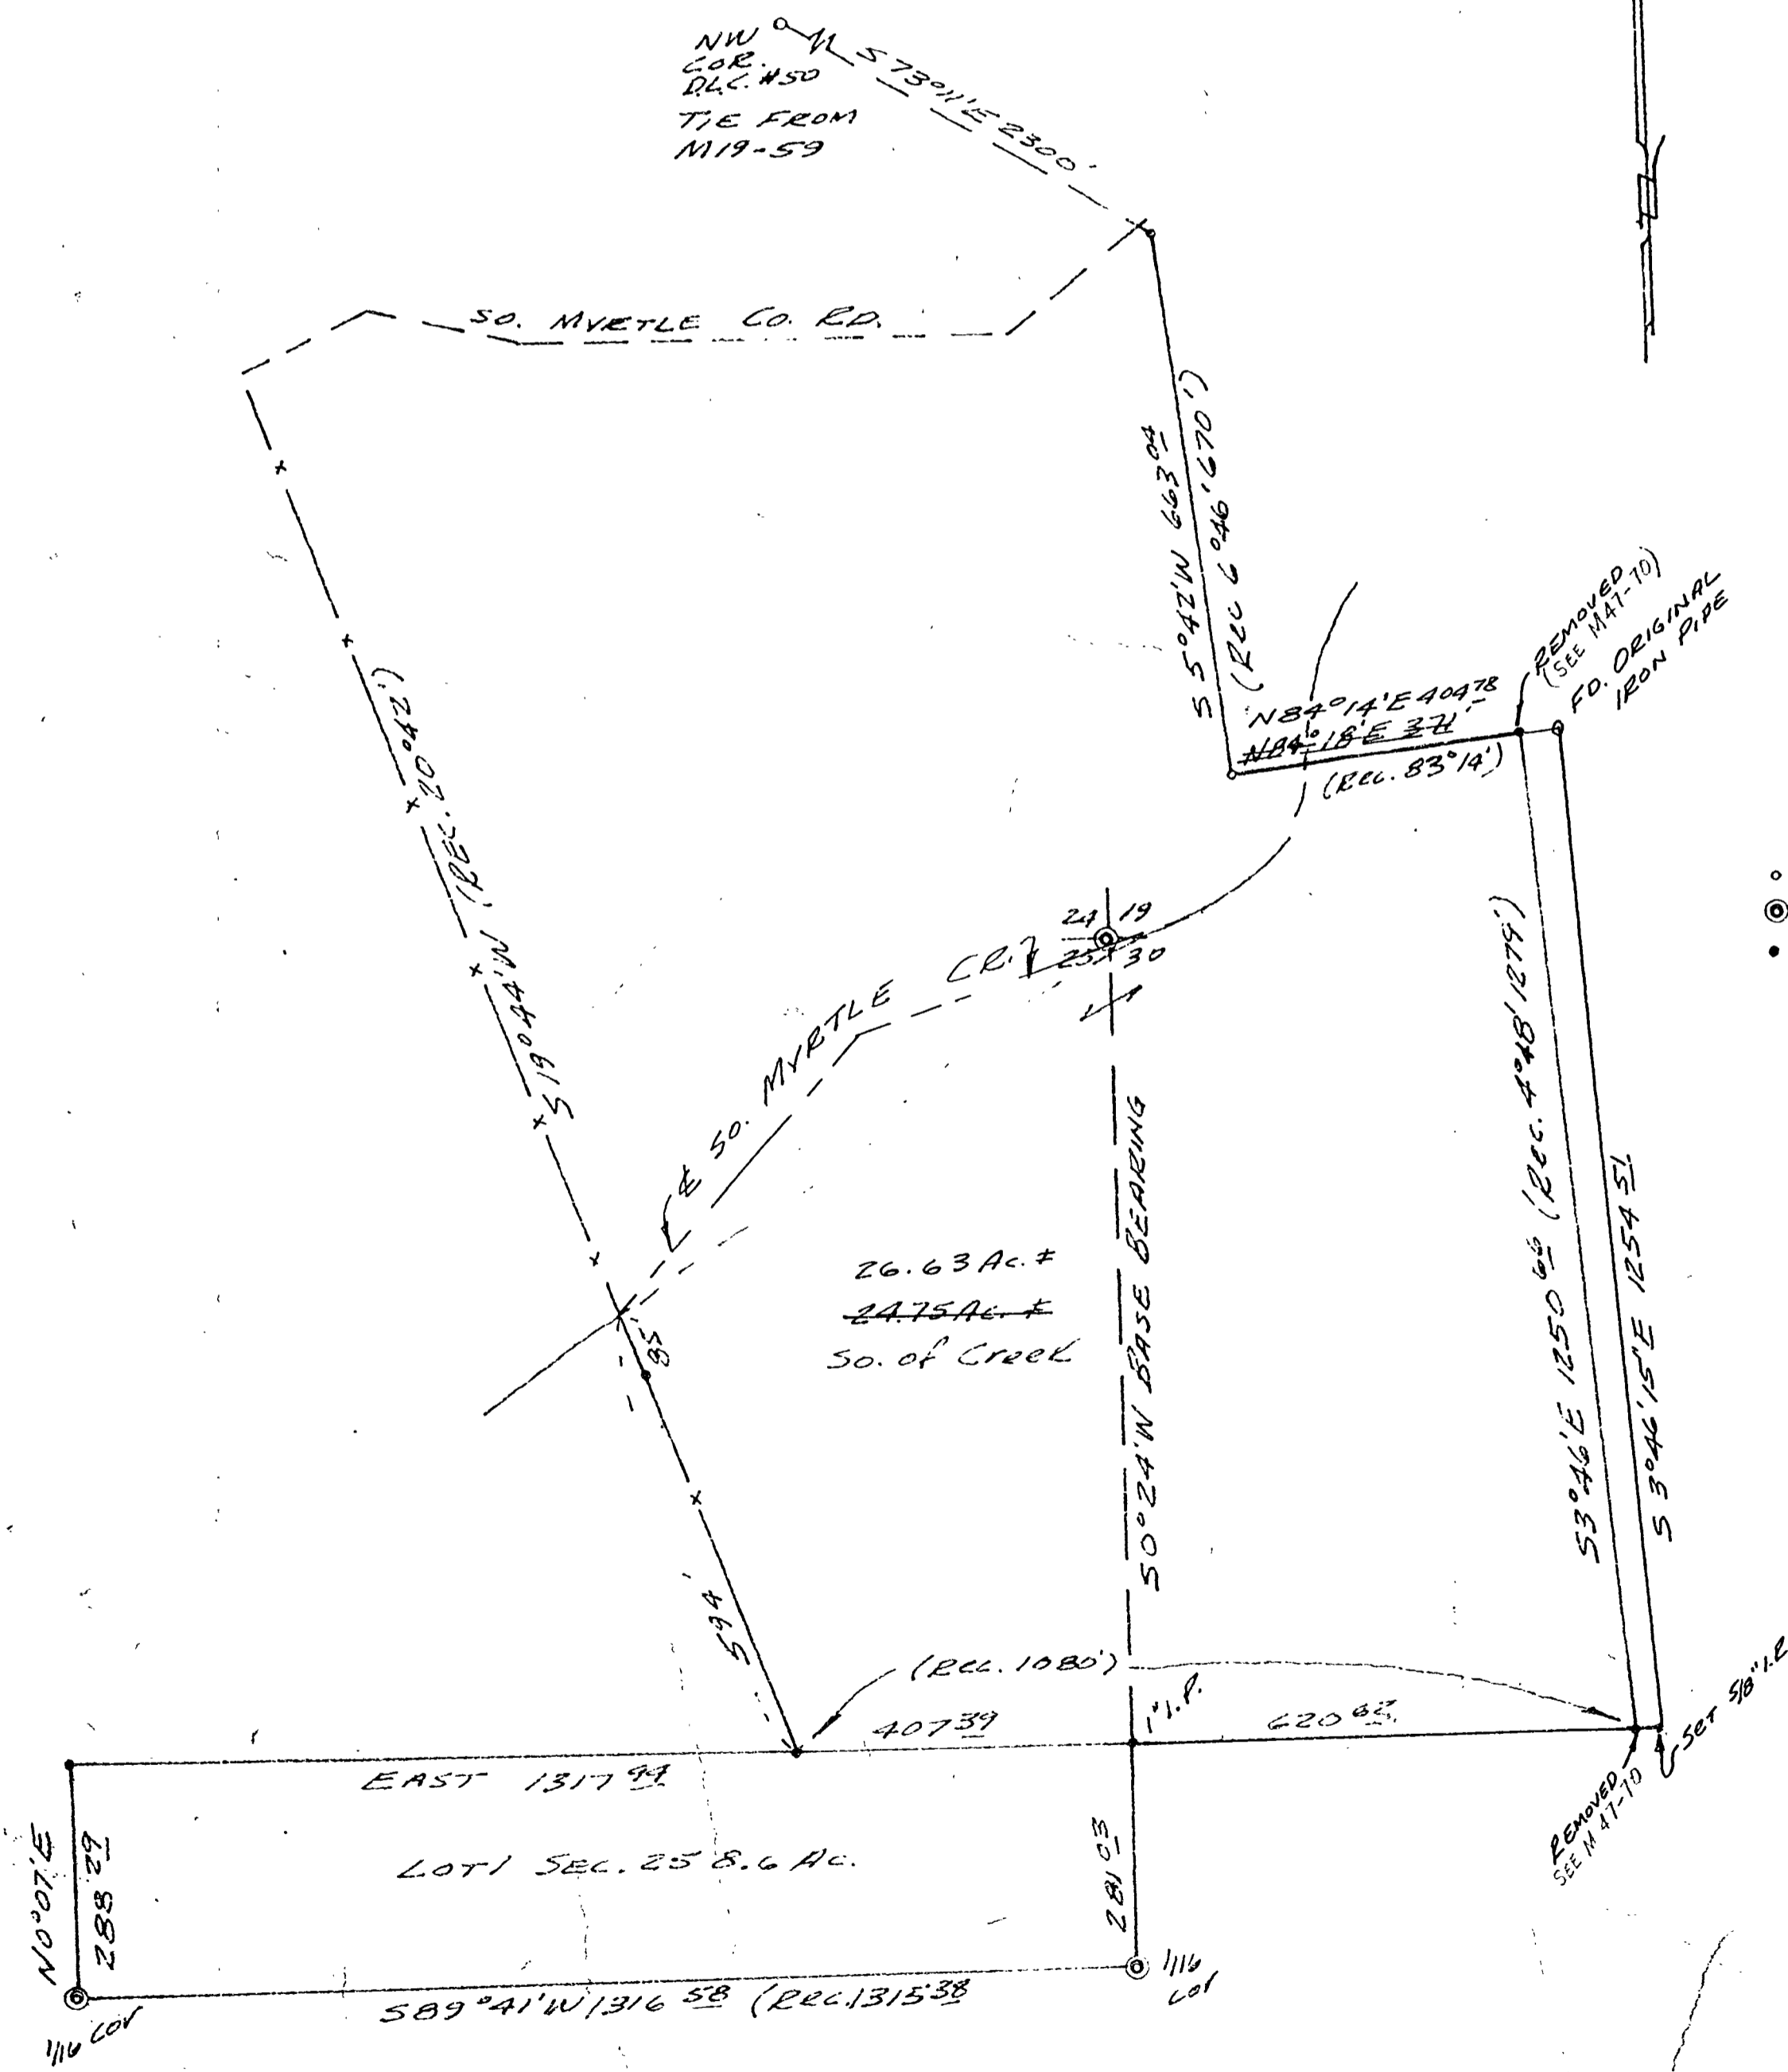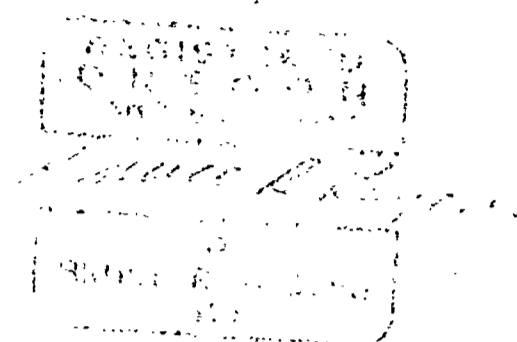

- o - Fd. I.P.
- ⊙ - Fd. GOVT. BRASS CAP
- - Set 5/8" Iron rod or 1" I. PIPE