

COUNTY SURVEYORS FILE DATA
DO NOT REMOVE FROM OFFICE


FILED
RECEIVED

JUN 6 1973

COUNTY SURVEYOR
DOUGLAS COUNTY, ORE.

SURVEY FOR DEED DESCRIPTION
IN SECTION 22, T. 29 S., R. 5 W. W. M.
FOR FLORENCE JOHNSON
BY BRUCE ROGERS
JUNE, 1973
1" = 100'

REGISTERED
OREGON
LAND SURVEYOR
Bruce R. Rogers
JULY 10, 1962
BRUCE R. ROGERS
660

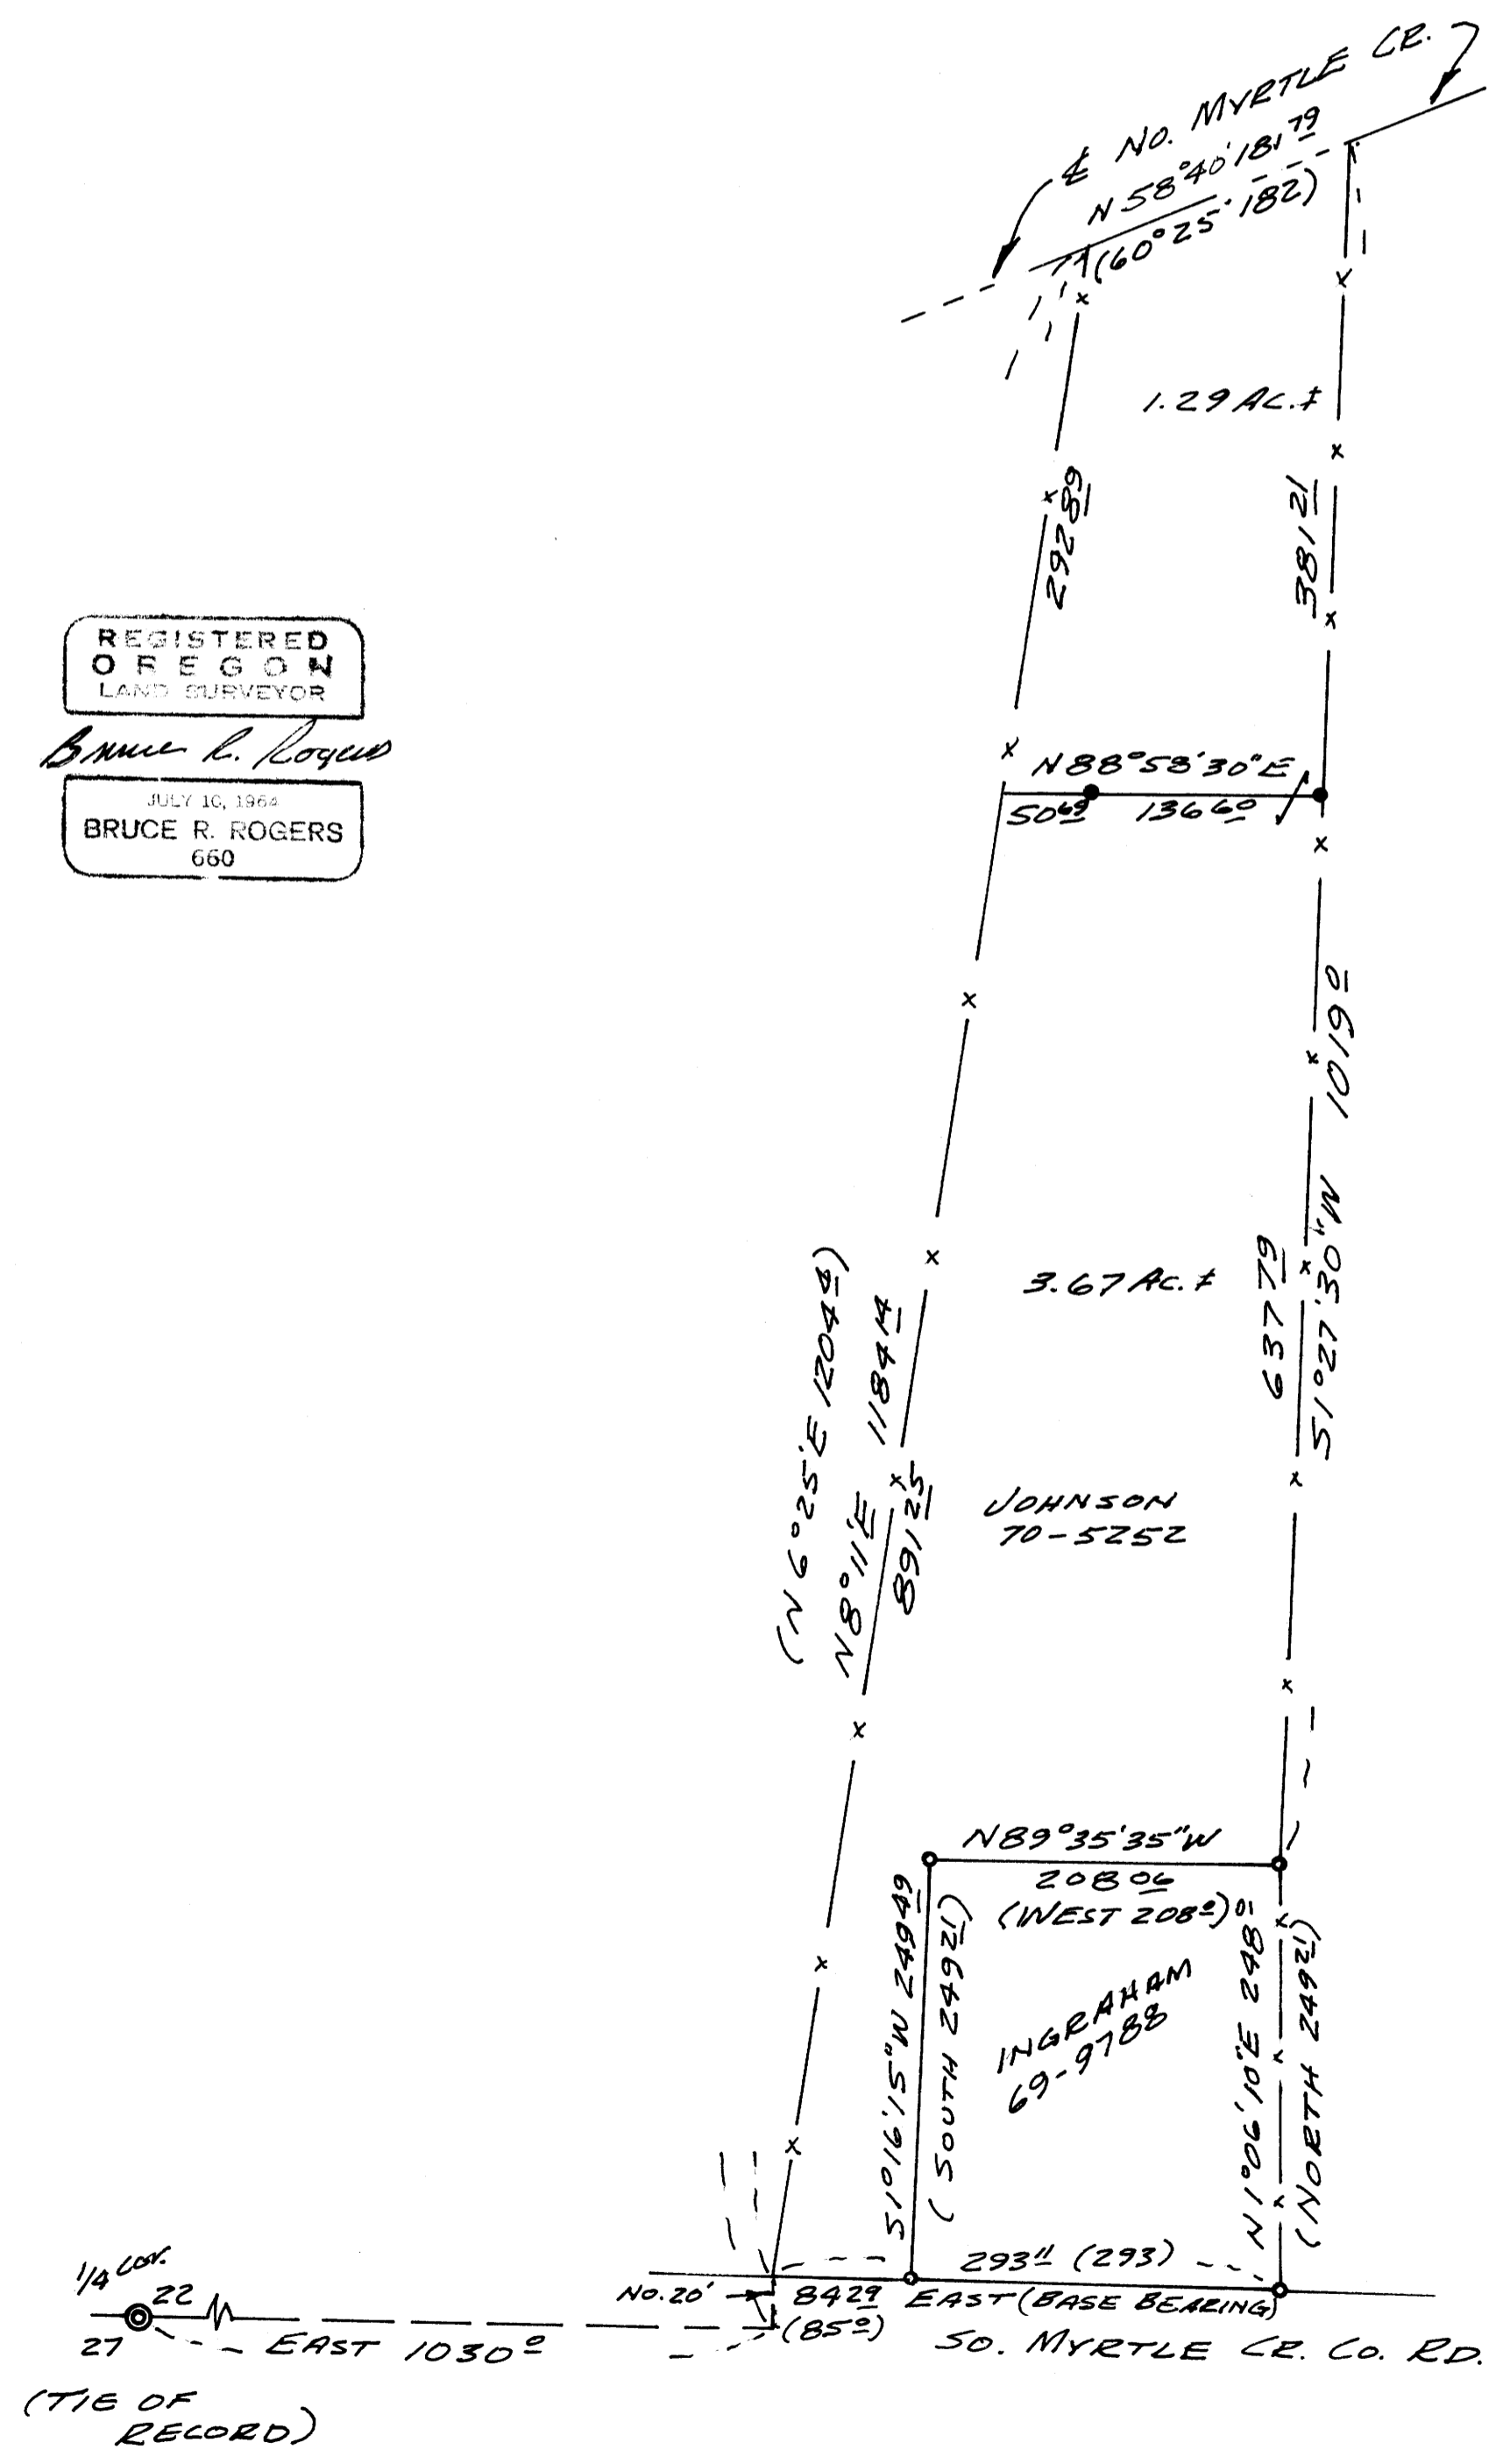

- - FOUND 5/8" IRON ROD
- - SET 5/8" IRON ROD