


COUNTY SURVEYORS FILE DATA
DO NOT REMOVE FROM OFFICE

SURVEY TO SET PROPERTY CORNERS
LOT 2, BLK. 7 DEER CRK. MEADOWS
SEC. 20, T. 27 S., R. 5 W., W. M.
FOR RICHARD RAAF
BY BAUGHMAN SURVEYING SERVICE
FEBRUARY 1973 SCALE 1" = 20'

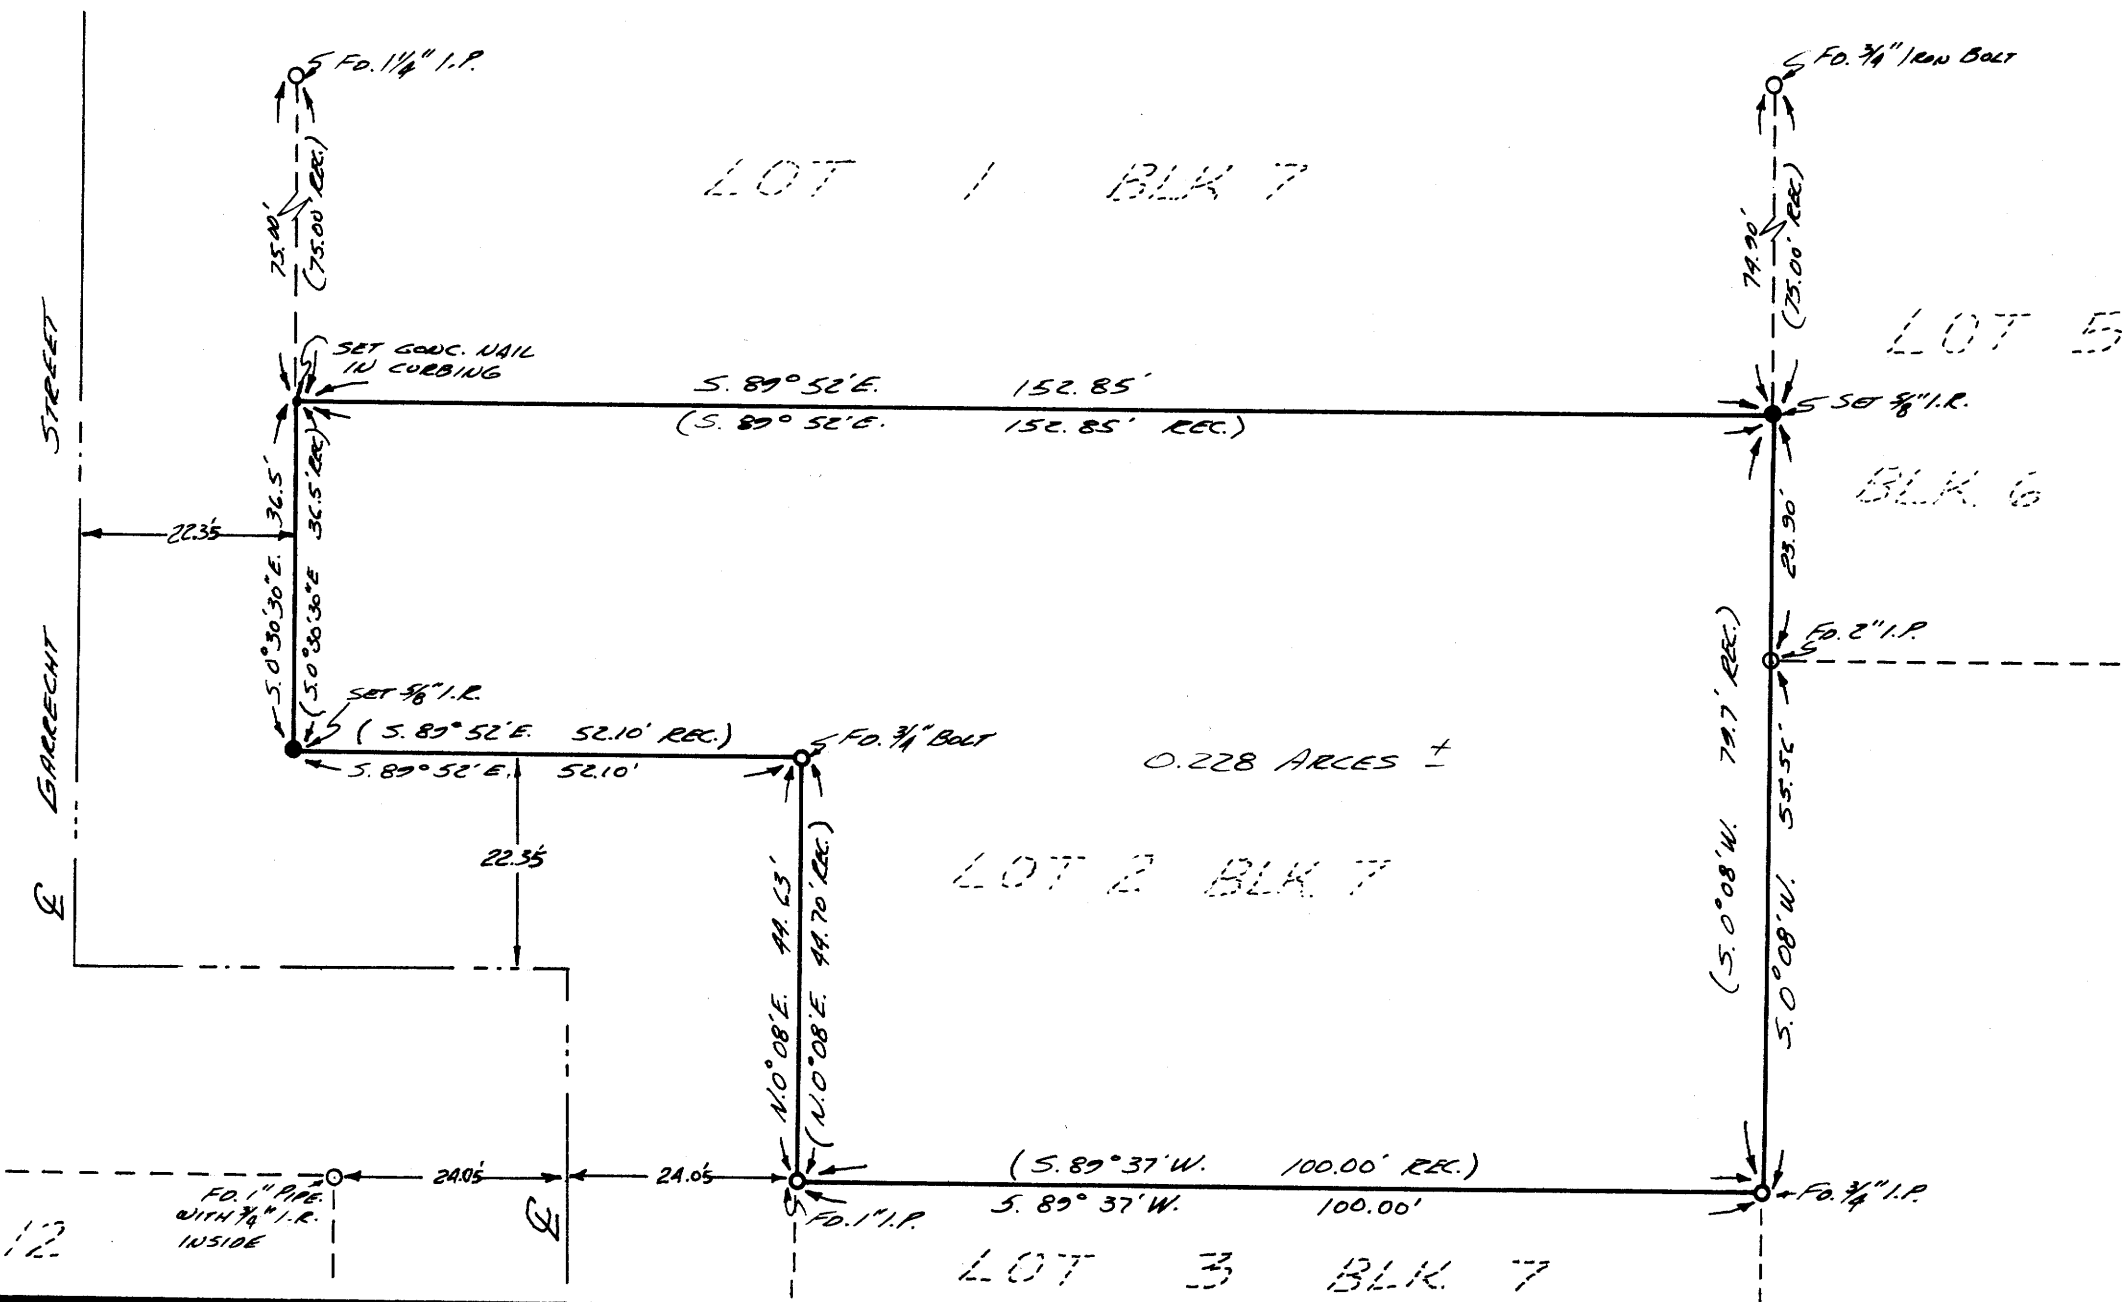

[Signature]
COUNTY SURVEYOR
DOUGLAS COUNTY, ORE.

REGISTERED
PROFESSIONAL
LAND SURVEYOR

[Signature]
OREGON
MAY 13, 1960
EUGENE A. BLOOM
492

BASED ON DEER CREEK MEADOWS Vol. 7, P. 21

M48-7

MAP FILE - M 48 - 7