

SURVEY FOR DESCRIPTION

A PORTION OF LOT 1 GREEN VALLEY ORCH. TRACTS
IN SEC. 2, T. 28 S., R. 6 W., W.M.

FOR BLACK & TIPTON REALTY INC.


BY BAUGHMAN SURVEYING SERVICE

FEBRUARY 1973 COUNTY SURVEYORS FILE DATA SCALE 1" = 40'

DO NOT REMOVE FROM OFFICE

[Signature]
COUNTY SURVEYOR
DOUGLAS COUNTY, ORE.

LOT 1

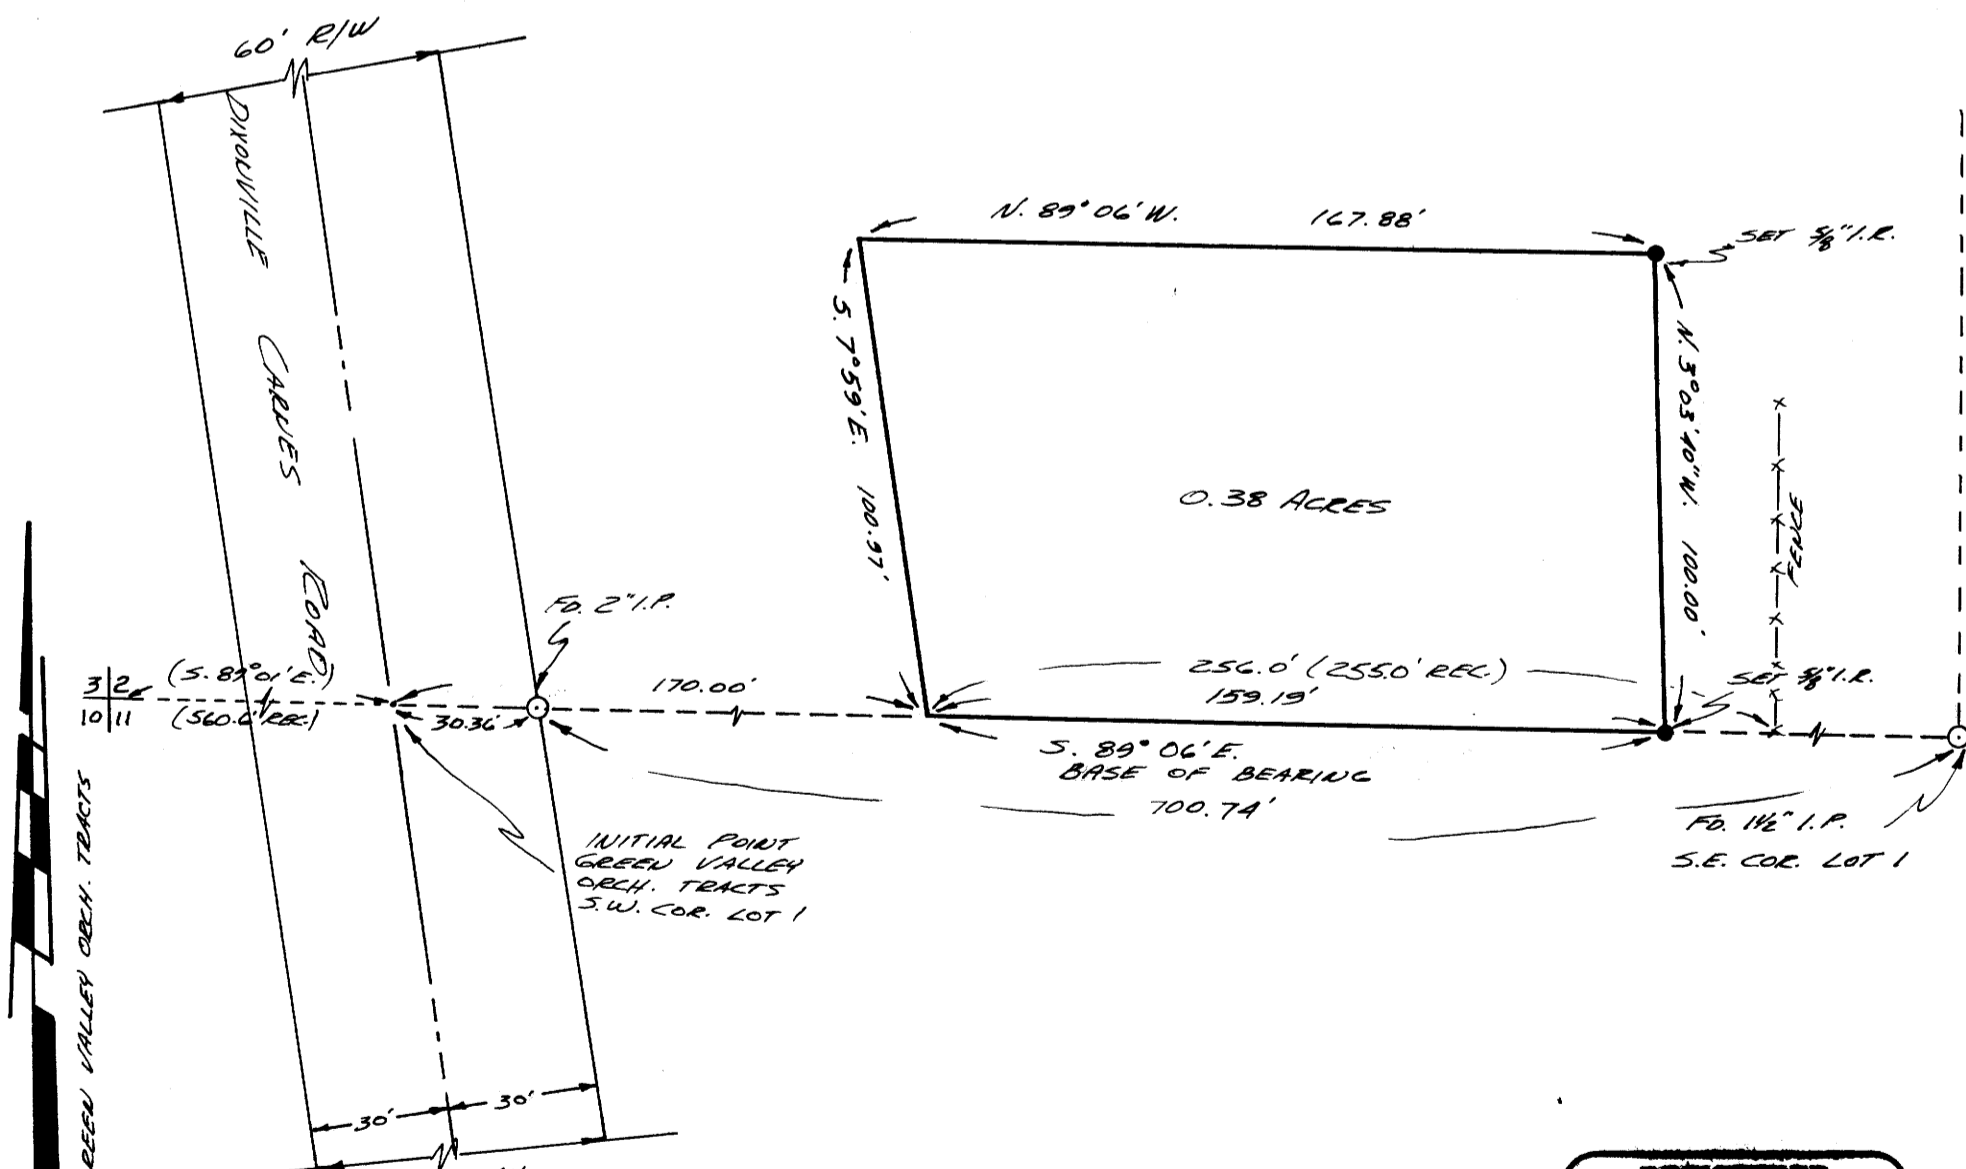

BASED ON GREEN VALLEY ORCH. TRACTS
VOL. 4 P. 69

REGISTERED
PROFESSIONAL
LAND SURVEYOR
[Signature]
OREGON
EUGENE & BLOOM
492