

Fd. brass cap mkd.  
County Surveyor's Office  
T 22 S, R 5 W  
S 3, S 2, S 10, S 11, 1958

Fd. original 60" cedar BT  
Stump, scribing vis.  
Bears N 78° E, 17.2 ft. (to face)

Fd. original 40" Douglas fir BT  
Stump, burned and rotted  
No face or scribing vis.  
Bears S 8° W, 68.0 ft.

Fd. 20" Douglas fir BT  
Face vis.  
Bears N 34° E, 39.5 ft.

Fd. 16" Douglas fir BT  
Face vis.  
Bears N 13° W, 21.2 ft.

Fd. 18" Douglas fir BT  
Face vis.  
Bears S 8° W, 53.4 ft.  
(Record S 4.2 ft.)

Fd. 18" Douglas fir BT  
Face vis.  
Bears S 60 1/2° E, 120.8 ft.  
(Record S 6 1/2° E)

Fd. 1" iron pipe and a 4" x 4" post  
Set brass cap mkd.  
T 22 S, R 5 W, WM  
S 10, S 11 1/4 S 1972  
Placed iron pipe beside brass cap

Fd. 40" original Douglas fir BT  
Face vis.  
Bears N 55 1/2° E, 20.7 ft.  
(Record N 50° E, 22.4 ft.)

Fd. 36" original Douglas fir BT  
Face vis.  
Bears S 64 1/4° W, 20.3 ft.  
(Record S 65° W, 21.1 ft.)

Fd. 1 1/4" iron pipe 16" above ground  
and a 3" x 3" scribed post with  
scribing vis.  
Set brass cap mkd.  
T 22 S, R 5 W, WM  
S 10, S 11, S 15, S 14 1972  
Placed iron pipe beside brass cap

Fd. 36" Douglas fir BT  
Partly open, no scribing vis.  
Bears N 10° W, 2.5 ft.

Fd. 30" Douglas fir BT  
Scribing vis.  
Bears N 25° E, 26.0 ft. (record 25.0 ft.)

Fd. 28" Douglas fir BT  
Face vis.  
Bears S 29° W, 42.8 ft.  
(Record S 26° W, 41.9 ft.)

Fd. 36" Douglas fir BT stump  
Partly unrotted, face vis.  
Bears S 23 1/2° E, 50.7 ft.  
(Record S 31° E, 47.5 ft.)

Fd. 3/4" iron pipe 16" above ground  
Set brass cap mkd.  
T 22 S, R 5 W, WM  
S 15, S 14 1/4 S 1972

Fd. 40" original Douglas fir BT  
Stump, face and scribing vis.  
Bears N 15° W, 33.0 ft.

Fd. 32" Douglas fir BT  
Face vis.  
Bears N 86° E, 47.8 ft.

Fd. 22" Douglas fir BT  
Face vis.  
Bears S 86 1/2° E, 45.1 ft.

Fd. a 5" x 5" post scribed "1/4 S" on  
West face. I also found a mound of stone  
approximately 1 ft. SE of the post. I  
found no markings on the stones nor any  
original BTs. Same as described by McGillicuddy.  
Set brass cap mkd.  
T 22 S, R 5 W, WM  
1/4 S S 2, S 11 1972

I scribed a 15" Douglas fir  
"1/4 S 2 BT"  
Bears N 56° E, 15.5 ft.

I scribed a 48" Douglas fir  
"1/4 S 11, BT"  
Bears S 67 1/4° W, 8.3 ft.

Fd. brass cap mkd.  
County Surveyor's Office  
T 22 S, R 5 W  
S 1, S 2, S 11, S 12 1958

Fd. original 10" white fir BT  
Now 30", original and rescribes vis.  
Bears S 43° E, 28.4 ft.

Fd. original 40" Douglas fir BT  
Now 50" snag, face vis.  
Bears N 19° W, 29.7 ft.

Fd. 15" hemlock BT, scribes vis.  
Bears N 32° W, 1.5 ft.

Fd. 17" hemlock BT (record white fir)  
Bears S 78° W (record S 87° W), 24.8 ft.

Fd. 24" Douglas fir BT  
Bears N 72° E, 36.0 ft.

\* From the brass cap I found a mound  
of stones set by McGillicuddy in  
1952 for the section corner, bearing  
N 44° E, 68.4 ft. The scribes have  
been chopped off of McGillicuddy's  
bearing trees.

Set brass cap mkd.  
T 22 S, R 5 W, WM  
S 11, S 12 1/4 S 1972

Fd. original 40" Douglas fir BT  
Face vis.  
Bears N 41° W, 132.0 ft.

I scribed an 8" Douglas fir  
"1/4 S 12 BT"  
Bears N 19° E, 12.9 ft.

I scribed a 10" madrone  
"1/4 S 11 BT"  
Bears N 77° W, 20.5 ft.

Note: North-South fence line runs 1 ft.  
East of the brass cap. East-West fence  
line, now partially destroyed, approximately  
30 ft. North of the corner.  
This corner is the same as recorded  
by McGillicuddy in his 1952 survey as  
per both BT's and fence lines.

Fd. brass cap mkd.  
County Surveyor's Office  
T 22 S, R 5 W  
S 11, S 12, S 14, S 13 1958

Fd. 42" white fir BT  
Face vis.  
Bears S 78° W, 7.5 ft.

Fd. 20" cedar BT  
Scribes vis.  
Bears North, 53.0 ft.


Fd. 30" cedar BT  
Scribes vis.  
Bears N 49° E, 94.5 ft.

Fd. 15" Douglas fir BT  
Face vis.  
Bears S 69° E, 168.0 ft.

Fd. 30" cedar BT, rotted stump  
Bears N 9° W, 41.8 ft. (record 40.3 ft.)

Fd. 24" original cedar BT, windfall  
Bears N 46° E, 40.9 ft.


Fd. 8" original cedar BT  
Stump in creek  
Bears S 32° W, 37.6 ft.

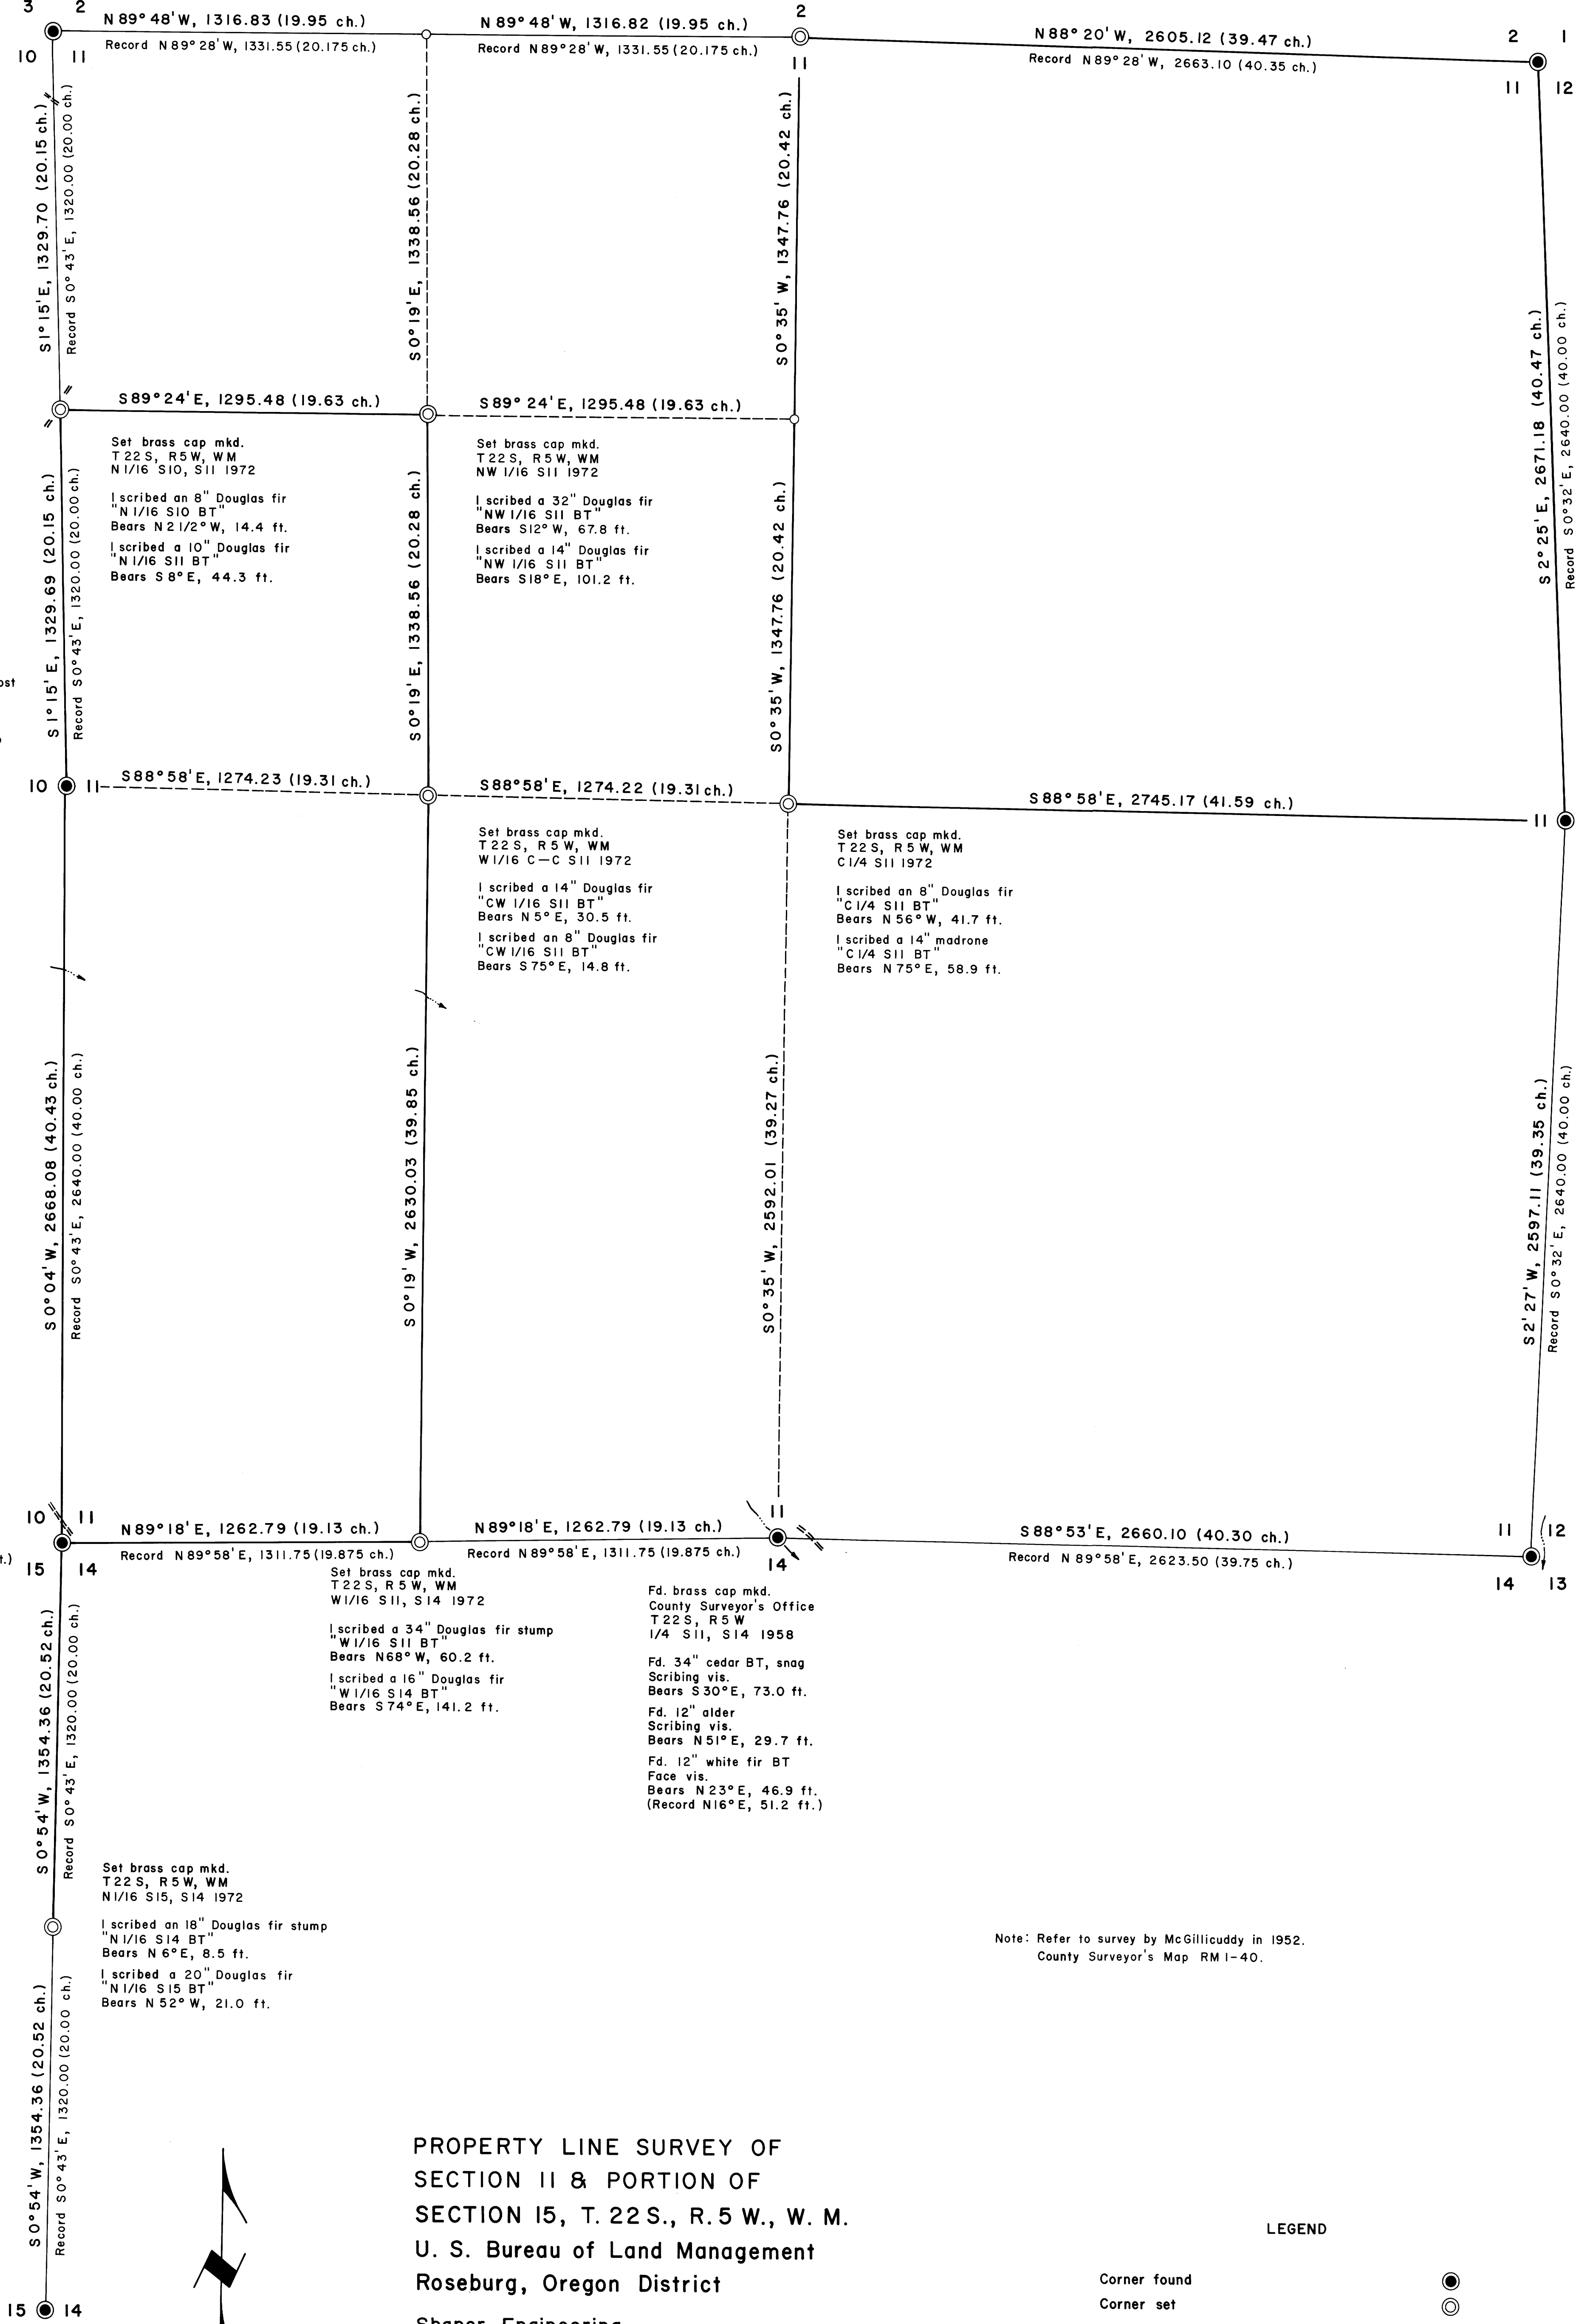

Note: Refer to survey by McGillicuddy in 1952.  
County Surveyor's Map RM 1-40.


PROPERTY LINE SURVEY OF  
SECTION II & PORTION OF  
SECTION 15, T. 22 S., R. 5 W., W. M.  
U. S. Bureau of Land Management  
Roseburg, Oregon District

Shaner Engineering  
Scale: 1" = 300' September 18, 1972  
Contract No. 53500-CT2-293 (N)

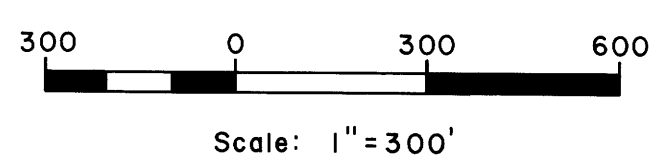

LEGEND

- Corner found
- Corner set
- Corner computed, not set
- True line marked with aluminum tags
- Dirt road
- Stream

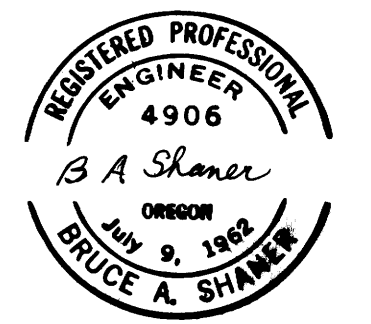

Bearings based on  
Solar observation.