

SURVEY AND TOPOGRAPHY MAP


IN LOTS 175 & 176 OF TRACT 1, PLAT 2,
ROSEBURG ORCHARD COMPANY
IN SEC. 36, T. 26 S., R. 6 W., W.M.
FOR HUNT'S CHAIN SAW
BY BAUGHMAN SURVEYING SERVICE

MARCH 1973

SCALE 1" = 40'

REGISTERED
PROFESSIONAL
LAND SURVEYOR

Glenn S. Baughman
OREGON
JULY 12, 1961
GLENN S. BAUGHMAN
536

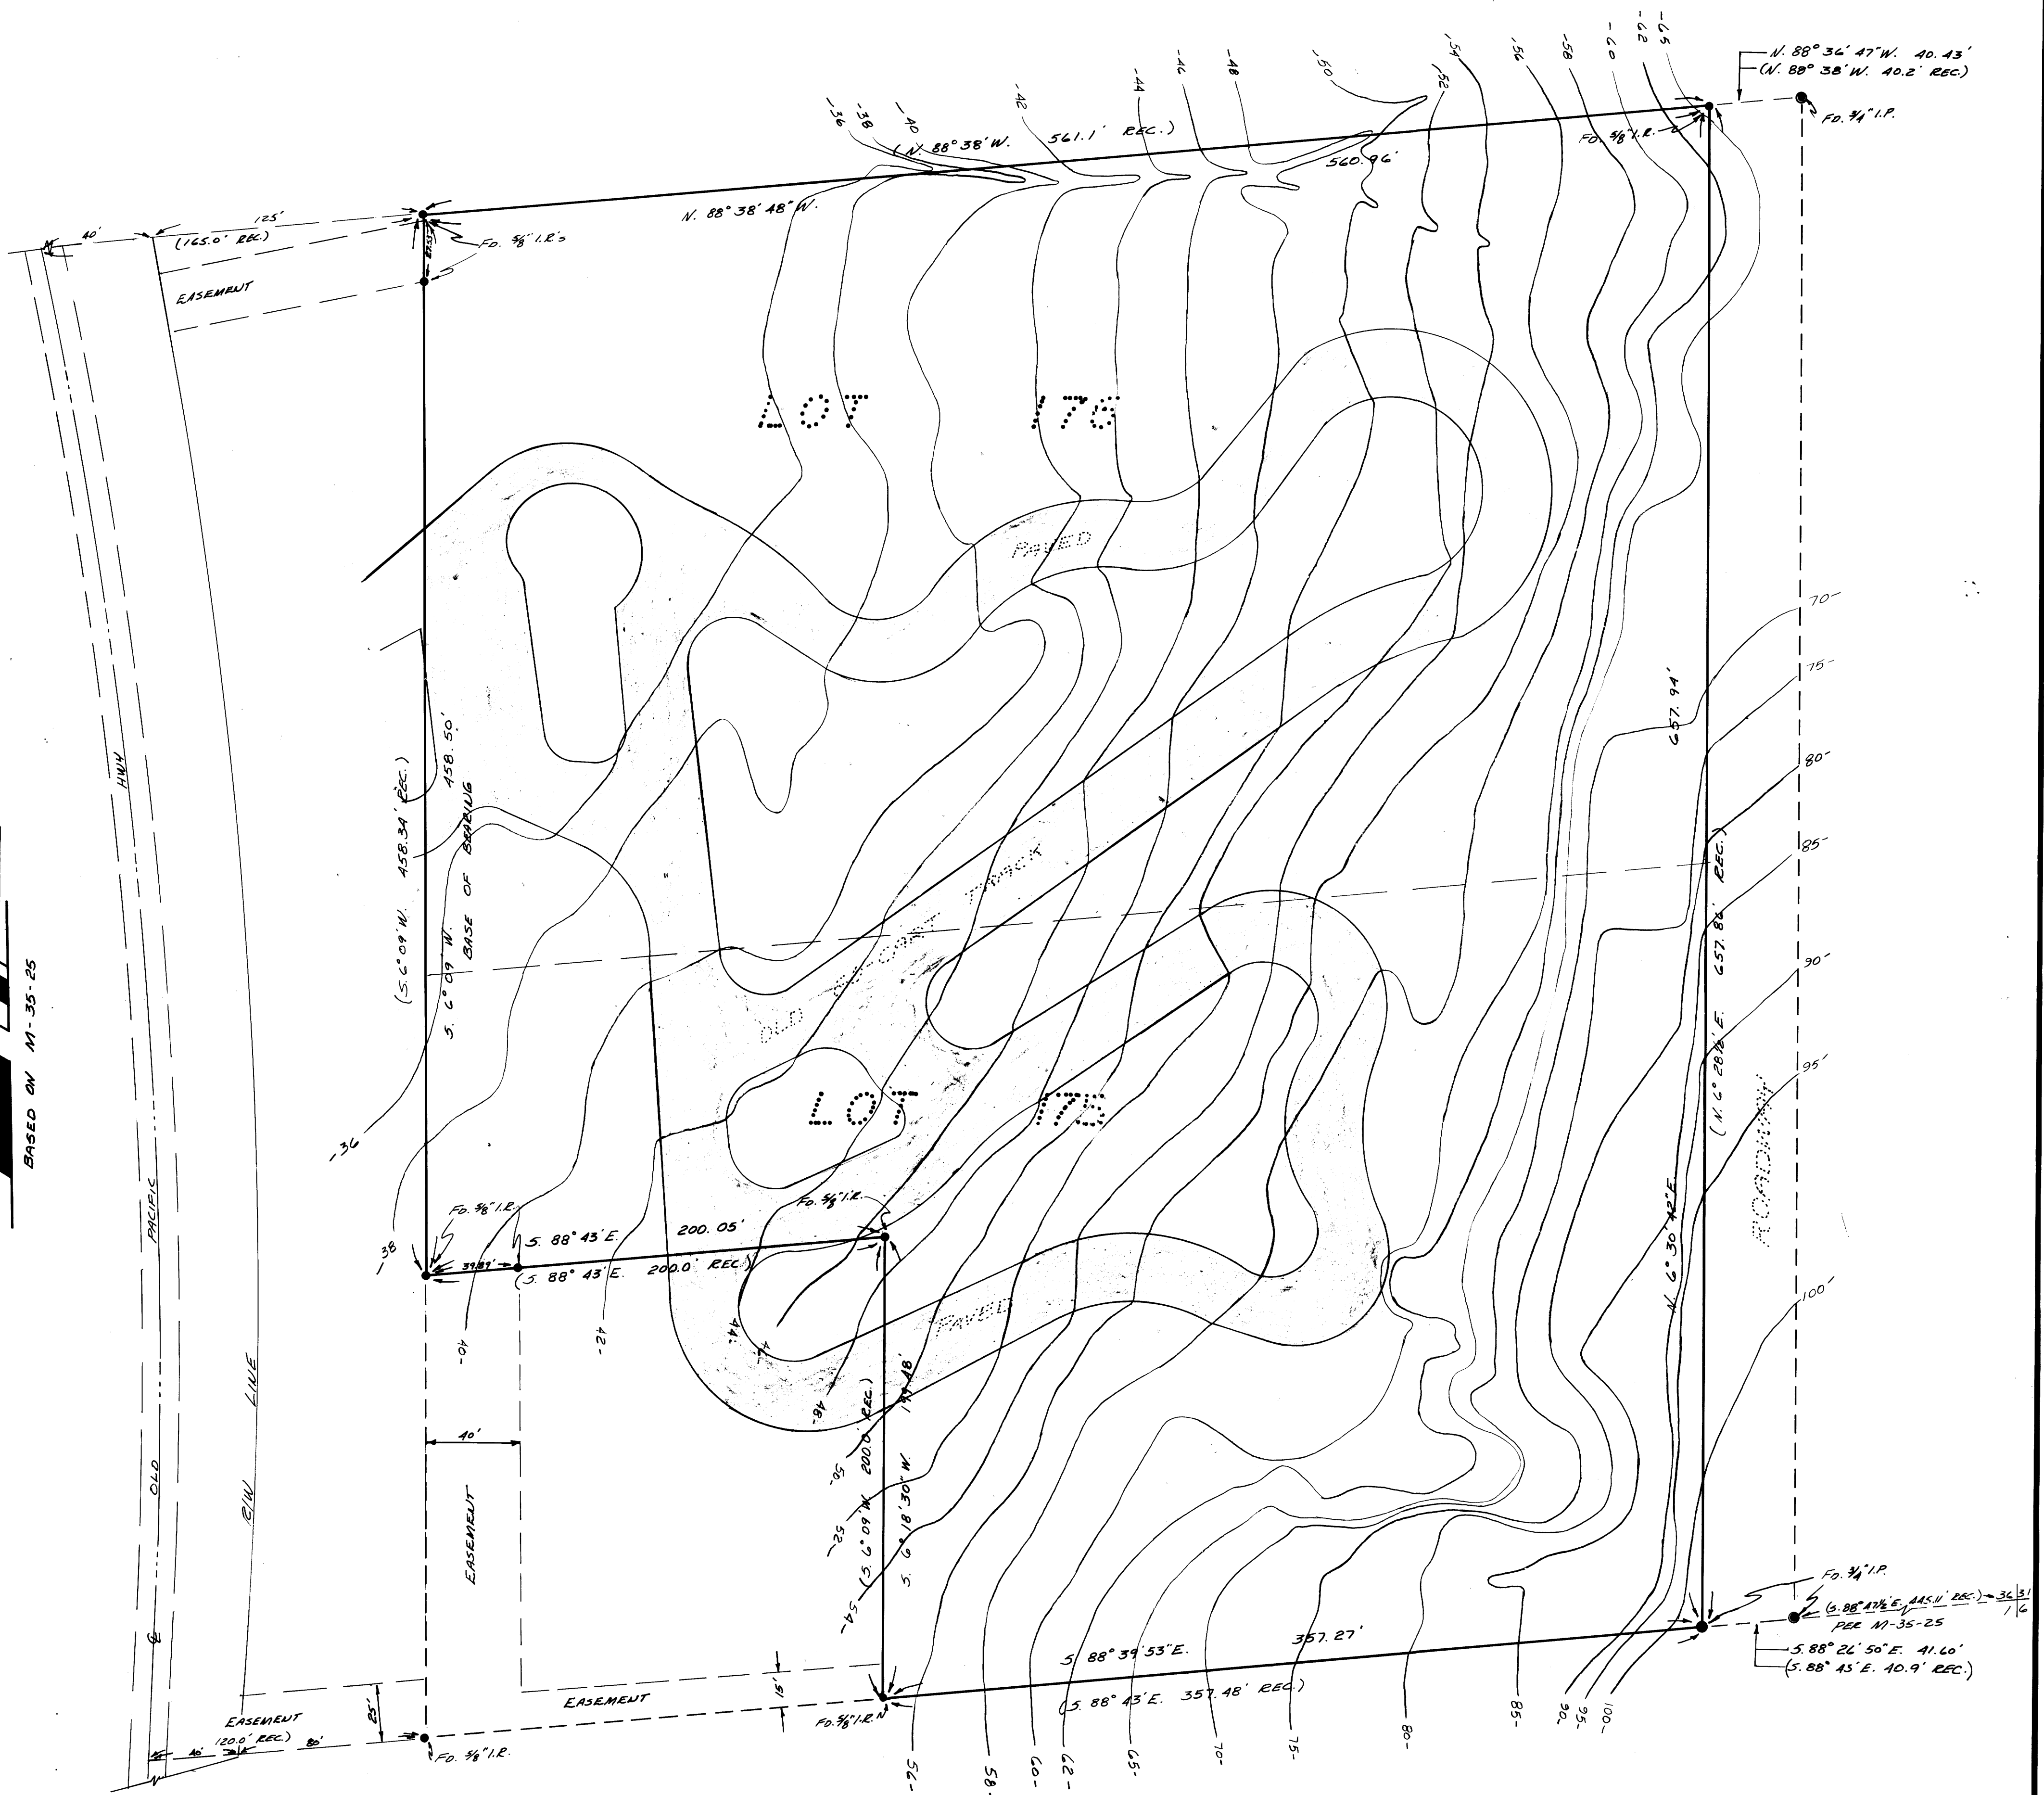

BASED ON M-35-25

NOTE:
RECORD BEARING & DIST'S
FROM M-35-25