

BARTLETT

N 1/4 Section 56 5E 4

At the corner point set a
5/8" Iron Rod, extending 6" above
the ground. From which the
new BT's:

A fir, 16" in diam, bcs N 86 1/2° W
21² ft dist. scribed "N 1/4 56 BT"

A fir, 12" in diam, bcs S 11° E
33⁰ dist, scribed "N 1/4 55 BT"

Corner Description: NW 1/4

At the corner point set 5/8"
Iron Rod, extending 3" above the
ground. From which the new
BT's:

A cedar, 8" in diam, bcs S 37° E
18² ft dist. scribed "NW 1/4 55 BT"

A fir, 12" in diam, bcs S 82° W
38⁹ ft dist. scribed "NW 1/4 55 BT"

M.

C. S. File No. 55/30 LA

BART LETT

Coarse Description CU 1/16

At the corner point set $5/8"$
Iron Rod, extending 4' above the
ground. From which, the new BT's:

A fir, 12" in diam, bcs $S28^{\circ}E$
 12° ft dist. scribed "CN 1/16 SS BT"

A fir 6" in diam, bcs $S30^{\circ}W$
 $36^{\frac{1}{2}}$ ft dist. scribed "CN 1/16 SS BT."

R. Eddy T.

D. Delaney Chmn.
4-20-13

Partly Cloudy
Temp 60°

REGISTERED
PROFESSIONAL
LAND SURVEYOR

EUGENE A. BLOOM
MAY 13, 1880
492

OREGON
MAY 13, 1880
EUGENE A. BLOOM
492

REGISTERED
PROFESSIONAL
LAND SURVEYOR

C 1/4 55

SET $5/8"$ IRON ROD 5" ABOVE GROUND
FROM ~~THE~~ WHICH BEARS

A 18" BIRCH ON $S53^{\circ}E$ 47°
scribed C 1/4 55 BT

A 14" WHITE FIR $S5^{\circ}W$ 35°
scribed C 1/4 55 BT

NOTE: A TREE NORTH
OF CORNER.
ALSO CORNER IS 17' WEST
FROM NORTH E. SOUTH
FENCE LINE


205

BARTLETT

CW 1/16 55 BT
 SET 5/8 130' I.R.
 12 ABOVE GROUND IN
 Solid Rock

S 5° 19' 00" W
 S 56° 50' 02" E
 62' 09" 02"

FOR BTS SEE BACK
 OF PAGE

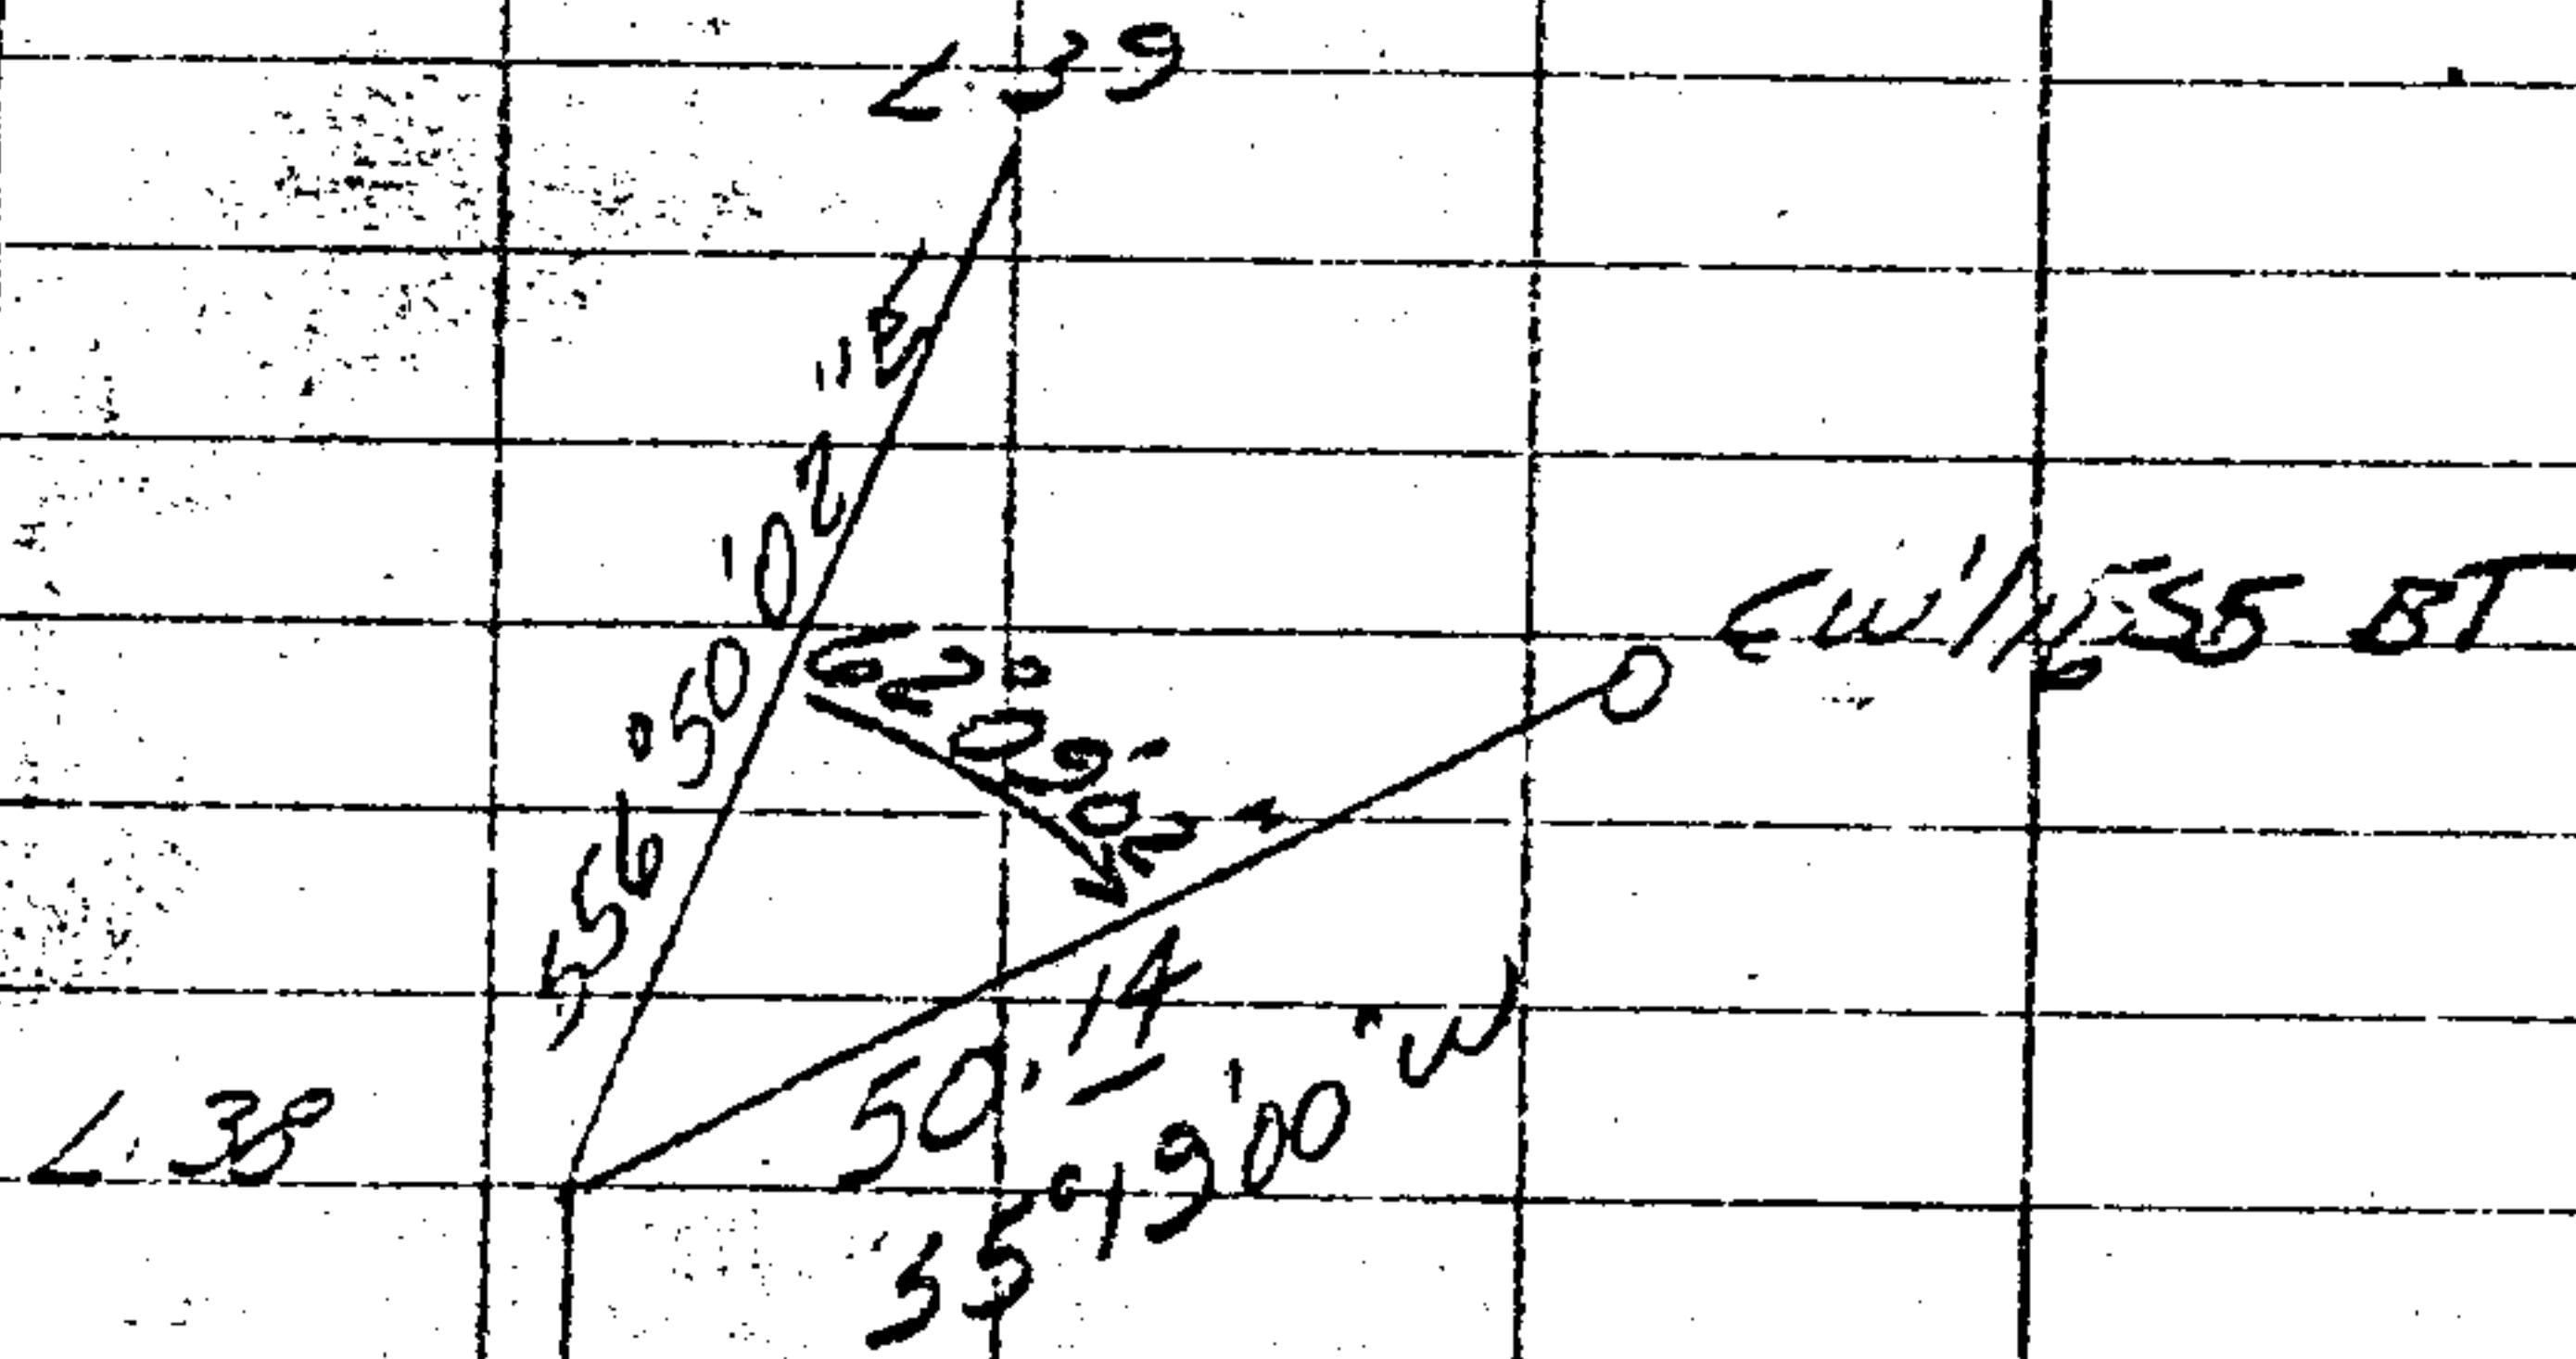

6" D. FIB. BEARS STONE 399

scribed CW 1/16 55 BT

5" MADRINK BEARS N45W 292

scribed CW 1/16 55 BT

HEEN PIESTE
 MIKE FRONDA
 4-20-73

BARTLETT SURVEY