


SURVEY FOR TOPOGRAPHY AND PROPERTY CORNERS LOCATED IN LOT 7, BLK. 2, SUNNY ACRES SEC. 24, T.27S., R. 6 W., W.M.

FOR ROSEBURG REALTY
BY BAUGHMAN SURVEYING SERVICE

AUGUST 1973

SCALE 1" = 20'

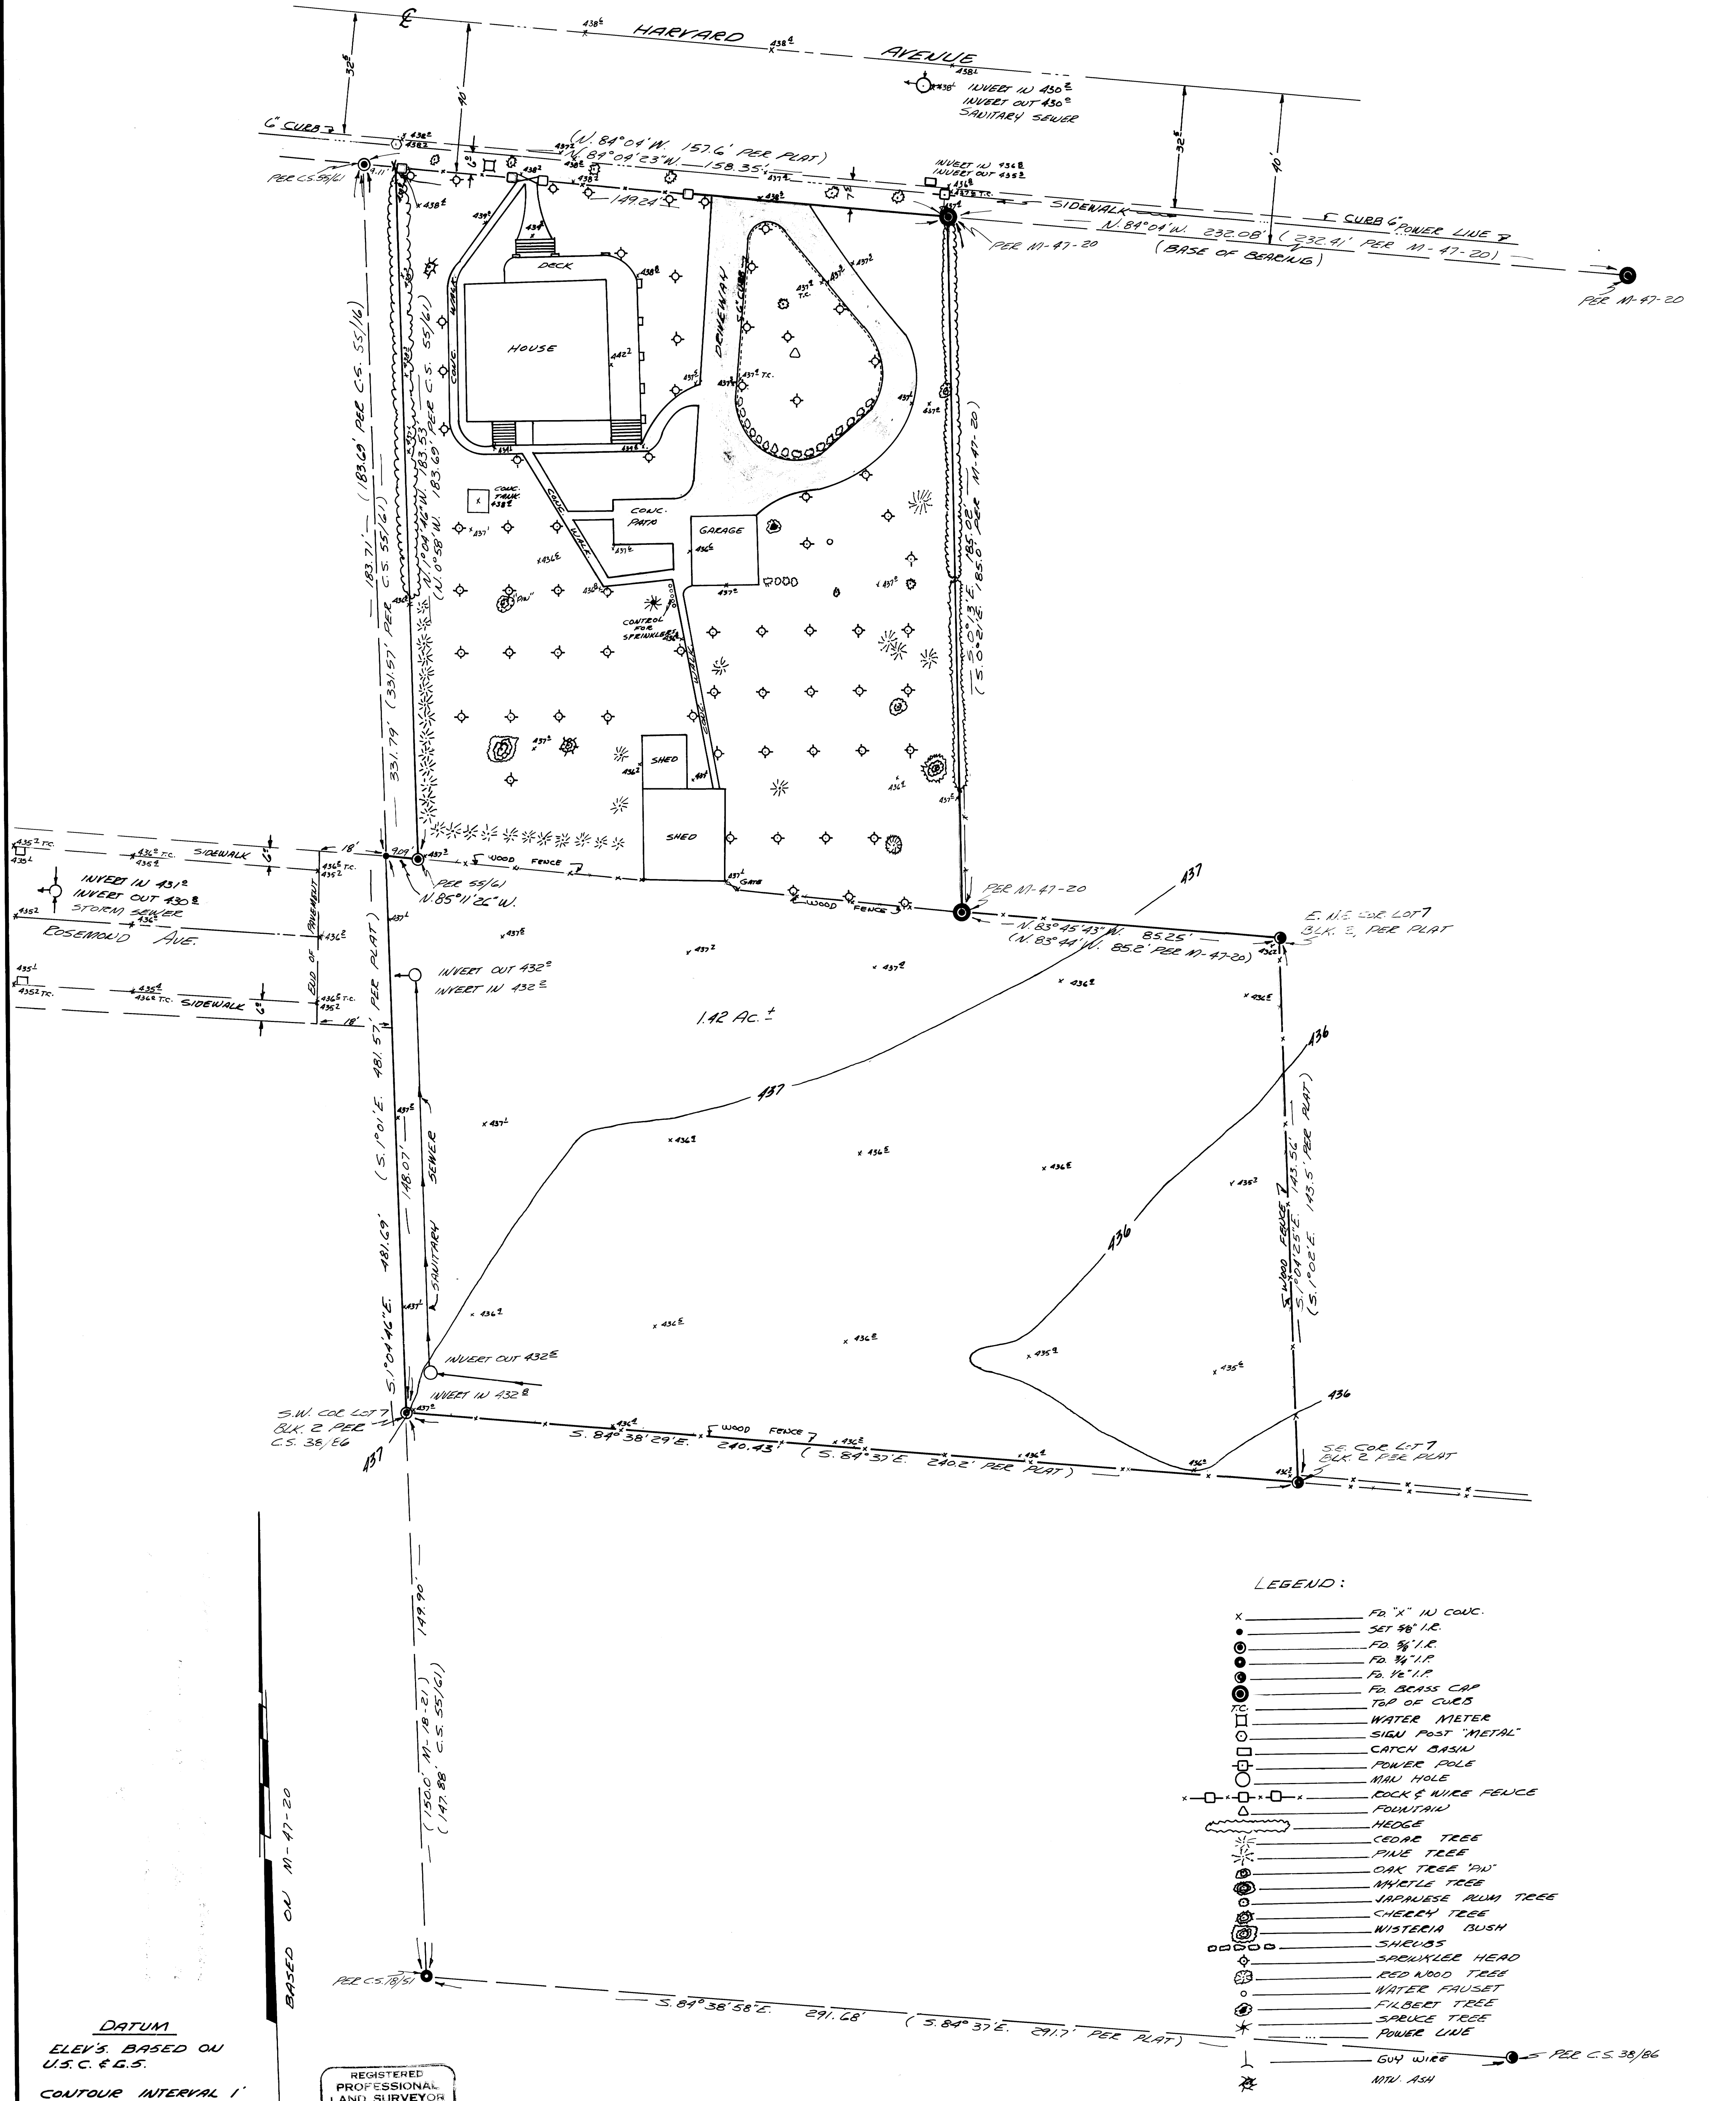

LEGEND:

- x — 1" CONC.
- SET 1/2" I.C.
- FD 3/4" I.C.
- FD 1/2" I.P.
- FD 1/4" I.P.
- FD BRASS CAP
- TOP OF CURB
- WATER METER
- SIGN POST 'METAL'
- CATCH BASIN
- POWER POLE
- MAN HOLE
- ROCK & WIRE FENCE
- FOUNTAIN
- HEDGE
- CEDEAR TREE
- PIKE TREE
- OAK TREE 'DN'
- MYRTLE TREE
- JAPANESE ALUM TREE
- CHEERY TREE
- WISTERIA BUSH
- SHEUBS
- SPRINKLER HEAD
- RED WOOD TREE
- WATER FAUCET
- FILBERT TREE
- SAPRUC TREE
- POWER LINE
- GUY WIRE
- 100% ASH

DATUM
ELEV'S. BASED ON
U.S.C. & G.S.
CONTOUR INTERVAL 1'

REGISTERED
PROFESSIONAL
LAND SURVEYOR
Baughman
OREGON
EUGENE A. BLOOM
1972

COUNTY SURVEYORS FILE DATA M 49-37