

FILED
RECORDED
SEP 21 1973
COUNTY SURVEYOR
DOUGLAS COUNTY, ORE.
m


SURVEY IN SECTION 1, T24S R6W & SECTION 6, T24S R5W WILLAMETTE MERIDIAN

Surveyed for Bill Rees by Don E. Garrett

Sept., 1973

Scale 1" = 500'

Bearings based on solar observation taken Aug. 22, 1973
● Corners set by proportionate measurement
Monuments set consist of a 1" x 1/2" x 3/8" galvanized iron pipe
flared at the bottom with a 2 1/2" brass cap riveted to the top

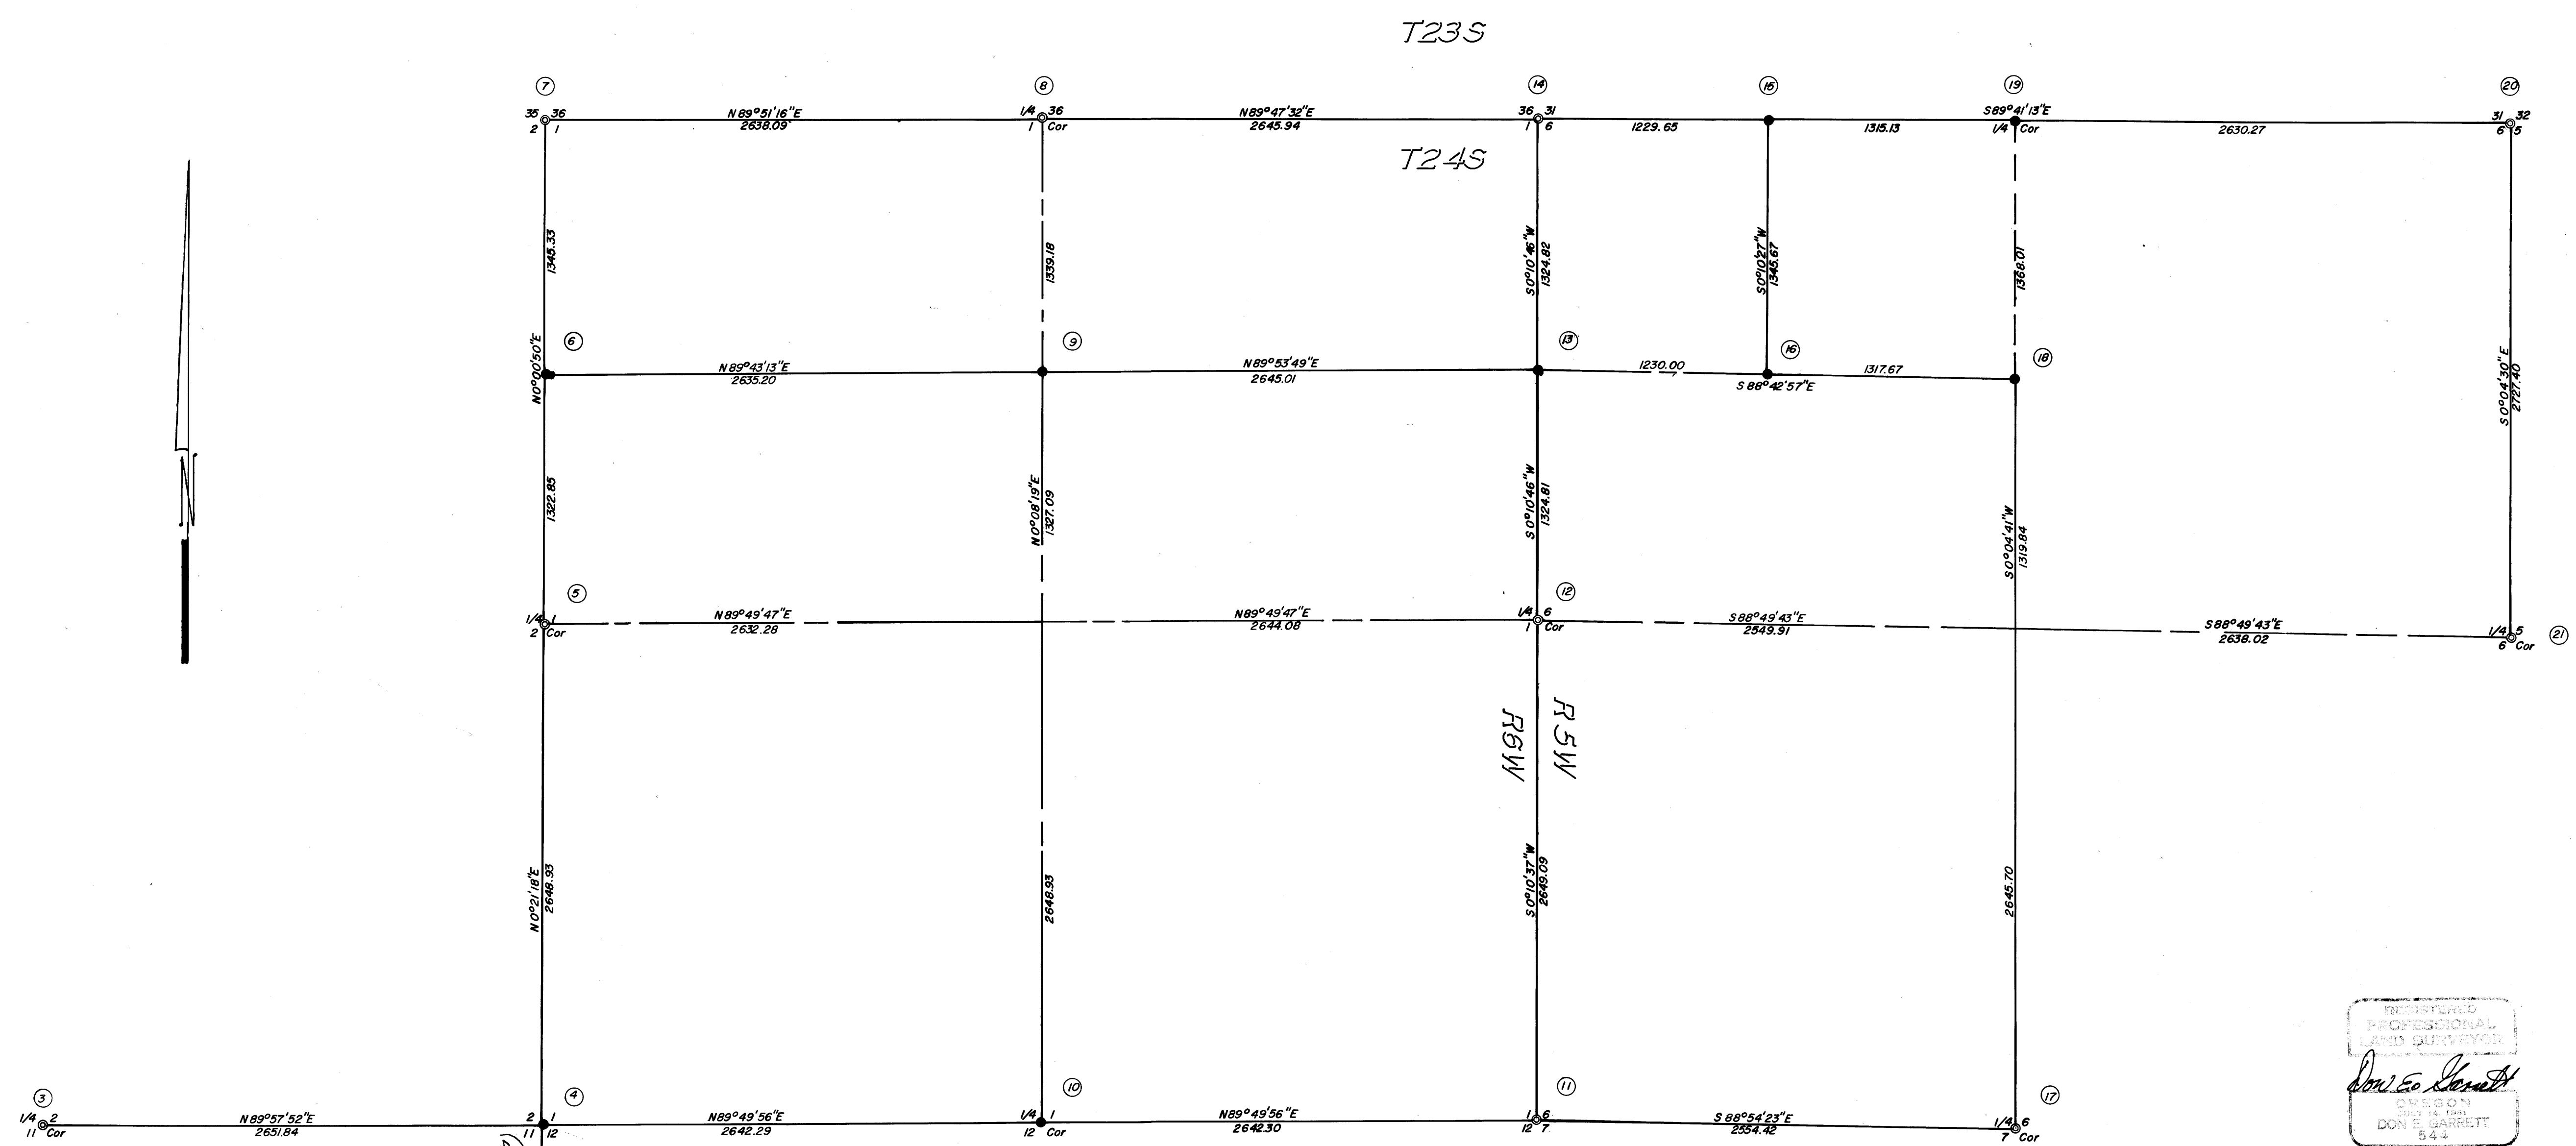

REGISTERED
PROFESSIONAL
LAND SURVEYOR
Don E. Garrett
544

(SEE BLM
RESURVEY)

(SEE BLM
RESURVEY)

- 1. Fd. brass cap marked: C.S. Office 1970 T24S R6W
45" Fir bears S 56° 11' 12.15" Scar
8" W. Oak bears N 20° 0' W 28.4' Scribble
12" Fir bears N 80° 52' E 22.8' Scar
23" W. Oak bears S 80° 30' E 33.3' Scar
15" W. Oak bears S 8° E 25.0' Scribble
- 2. Set brass cap marked: 1/4 S11, S12 T24S R6W
13" Fir bears N 41° 20' E RPLS 544 1973
Scribble 1/4 S12 BT
8" Fir bears N 74° W 79.3'
Scribble 1/4 S11 BT
- 3. Fd. 4" x 4" x 36" Yew wood post marked: 1/4 S2, 1/4 S11
32" Fir bears S 67° 30' W 17.2' Bark Scribble
16" Cedar bears N 40° E 9.0' Scribble
- 4. Set brass cap marked: S1, 2, 11, 12 T24S R6W
RPLS 544 1973
16" W. Oak bears S 80° E 41.1'
Scribble S12 T24S R6W BT
7" W. Oak bears N 30° E 25.1'
Scribble S1 T24S R6W BT
6" W. Oak bears N 34° W 22.7'
Scribble S2 T24S R6W BT
6" W. Oak bears S 21° W 19.8'
Scribble S1 T24S R6W BT
- 5. Fd. 1" Rod
33" Fir bears N 35° W 31.7'
24" " " N 3° W 41.8' Bark Scribble
24" " " S 68° 30' E 94.0' Scar S11
- 6. Set brass cap marked: N 1/16 S1, 2 T24S R6W
RPLS 544 1973
8" Fir bears S 36° E 2.3'
Scribble N 1/16 S1 BT
9" Fir bears N 88° W 28.7'
Scribble N 1/16 S2 BT
- 7. Fd. brass cap marked: USGLO S35, 36 T23S R6W
27" Fir bears N 62° 30' E 64.1' Scribble
26" " " S 43° 30' E 17.2' Scribble
30" " " S 33° 30' W 21.1' now stump
33" " " N 23° W 48.8' Scribble
- 8. Fd. brass cap marked: USGLO S36 T23S R6W
46" Fir bears S 10° E 147 (1/6 down)
N 76° W 32.8' Scar
- 9. Set brass cap marked: CN 1/16 S1 T24S R6W
RPLS 544 1973
10" Fir Bears S 12° W 19.6'
Scribble CN 1/16 S1 BT
15" Fir Bears S 33 1/2° E 50.1'
Scribble CN 1/16 S1 BT
- 10. Set brass cap marked 1/4 S1 S12
T24S R6W RPLS 544 1973
8" W. Oak Bears N 17° E 18.4'
Scribble 1/4 S1 BT
5" Fir Bears S 17 1/2° W 18.7'
Scribble 1/4 S12 BT
- 11. Found brass cap marked S1 S12 T24S
R6W S6 S7 R5W RS 705 1969
16" Fir Bears S 88 1/2° E 25.2' (Scar)
9" " " S 40 1/2° W 15.0' "
12" " " N 39° W 27.0' "
10" " " N 50° E 12.7' "
- 12. Found brass cap marked S1 T24S
R6W S6 R5W RS 705
10" Fir Bears N 84° W 30.6' (Scar)
14" Maple Bears S 66 1/2° E 49.7' (Scribble)
- 13. Set brass cap marked S1 T24S R6W
S6 T24S R6W N 1/16 RPLS 544 1973
9" Fir Bears N 67° W 12.8'
Scribble N 1/16 S1 T24S R6W BT
10" Fir Bears N 86° E 28.9'
Scribble N 1/16 S6 T24S R5W BT
- 14. Found brass cap marked USGLO
S36 T23S R6W S1 T24S R6W
S31 T23S R5W S6 T24S R5W
- 15. Set brass cap marked W 1/16 S31
T23S R5W S6 T24S R5W RPLS 544 1973
10" W. Oak Bears N 28° W 44.6'
Scribble W 1/16 S31 T23S R5W BT
6" Fir Bears S 56° E 29.1'
Scribble S6 T24S R5W BT
- 16. Set brass cap marked NW 1/16 S6
T24S R5W RPLS 544 1973
8" B. Oak Bears N 50 1/2° W 74.5'
Scribble NW 1/16 S6 BT
13" B. Oak Bears S 46° W 79.8'
Scribble NW 1/16 S6 BT
- 17. Found Brass Cap marked 1/4 S6 S7
T24S R5W RS 705 1969
21" Oak Bears S 41 1/2° E 47.5' (Scar)
13" Fir Bears N 16° W 41.9'
- 18. Set brass cap marked CN 1/16 S6
T24S R5W RPLS 544 1973
6" B. Oak Bears S 77° W 17.5'
Scribble CN 1/16 S6 BT
5" Fir Bears N 33 1/2° W 25.6'
Scribble CN 1/16 S6 BT
- 19. Set brass cap marked 1/4 S 31 T23S R5W
S6 T24S R5W RPLS 544 1973
8" Fir Bears N 26° W 15.4'
Scribble 1/4 S31 T23S R5W BT
16" Fir Bears S 20° E 40.7'
Scribble 1/4 S6 T24S R5W BT
- 20. Fd. brass cap marked S31 S32 T23S R5W
S5 S6 T24S R6W
8" W. Oak Bears S 63° 30' E 45.1' Scar
10" B. Oak " S 87° W 39.5' "
15" Fir " N 53° 30' W 23.4' "
11" " " N 48° E 17.6' "
- 21. Fd. brass cap marked 1/4 S5 S6 T24S R5W
C.S. Office 1959
7" Fir Bears S 17° E 52.0' Scar
9" W. Oak Bears S 25° W 74.5' "