

Fd. brass cap mkd.  
County Surveyor's Office  
T29 S, R2 W, S25, S36  
R1 W, 1969  
From which a:  
16" Douglas fir BT  
Now down  
Bears S 51 1/2° W, 13.9 ft.  
10" Douglas fir BT  
Bears N 61 3/4° W, 31.7 ft.  
(Record N17° W)

Fd. brass cap mkd.  
County Surveyor's Office  
T29 S, R1 W, S30, S31 1969  
From which a:

39" Douglas fir BT  
Bears N 60° E, 50.8 ft.  
40" Douglas fir BT  
Scribes "BT" vis.  
Bears S 3° E, 65.3 ft.  
8" Douglas fir BT  
Scribes vis.  
Bears N 67° E, 13.5 ft.  
12" Douglas fir BT  
Scribes vis.  
Bears S 36° E, 15.1 ft.

Fd. brass cap mkd.  
County Surveyor's Office  
T29 S, R1 W  
S30, S29, S31, S32 1969  
From which a:

6" madrone BT  
Down on face  
Bears N 8° E, 24.4 ft.  
17" cedar BT  
Scribes vis.  
Bears N 44° E, 46.4 ft.  
12" original madrone BT  
Scribes vis.  
Bears S 81° E, 18.5 ft.  
10" Douglas fir BT  
Scribes vis.  
Bears S 65° E, 9.6 ft.  
12" original madrone BT  
Scribes vis.  
Bears S 51° W, 20.5 ft.  
18" original Douglas fir BT  
Bears N 21° W, 17.2 ft.

Fd. brass cap mkd.  
U. S. Department of the Interior  
N1/16 S31 1971  
Bur. of Land Management  
From which a:

8" Douglas fir BT  
Scribes vis.  
Bears N 21° E, 7.3 ft.  
8" Douglas fir BT  
Scribes vis.  
Bears S 78° E, 7.9 ft.

Fd. brass cap mkd.  
U. S. General Land Office Survey  
1/4 S36 1917  
From which a:

18" Douglas fir BT  
Bears N 24 1/2° W, 52.1 ft.  
48" pine BT, now snag  
Rotted, partial scribe vis.  
Bears S 88 1/2° W, 40.3 ft.  
8" Douglas fir BT  
Scribes vis.  
Bears S 75° W, 7.2 ft.

Fd. brass cap mkd.  
U. S. General Land Office Survey  
T29 S, R2 W, S36, R1 W, S31  
T30 S, R2 W, S1, R1 W, S6 1917  
From which a:

24" original oak BT  
Bears N 8° E, 47.5 ft.  
20" original oak BT, stump  
Bears S 89° E, 118.8 ft.  
28" original oak BT  
Bears N 70° W, 37.0 ft.  
15" oak BT, record, fir  
Scribes vis.  
Bears N 73° E, 17.5 ft.  
18" Douglas fir BT  
Scribes vis.  
Bears S 9° E, 13.0 ft.  
10" Douglas fir BT  
Scribes vis.  
Bears S 41° W, 33.0 ft.  
16" Douglas fir BT  
Scribes vis.  
Bears N 44° W, 26.8 ft.

Fd. brass cap mkd.  
U. S. Dept. of the Interior  
W1/16 S31, S6 1971  
U. S. Bur. of Land Management  
From which a:  
10" yew BT  
Scribes vis.  
Bears N17 1/2° E, 21.5 ft.  
12" white fir BT  
Scribes vis.  
Bears N 68° W, 65.5 ft.

Fd. brass cap mkd.  
T29 S, R1 W, 1/4 S31  
T30 S, R1 W, 1/4 S6  
Cadastral Survey 1971  
RLS 222 1970  
From which a:  
30" original Douglas fir BT, stump  
Bears N 70° W, 21.8 ft.  
30" original Douglas fir BT, stump  
Bears S 88° E, 31.8 ft.  
12" white fir BT  
Bears N 4° E, 17.4 ft.  
14" alder BT  
Scribes vis.  
Bears S 66° E, 7.2 ft.  
21" sugar pine BT  
Bears S15° W, 8.7 ft.  
14" Douglas fir BT  
Bears N 75° W, 18.6 ft.  
Fd. 1" iron rod laying  
alongside brass cap.

Fd. brass cap mkd.  
U. S. Department of the Interior  
E1/16 S31, S6  
Cadastral Survey 1971  
Bureau of Land Management  
From which a:  
10" white fir BT  
Scribes vis.  
Bears N 7° E, 19.7 ft.  
10" white fir BT  
Scribes vis.  
Bears S 9 1/2° E, 24.9 ft.

Fd. brass cap mkd.  
T29 S, R1 W  
1/4 S31, S32  
RLS 222 1970  
From which a:

14" original madrone BT  
Down, partial scribing vis.  
Bears S 78° E, 11.2 ft.  
9" Douglas fir BT  
Scribes vis.  
Bears N 83 1/4° E, 50.5 ft.  
9" madrone BT  
Scribing vis.  
Bears N 87° W, 40.2 ft.  
Fd. 18" x 12" x 18" basalt stone  
with 1/4" on West face, beside  
brass cap.

Set brass cap mkd.  
T29 S, R1 W, W M  
S1/16 S31, S32  
1973 RS 430  
From which a:

8" Douglas fir, I scribed  
"S1/16 S32 BT"  
Bears N 63° E, 31.0 ft.  
10" pine, I scribed  
"S1/16 S31 BT"  
Bears N19° W, 14.8 ft.  
Brass disc mkd. RS 430  
attached to both trees

Fd. brass cap mkd.  
T29 S, R1 W, S31, S32,  
T30 S, R1 W, S6, S5  
RLS 222 1970  
From which a:


30" original madrone BT  
Blown down  
Bears N 88° E, 32.9 ft.  
22" original white fir BT  
Blown down  
Bears S 38° E, 32.9 ft.  
24" original Douglas fir BT, stump  
Bears N 61° W, 25.1 ft.  
12" white fir BT  
Scribes vis.  
Bears S11° W, 18.9 ft.  
10" black oak BT  
Scribes vis.  
Bears N 85° W, 9.6 ft.  
I scribed a 6" Douglas fir  
"T29 S, R1 W, S32 BT"  
Bears N12 1/2° E, 45.8 ft.  
I nailed a brass washer to lower face  
of  
Fd. 15" x 12" x 6" original stone and  
1/4" x 27" iron bolt alongside  
brass cap.

I, Bruce A. Shaner, a registered land  
surveyor in the State of Oregon, hereby certify  
that this plat and the notes hereon, or attached,  
are a correct representation of a survey I  
performed during July - October, 1973, for  
the U. S. Forest Service, in accordance with  
the statutes of the State of Oregon and with  
the Articles of my contract.

B A Shaner  
Bruce A. Shaner  
Registered Land Surveyor  
Oregon Licence 430

PROPERTY LINE SURVEY IN  
SECTION 31, T.29 S., R. 1 W., W. M.  
For: Umpqua National Forest  
Tiller Ranger District

By: Shaner Engineering, Roseburg, Oregon  
Contract No. 004128N October 23, 1973

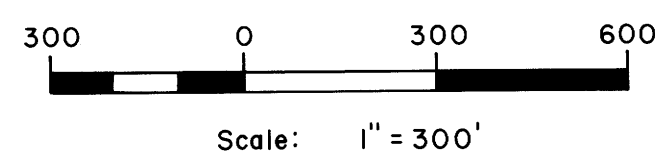

Bearings based on  
solar observation.  
Mean magnetic declination 20° E.

LEGEND

- Corner found
- Corner set
- Corner computed, not set
- True line, marked with steel fence posts and boundary signs
- Random line only, no true line marked
- Line computed, not run
- Stream
- Rocked road
- Dirt road

REGISTERED  
PROFESSIONAL  
LAND SURVEYOR

B A Shaner

OREGON  
OCT 4 1973  
BRUCE A. SHANER  
230