

SURVEY TO SET PROPERTY CORNERS IN SECTIONS 22 & 23, T.27S. R.5W.W.M.

FOR: M. J. BULLOCK
BY: BAUGHMAN SURVEYING SERVICE


JULY 1974

SCALE: 1"=200'

53
2

M 49-68

M 49-68

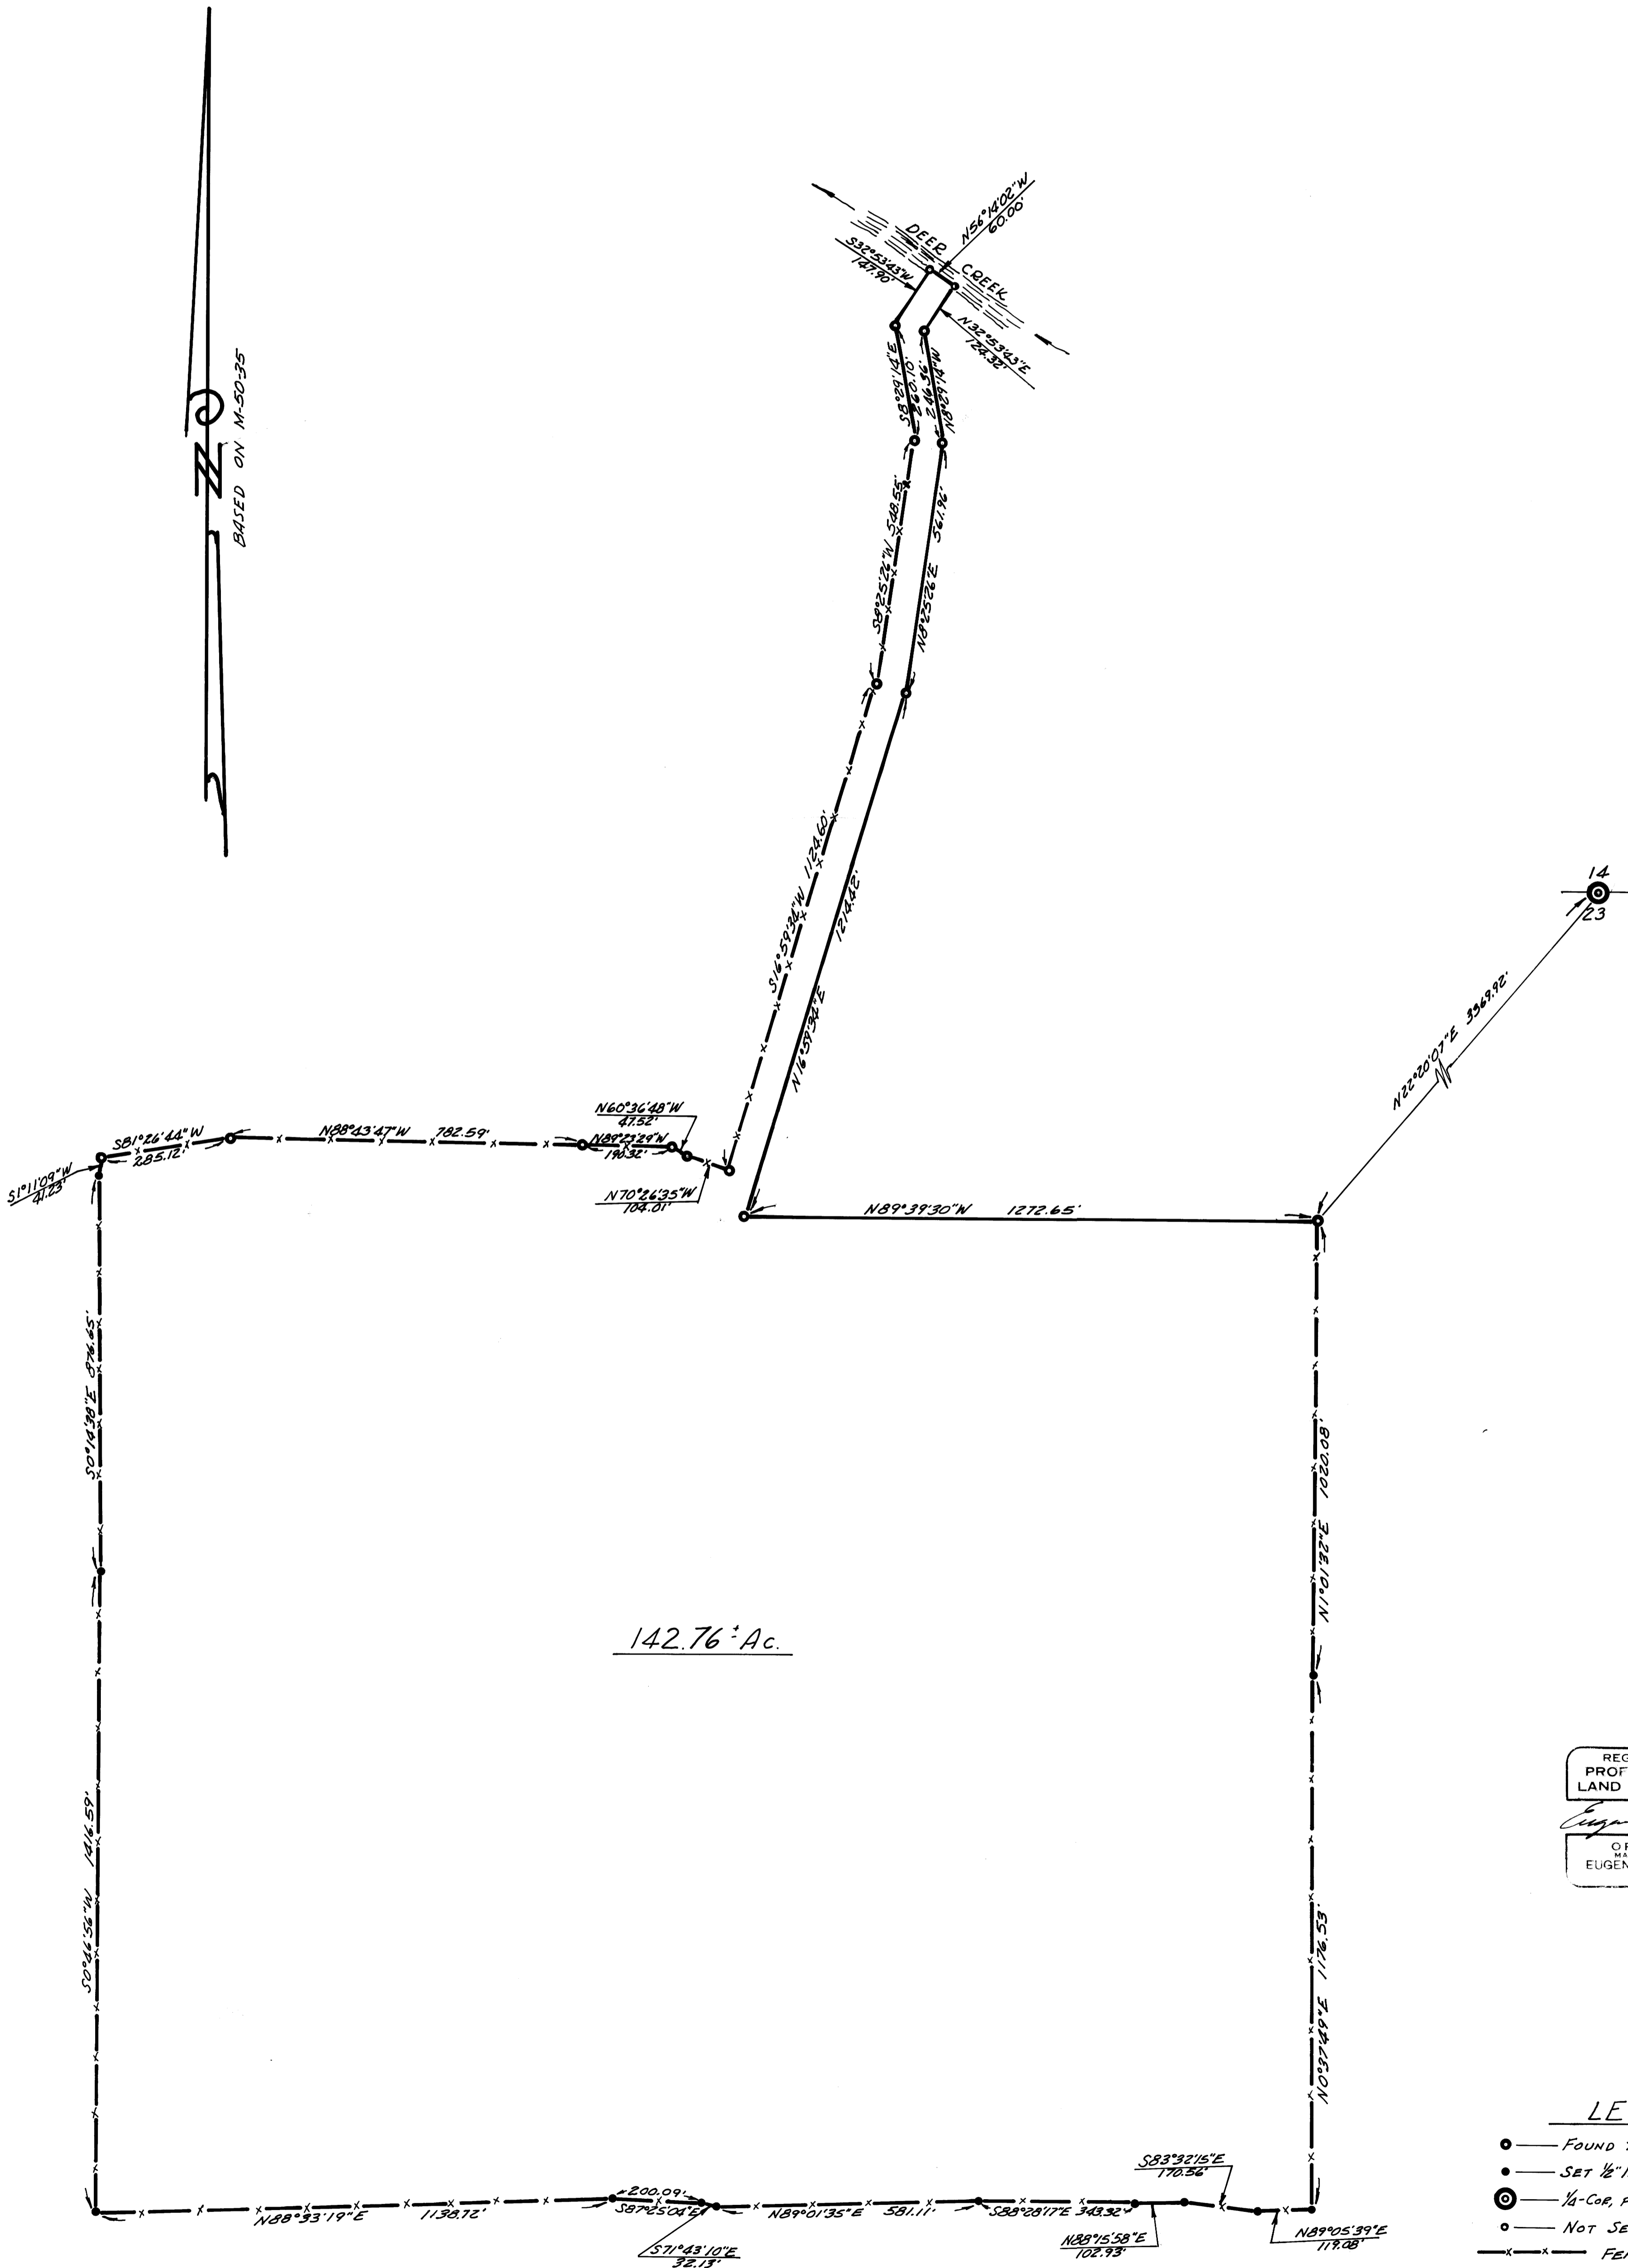

REGISTERED
PROFESSIONAL
LAND SURVEYOR

Eugene A. Sloom

OREGON
MAY 13, 1966
EUGENE A. SLOOM
492

- LEGEND**
- FOUND 3/4" IRON ROD, PER M-50-35, M-51-77
 - SET 1/2" IRON ROD
 - ⊙ 1/4-COR, PER M-38-58
 - NOT SET
 - x-x- FENCE LINE

M 49 - 68

89-64 W