
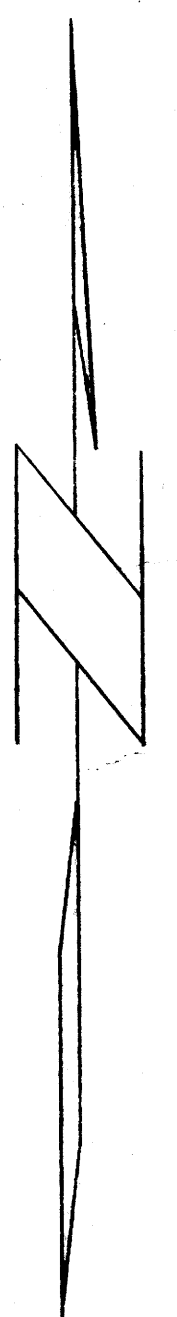


COUNTY SURVEYOR
DO NOT REMOVE FROM OFFICE

FILED *See*
RECEIVED
AUG 12 1974
COUNTY SURVEYOR
DOUGLAS COUNTY, ORE
MR

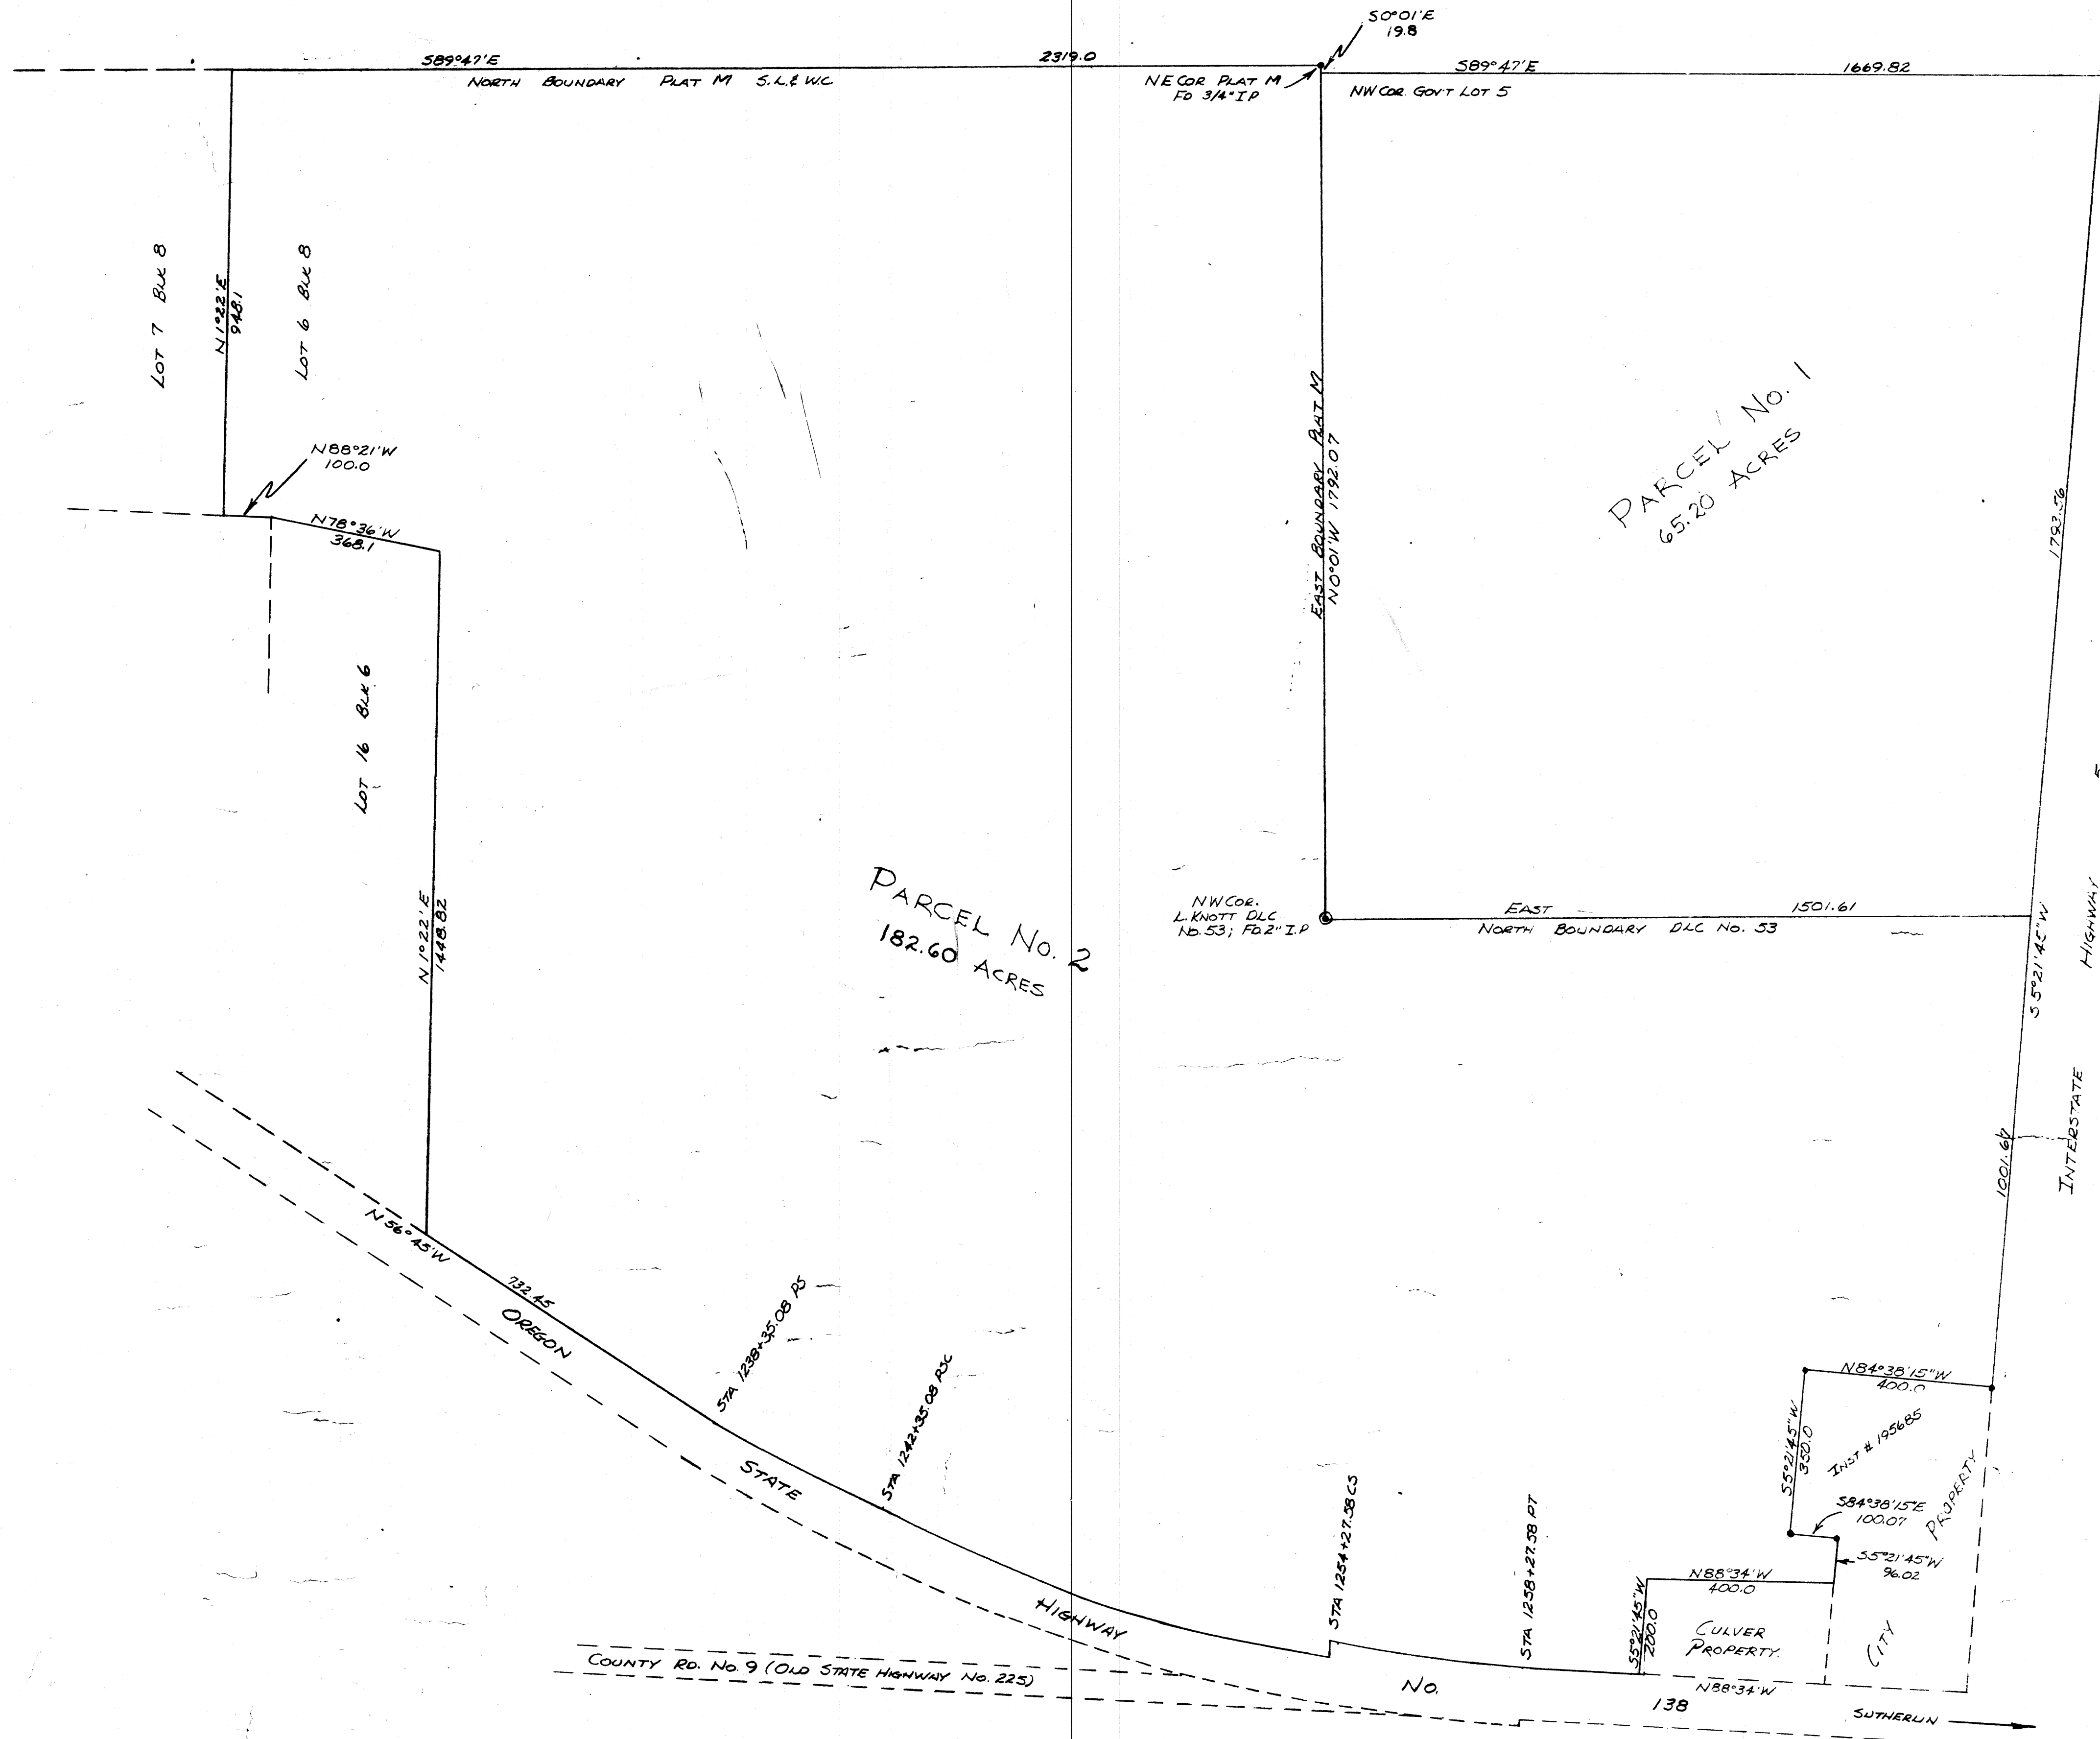


SUTHERLIN KNOLLS GOLF & RECREATION

SUTHERLIN, OREGON
PARCEL IN PARTS OF SECS. 13 & 24, T25S, R6W, W.M., & SECS 18 & 19,
T25S, R5W, W.M., DOUGLAS COUNTY, ORE.

SCALE: 1" = 200'

ENGINEERING SERVICE - MYRTLE CREEK, OREGON

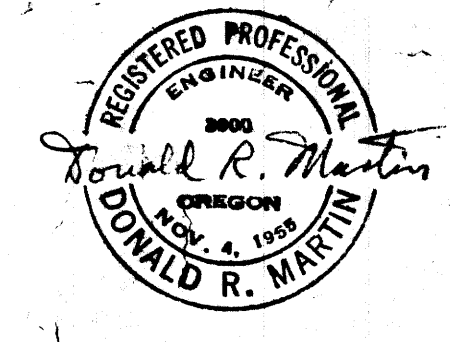

COUNTY SURVEYORS FILE DATA
DO NOT REMOVE FROM OFFICE