

COUNTY SURVEYORS FILE DATA  
DO NOT REMOVE FROM OFFICE

# SURVEY FOR PROPERTY CORNERS IN BLK'S 14 & 15, CITY OF CANYONVILLE SEC. 34, T.30S., R.5W., W.M. FOR ROBERT HARRINGTON BY BAUGHMAN SURVEYING SERVICE

JULY 1973


SCALE 1" = 20'

FILED  
RECEIVED  
JUL 30 1973

COUNTY SURVEYOR  
DOUGLAS COUNTY, ORE.


REGISTERED  
PROFESSIONAL  
LAND SURVEYOR

OREGON  
MAY 12, 1960  
EUGENE A. BLOOM  
492

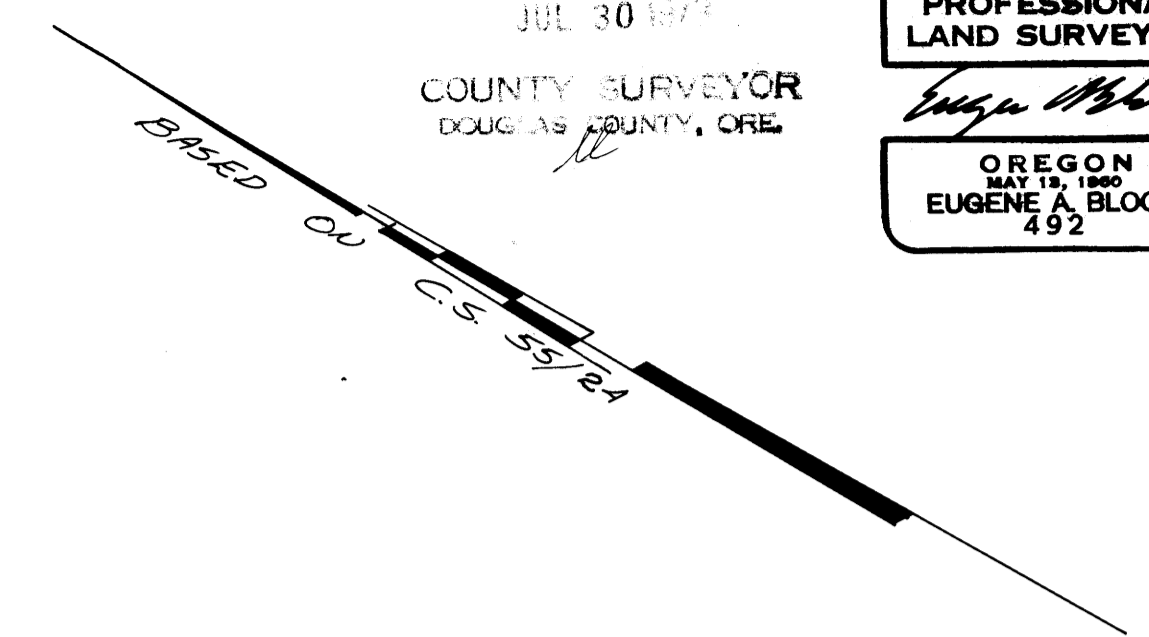

LEGEND:

- SET 5/8" I.P.
- FD. 5/8" I.P.
- FD. 3/4" I.P.
- FD. 1/2" I.P. No RECORD
- FD. 2" I.P.
- FD. "X" IN CONCRETE

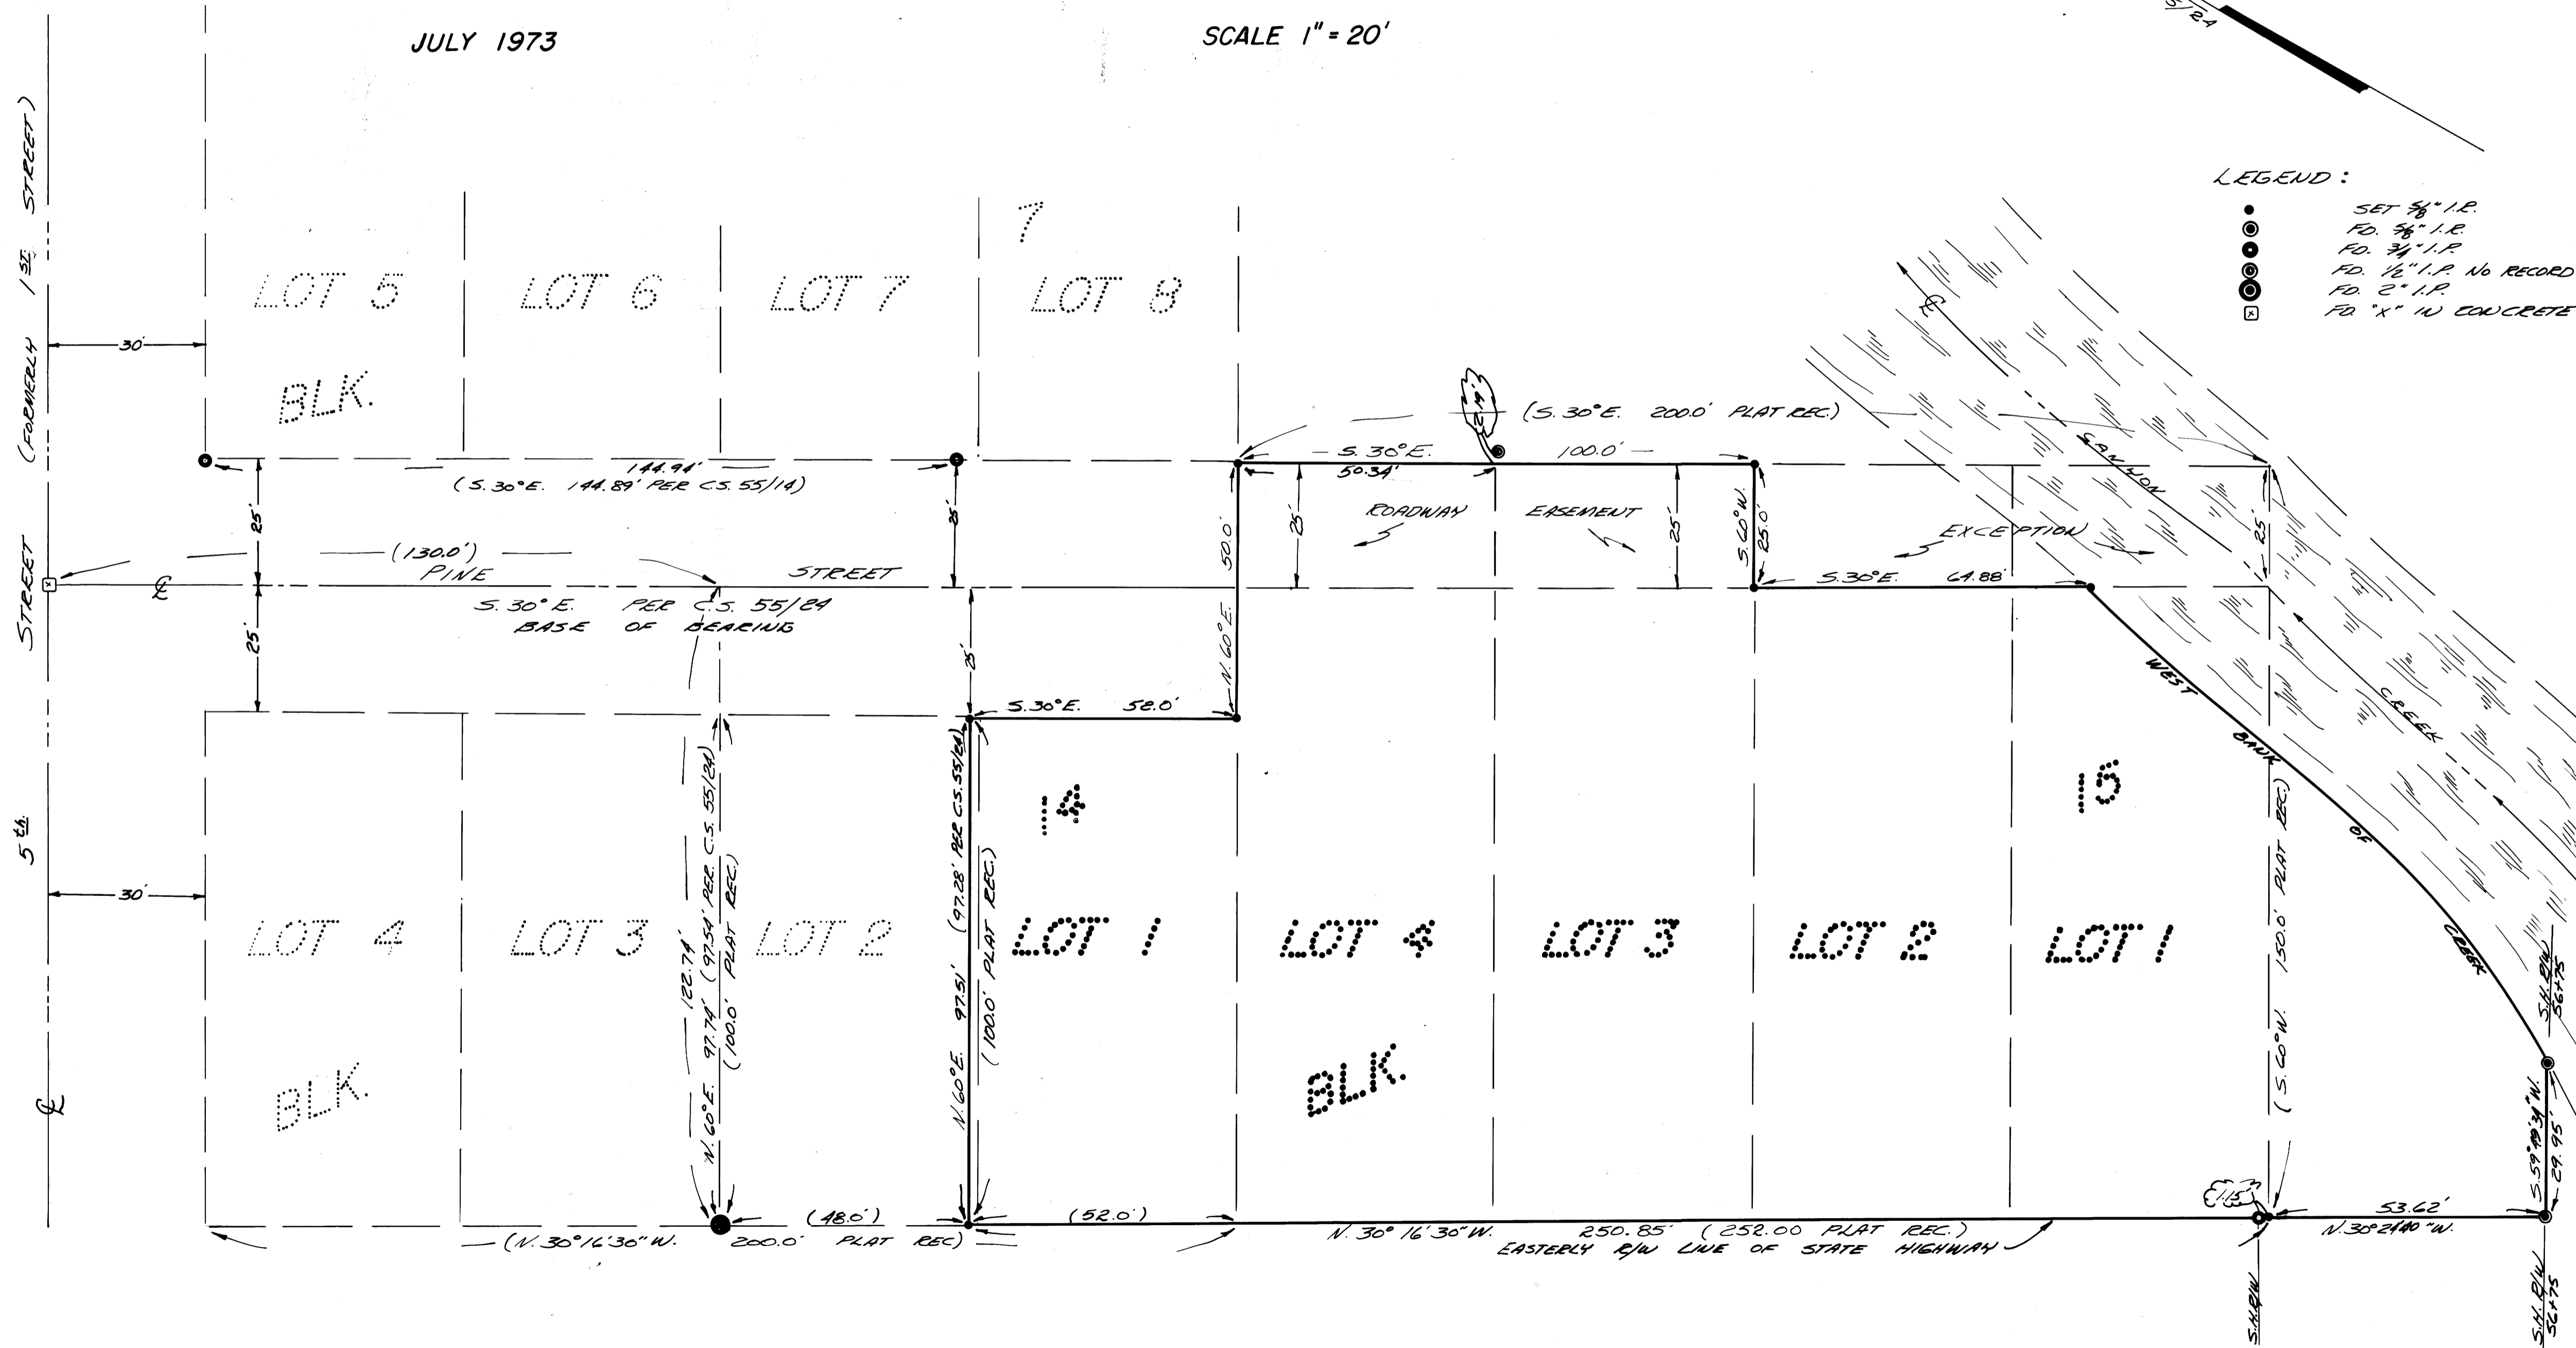

MAP FILE M 50 - 36